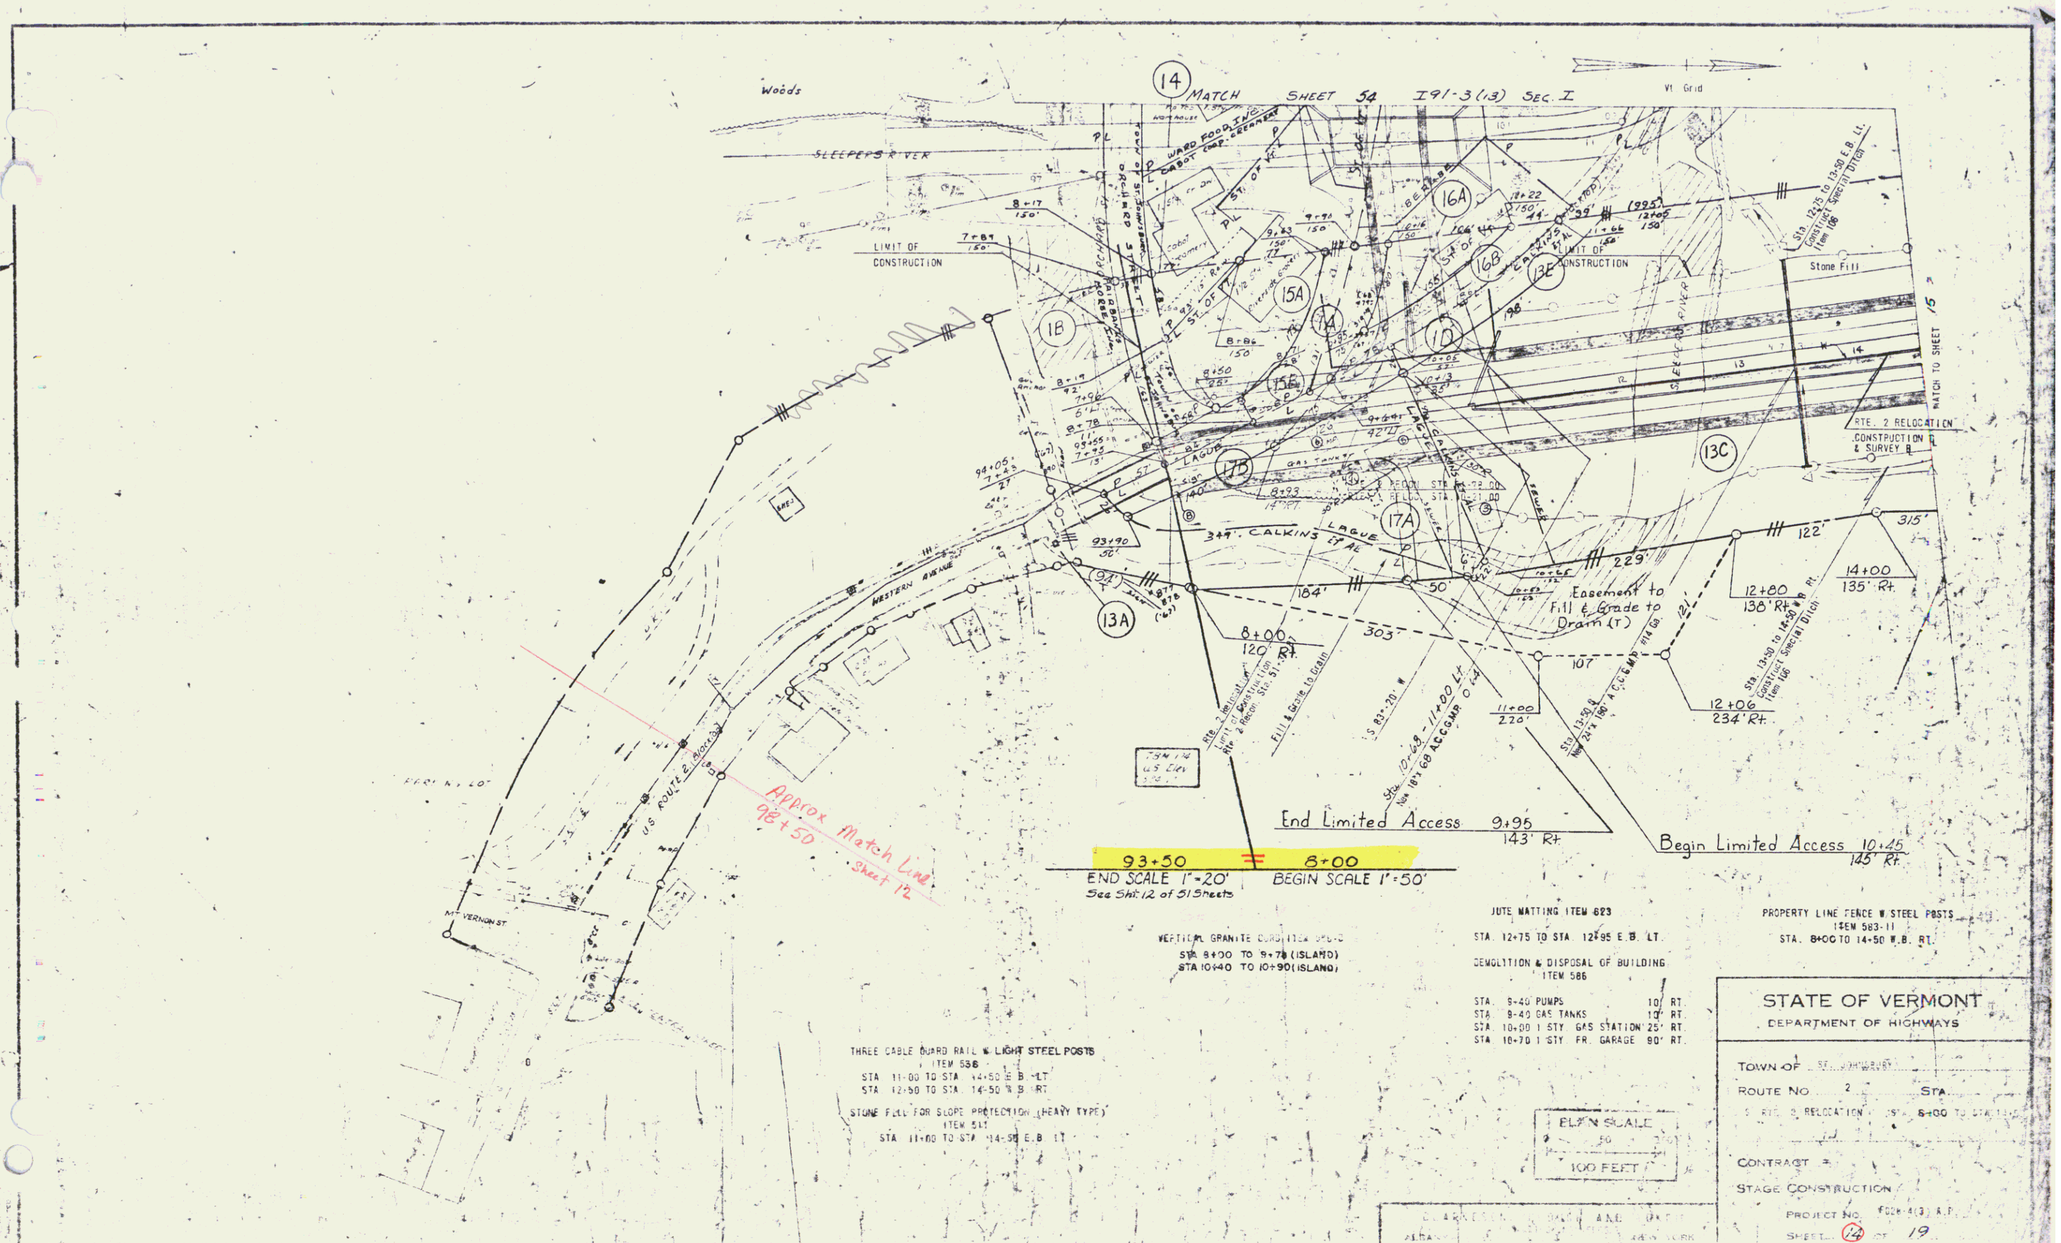

POOR ORIGINAL COPY

11