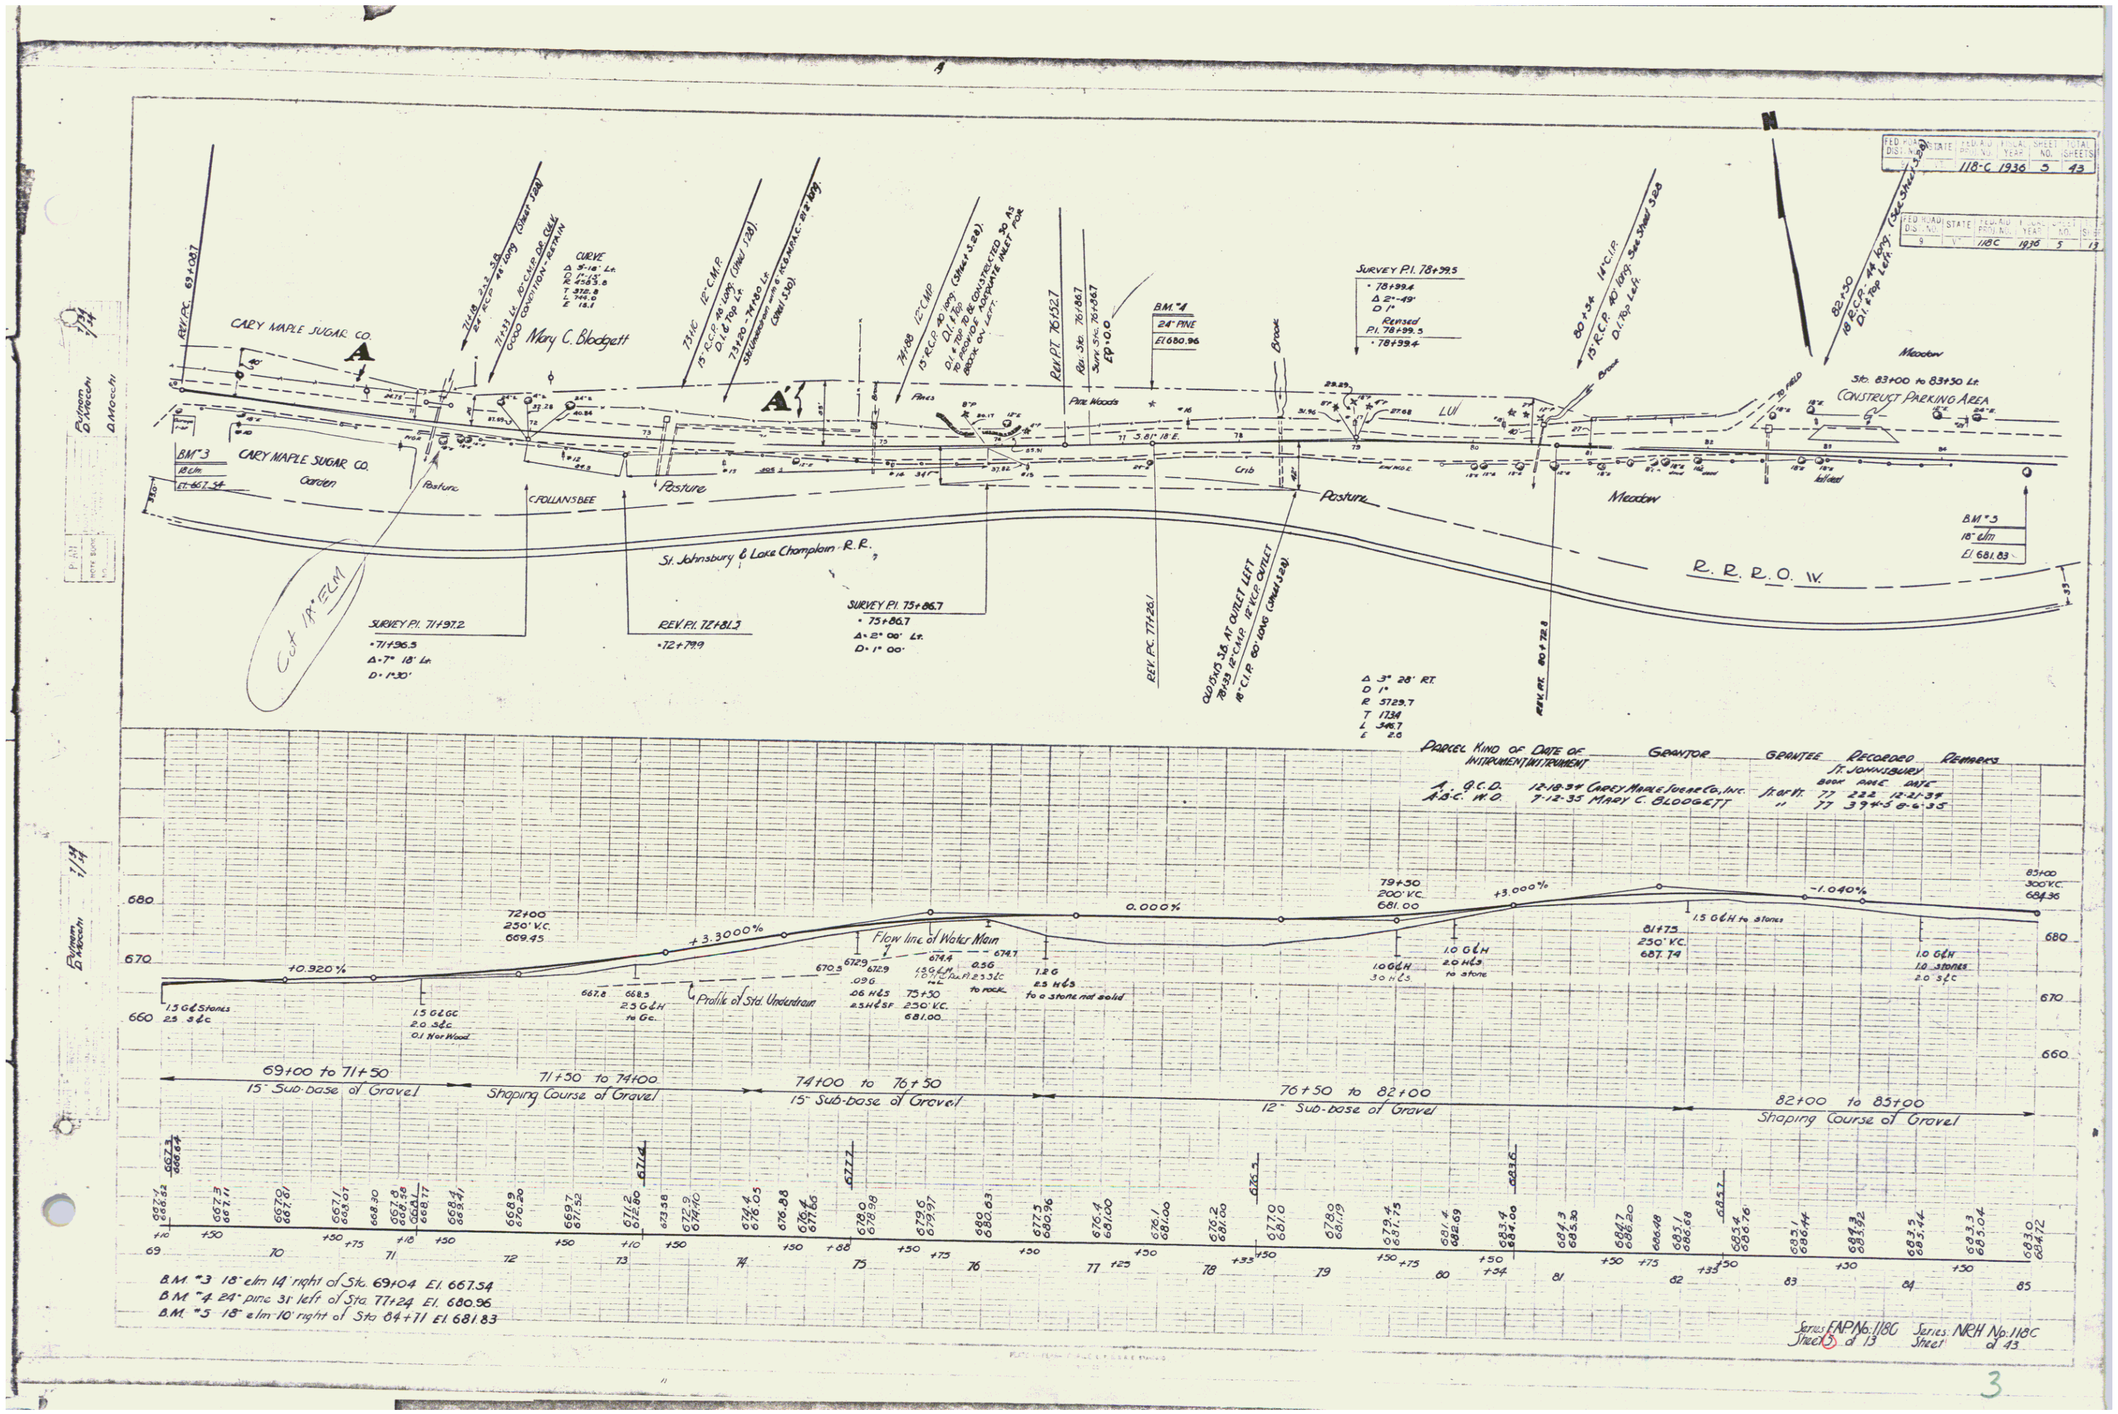
FED. ROAD DIST. NO. | STATE | FED. AID PROJ. NO. | FISCAL YEAR | SHEET NO. | TOTAL SHEETS
118-C 1936 5 43
CARY MAPLE SUGAR CO.
Garden
Pasture
C. FOLLANSBEE
Mary C. Blodgett
St. Johnsbury & Lake Champlain R.R.
R. R. R. O. W.
Meadow
Crib
Pine Woods
Brook
Sta. 83+00 to 83+30 Lt.
CONSTRUCT PARKING AREA
BM #3
18" Elm
El. 667.54
BM #4
24" PINE
El. 680.96
BM #5
18" Elm
El. 681.83
Cut 18" ELM
SURVEY P.I. 71+97.2
SURVEY P.I. 75+86.7
REV. P.I. 72+81.3
REV. P.C. 77+28.1
REV. P.T. 76+52.7
SURVEY P.I. 78+99.5
Revised P.I. 78+99.5
Parcel Kind of Instrument Date of Instrument Grantor Grantee St. Johnsbury Book Page Date Recorded Remarks
A. Q.C.D. 12-18-34 Carey Maple Sugar Co., Inc. St. Ry. 77 222 12-21-34
A.B.C. W.D. 7-12-35 Mary C. Blodgett " 77 394-5 8-6-35
Flow line of Water Main
Profile of Std. Underdrain
69+00 to 71+50 15" Sub-base of Gravel
71+50 to 74+00 Shaping Course of Gravel
74+00 to 76+50 15" Sub-base of Gravel
76+50 to 82+00 12" Sub-base of Gravel
82+00 to 85+00 Shaping Course of Gravel
B.M. #3 18" elm 14' right of Sta. 69+04 El. 667.54
B.M. #4 24" pine 31' left of Sta. 77+24 El. 680.96
B.M. #5 18" elm 10' right of Sta. 84+71 El. 681.83
Series: FAP No. 118C Sheet 5 of 13
Series: NRH No. 118C Sheet of 43

3