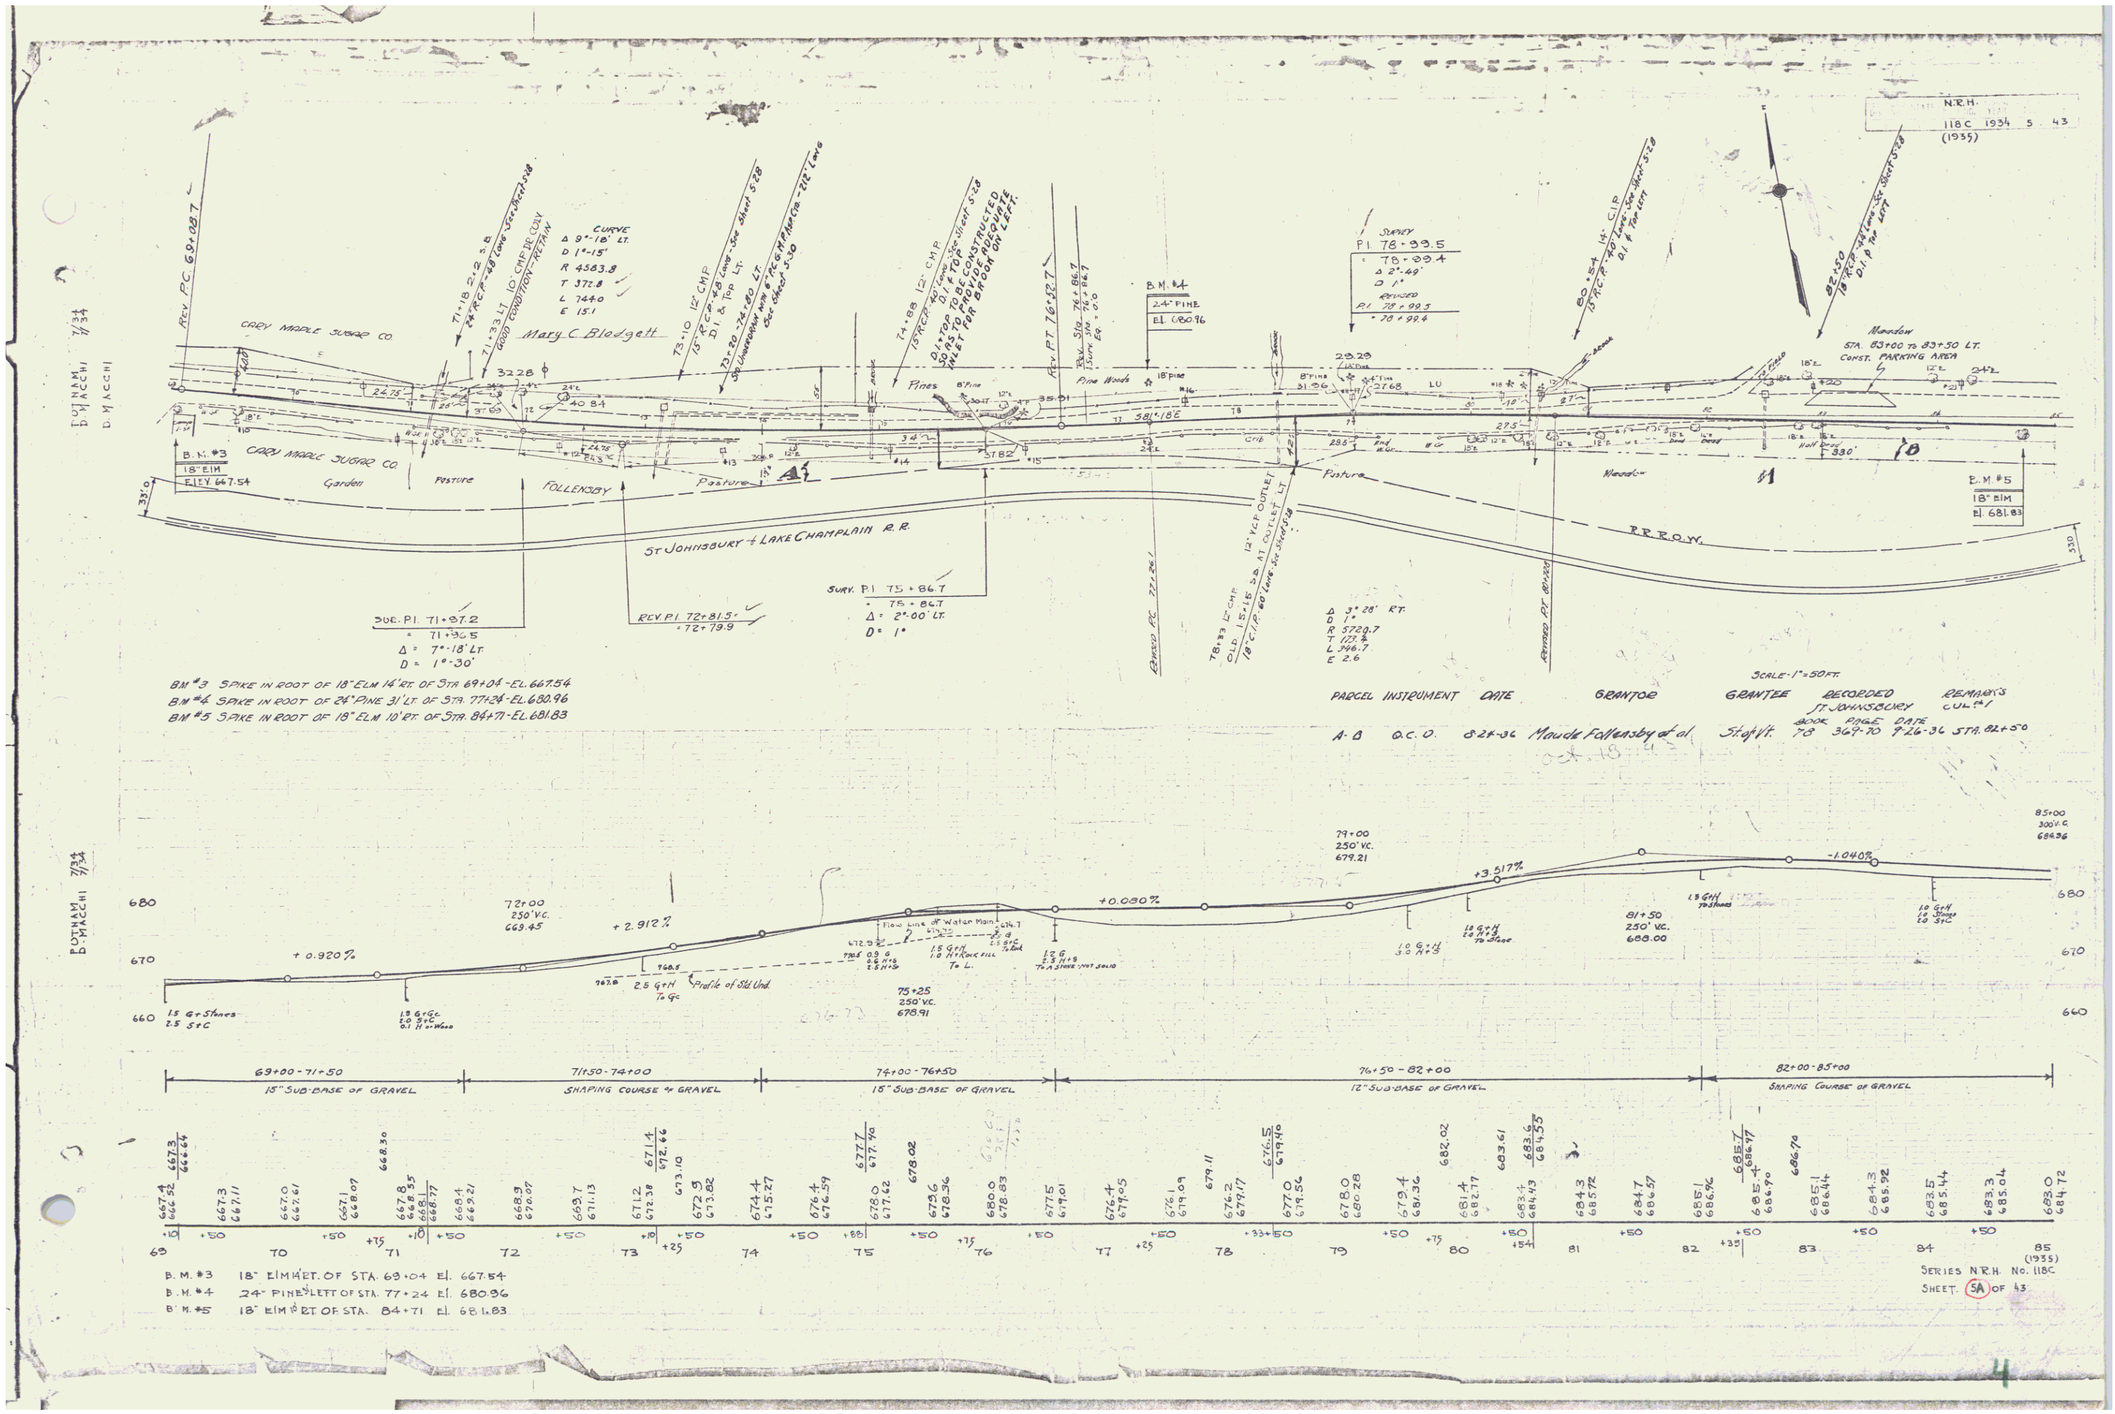
N.R.H.
118C 1934 S. 43
(1935)
CARY MAPLE SUGAR CO.
Mary C. Bledgett
CURVE
Δ 9°-18' LT.
D 1°-15'
R 4583.8
T 372.8
L 744.0
E 15.1
B.M. #3
18" ELM
El. 667.54
Garden
Pasture
FOLLENSBY
ST JOHNSBURY & LAKE CHAMPLAIN R.R.
B.M. #4
24" PINE
El. 680.96
Pines
Pine Woods
Meadow
STA. 83+00 to 83+50 LT.
CONST. PARKING AREA
B.M. #5
18" ELM
El. 681.83
R.R. R.O.W.
SURV. P.I. 71+37.2
= 71+36.5
Δ = 7°-18' LT.
D = 1°-30'
REV. P.I. 72+81.5'
= 72+79.9
SURV. P.I. 75+86.7
= 75+86.7
Δ = 2°-00' LT.
D = 1°
SURVEY
P.I. 78+99.5
= 78+99.4
Δ 2°-49'
D 1°
REVISED
P.I. 78+99.5
= 78+99.4
Δ 3°-28' RT.
D 1°
R 5729.7
T 173.4
L 346.7
E 2.6
SCALE: 1" = 50 FT.
PARCEL INSTRUMENT DATE GRANTOR GRANTEE RECORDED ST. JOHNSBURY BOOK PAGE DATE REMARKS CONT.
A-B Q.C.D. 8-24-36 Maude Follensby et al Staff ft. 73 367-70 9-26-36 STA. 82+50
BM #3 SPIKE IN ROOT OF 18" ELM 14' RT. OF STA. 69+04 - EL. 667.54
BM #4 SPIKE IN ROOT OF 24" PINE 31' LT. OF STA. 77+28 - EL. 680.96
BM #5 SPIKE IN ROOT OF 18" ELM 10' RT. OF STA. 84+71 - EL. 681.83
+0.920%
+2.912%
+0.080%
+3.517%
-1.040%
72+00 250' V.C. 669.45
75+25 250' V.C. 678.91
79+00 250' V.C. 679.21
81+50 250' V.C. 680.00
85+00 300' V.C. 684.36
69+00 - 71+50 15" SUB-BASE OF GRAVEL
71+50 - 74+00 SHAPING COURSE & GRAVEL
74+00 - 76+50 15" SUB-BASE OF GRAVEL
76+50 - 82+00 12" SUB-BASE OF GRAVEL
82+00 - 85+00 SHAPING COURSE OF GRAVEL
B.M. #3 18" ELM 14' RT. OF STA. 69+04 El. 667.54
B.M. #4 24" PINE 31' LEFT OF STA. 77+24 El. 680.96
B.M. #5 18" ELM 10' RT. OF STA. 84+71 El. 681.83
SERIES N.R.H. No. 118C
SHEET 5A OF 43