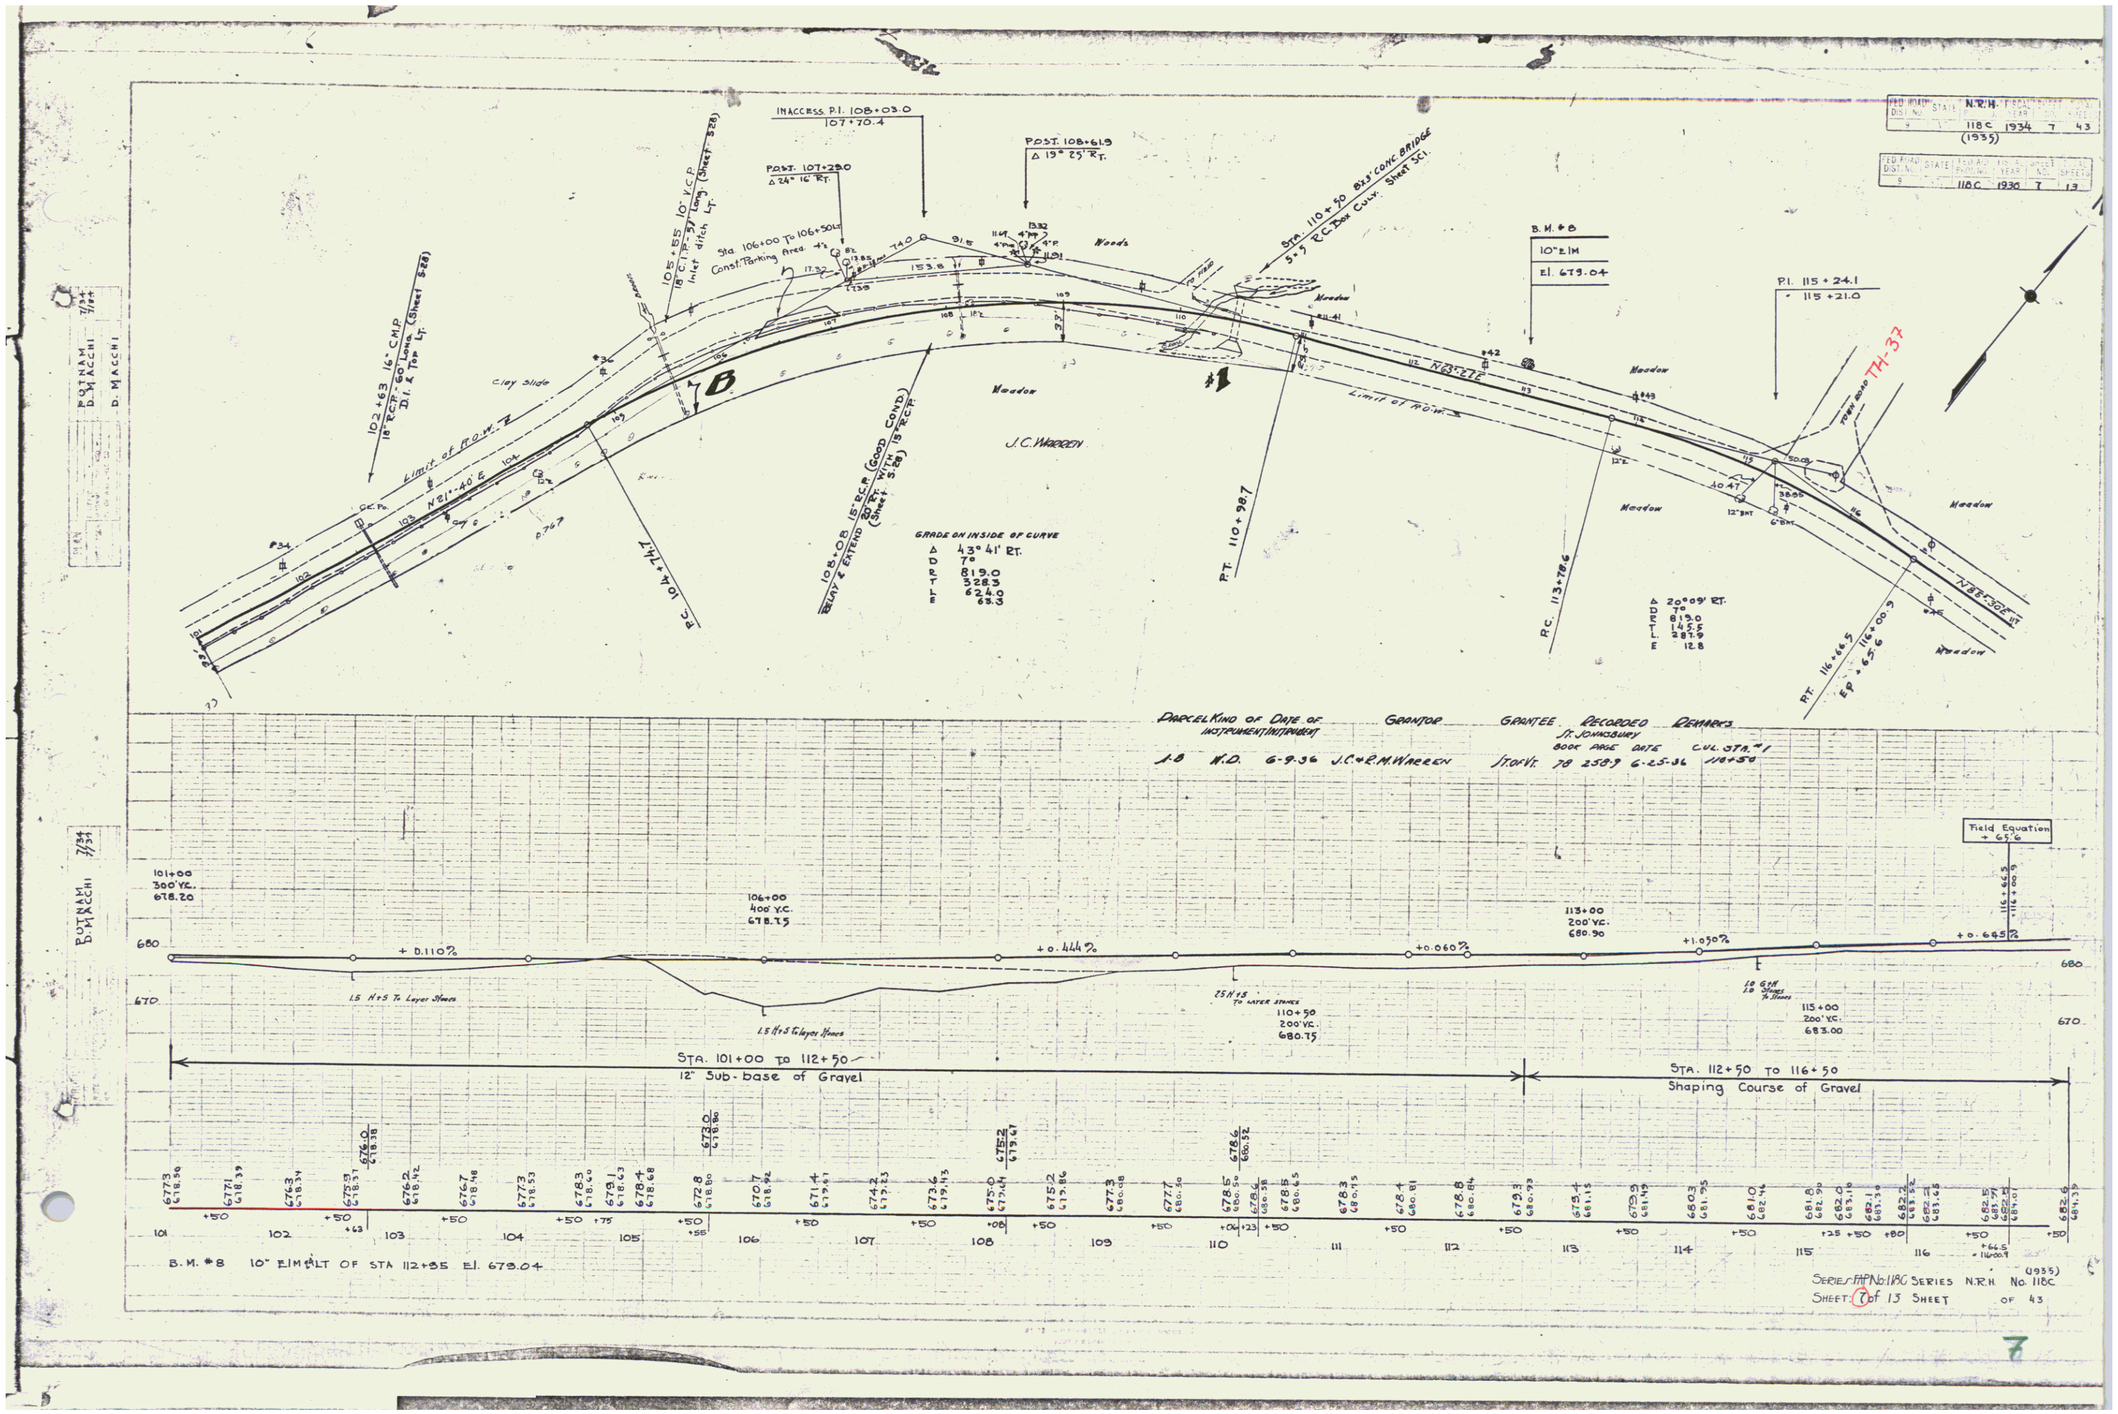
FED. AID PROJ. DIST. NO. STATE N.H. FISCAL YEAR SHEET NO. TOTAL SHEETS
118C 1934 7 43
(1935)
FED. AID PROJ. DIST. NO. STATE FISCAL YEAR SHEET NO. TOTAL SHEETS
118C 1930 7 13
INACCESS. P.I. 108+03.0
107+70.4
P.O.S.T. 107+29.0
Δ 24° 16' Rt.
P.O.S.T. 108+61.9
Δ 19° 25' Rt.
Sta. 106+00 To 106+50 Lt.
Const. Parking Area: 4'±
105+85 10" V.C.P.
18" C.M.P. - 37' Long. (Sheet 5B)
Inlet ditch Lt.
102+63 16" C.M.P.
D.I. & Top Lt.
18" R.C.P. - 60' Long. (Sheet 5B)
Sta. 110+50 8x3' Conc. Bridge
3'x3' R.C. Box Culv. Sheet 5C1.
B.M. #8
10" E.I.M.
El. 678.04
P.I. 115+24.1
115+21.0
Clay Slide
Limit of R.O.W.
N81°-40' E
N81°-30' E
Woods
Meadow
J.C. Warren
Farm Road
TH-37
108+08 15" R.C.P. (Good Cond.)
Relay & Extend 30' W/Tx 18" R.C.P. (Sheet 5B)
P.C. 104+74.7
P.T. 110+98.7
R.C. 113+78.6
P.T. 116+66.5
EP 116+00.9
GRADE ON INSIDE OF CURVE
Δ 43° 41' Rt.
D 7°
R 819.0
T 328.3
L 624.0
E 63.3
Δ 20°09' Rt.
D 7°
R 819.0
T 145.5
L 287.9
E 12.8
PARCEL KIND OF INSTRUMENT DATE OF INSTRUMENT GRANTOR GRANTEE RECORDED BOOK PAGE DATE REMARKS CUL. STA.
J.B. W.D. 6-9-36 J.C.&R.M. Warren J.T.O.V.T. 78 2589 6-25-36 114+50
Field Equation
+ 65.6
101+00
300' V.C.
678.20
106+00
400' V.C.
678.75
113+00
200' V.C.
680.90
110+50
200' V.C.
680.75
115+00
200' V.C.
683.00
+ 0.110%
+ 0.444%
+ 0.060%
+ 1.050%
+ 0.665%
1.5 N+S To Layer Stones
1.5 N+S Gravel Stones
2.5 N+S To Layer Stones
1.0 G+N 1.0 Stones To Stones
680
670
STA. 101+00 TO 112+50
12" Sub-base of Gravel
STA. 112+50 TO 116+50
Shaping Course of Gravel
B.M. #8 10" E.I.M. LT OF STA 112+35 El. 678.04
SERIES-FAP No. 118C SERIES N.F.H. No. 118C (1935)
SHEET: 7 of 13 SHEET OF 43
PUTNAM
D. MACCHI
7/34