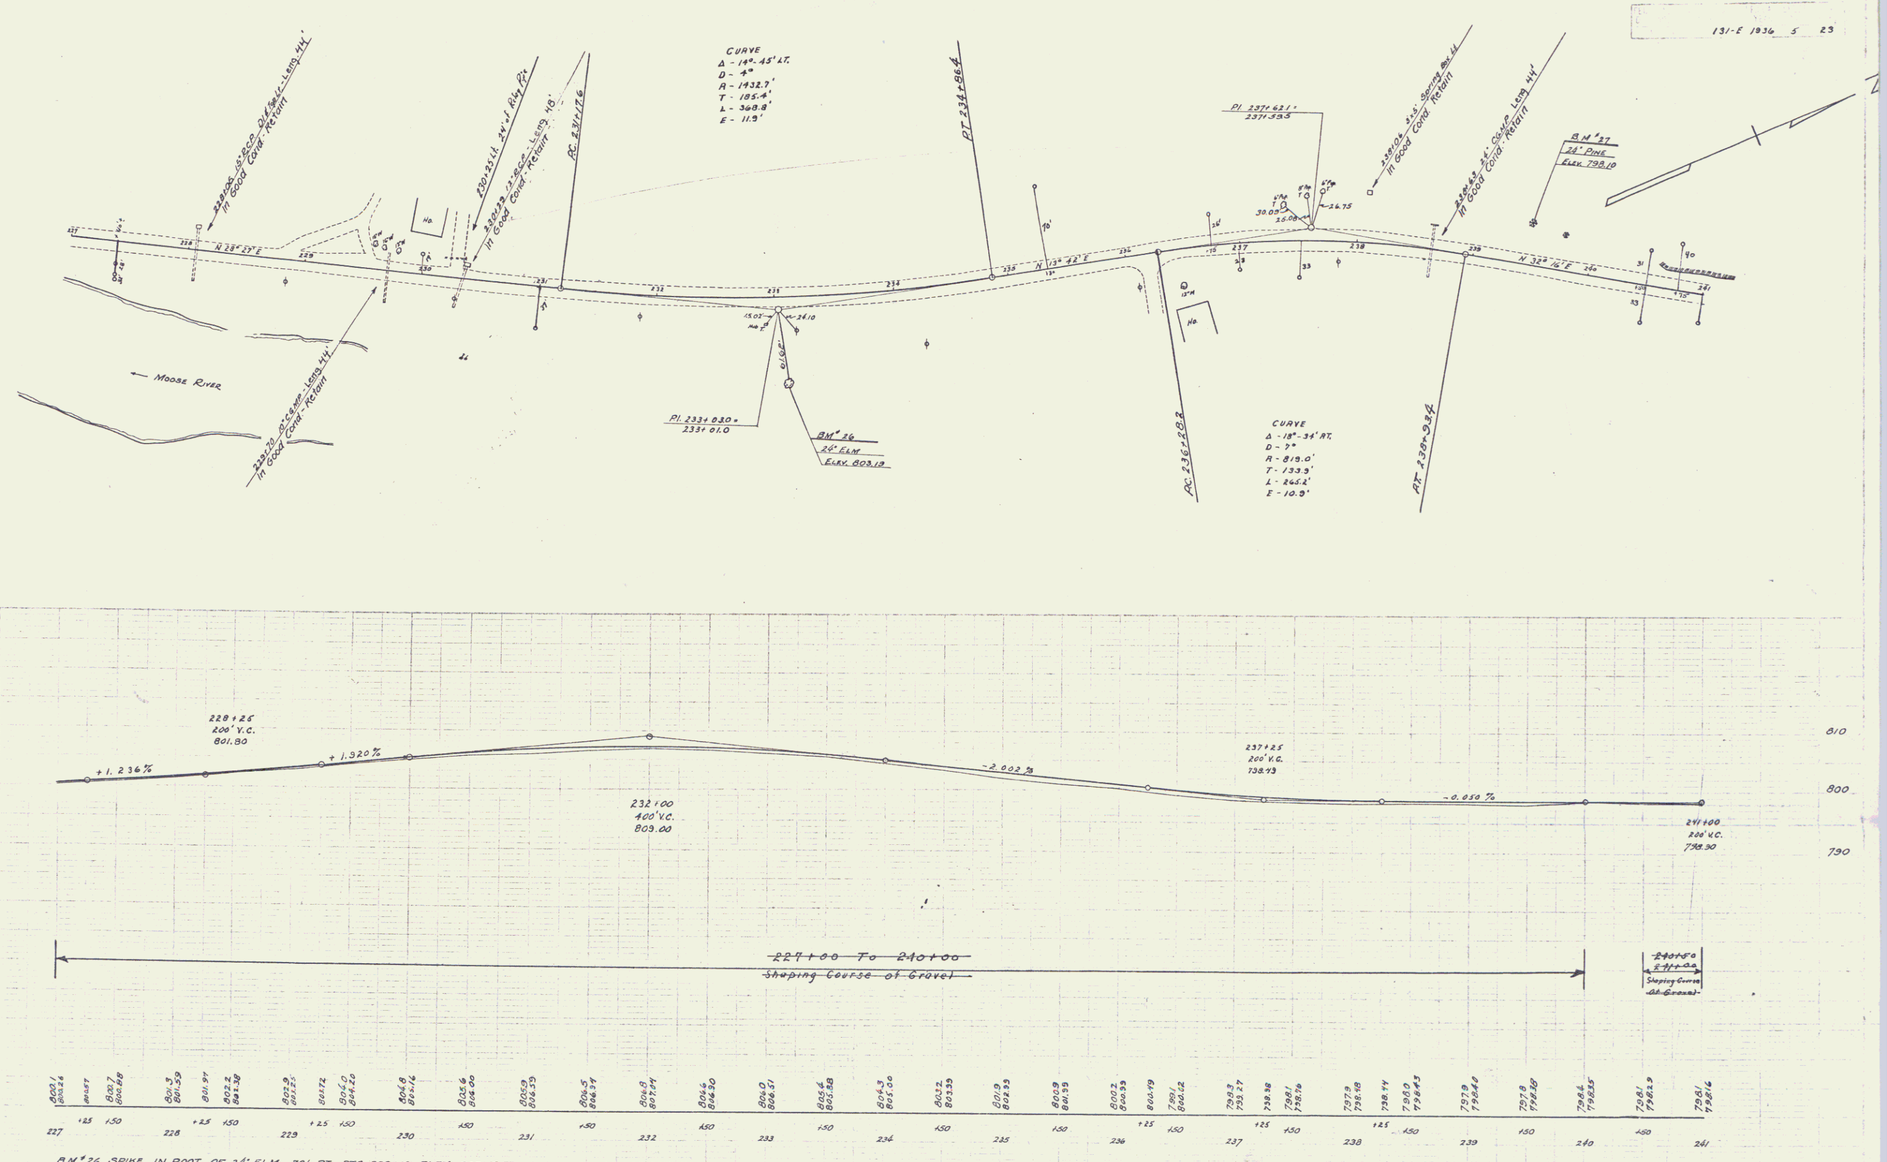
131-E 1936 5 23
CURVE
Δ - 14°-45' LT.
D - 4°
R - 1432.7'
T - 185.4'
L - 368.8'
E - 11.9'
PT 234+86.4
PI 237+621.1
2371.595
BM #27
24" PINE
ELEV. 798.10
N 28° 29' E
N 13° 42' E
N 32° 16' E
MOOSE RIVER
PI. 233+030.
2331.01.0
BM #26
24" ELM
ELEV. 803.19
RC 231+176
RC 236+282
PT 238+935
CURVE
Δ - 18°-34' RT.
D - 7°
R - 819.0'
T - 133.3'
L - 265.2'
E - 10.9'
+1.236%
228+25
200' V.C.
801.80
+1.920%
232+00
400' V.C.
803.00
-2.002%
237+25
200' V.C.
798.93
-0.050%
241+00
200' V.C.
798.30
810
800
790
~~227+00 To 240+00~~
~~Shaping Course of Gravel~~
~~240+50~~
~~Shaping Course of Gravel~~
BM #26 SPIKE IN ROOT OF 24" ELM 70' RT. STA. 233+10 ELEV. 803.19
BM #27 " " " 24" PINE 35' LT. STA. 239+49 ELEV. 798.10
Series F.A.P. 131-E
Sheet 5 of 23

3