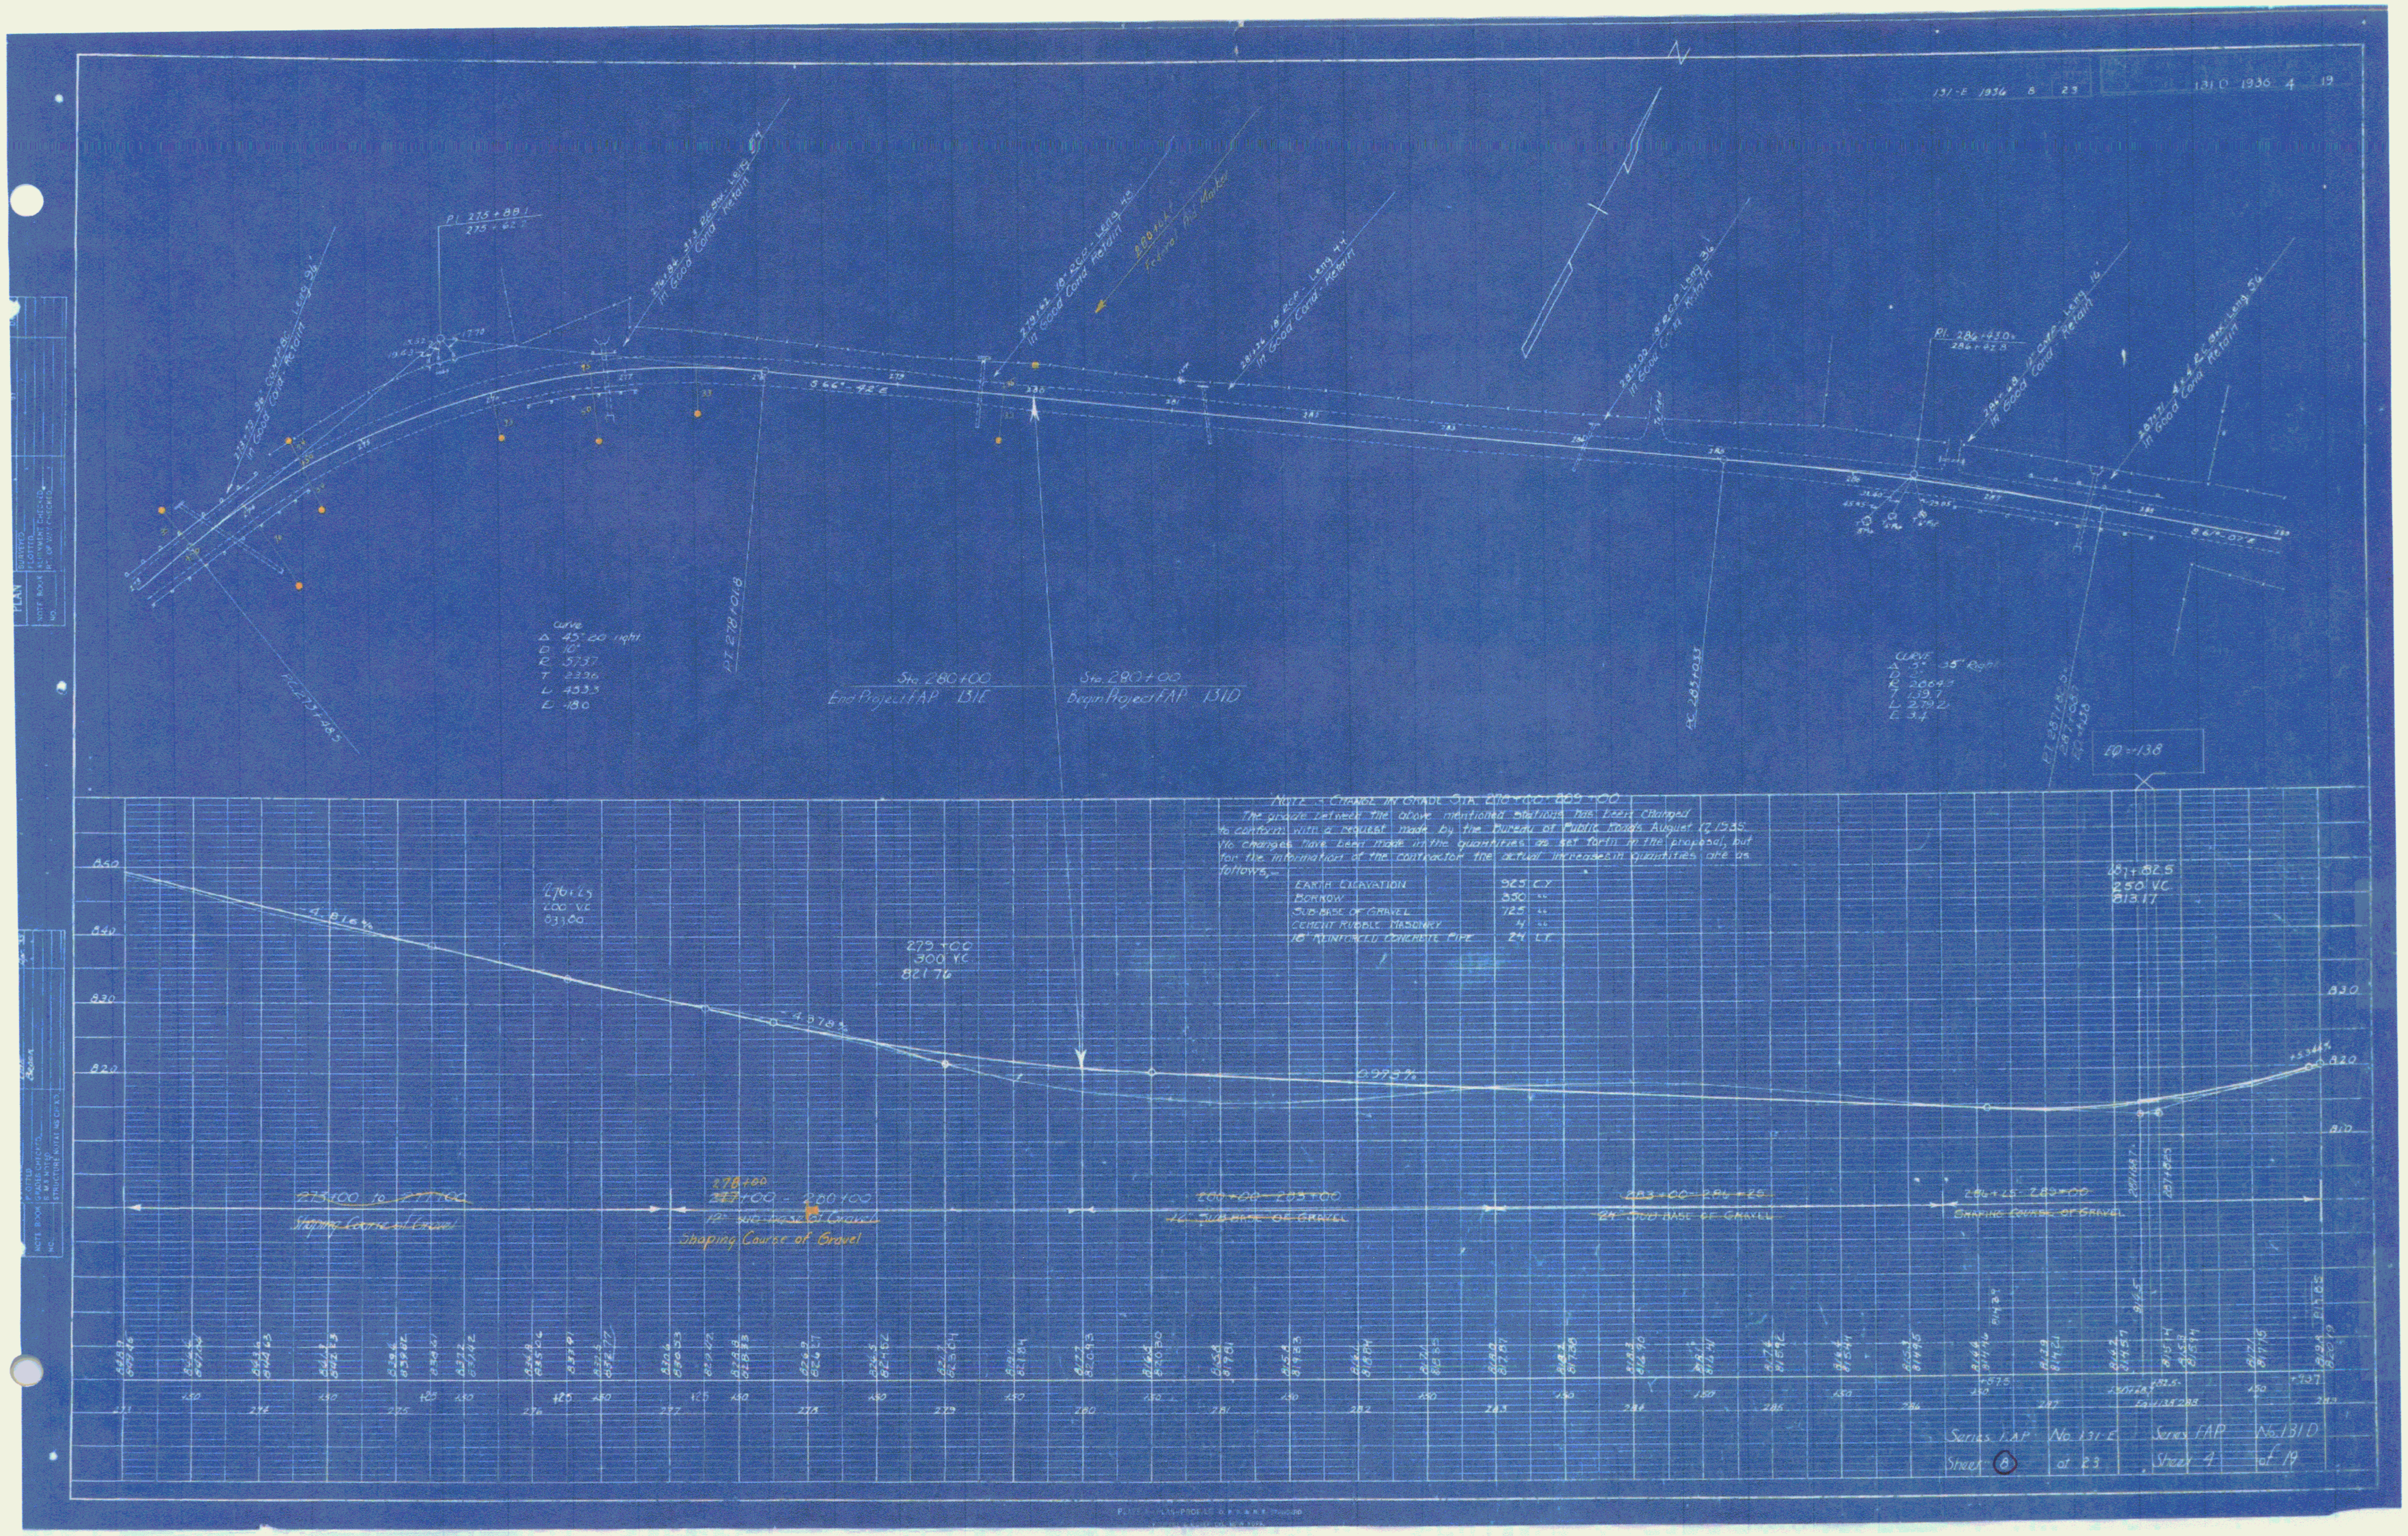
131-E 1936 8 23
131 D 1936 4 19
Sta 280+00
End Project FAP 131E
Sta 280+00
Begin Project FAP 131D
Curve
Δ 45° 00' right
D 10°
R 573.7
T 237.6
L 453.3
E 48.0
CURVE
Δ 3° 38' Right
R 2864.9
T 139.1
L 279.2
E 3.7
Eq. +138
NOTE - CHANGE IN GRADE STA. 276+00 - 285+00
The grade between the above mentioned stations has been changed
to conform with a request made by the Bureau of Public Roads August 17, 1935.
No changes have been made in the quantities as set forth in the proposal, but
for the information of the contractor the actual increases in quantities are as
follows,—
EARTH EXCAVATION 925 C.Y.
BORROW 350 "
SUB-BASE OF GRAVEL 725 "
CEMENT RUBBLE MASONRY 4 "
18" REINFORCED CONCRETE PIPE 24 L.F.
273+00
300 V.C.
821.76
287+82.5
250 V.C.
813.17
Shaping Course of Gravel
Shaping Course of Gravel
Sub-Base of Gravel
Sub-Base of Gravel
Shaping Course of Gravel
Series FAP No. 131-E
Sheet 8 of 23
Series FAP No. 131 D
Sheet 4 of 19

6