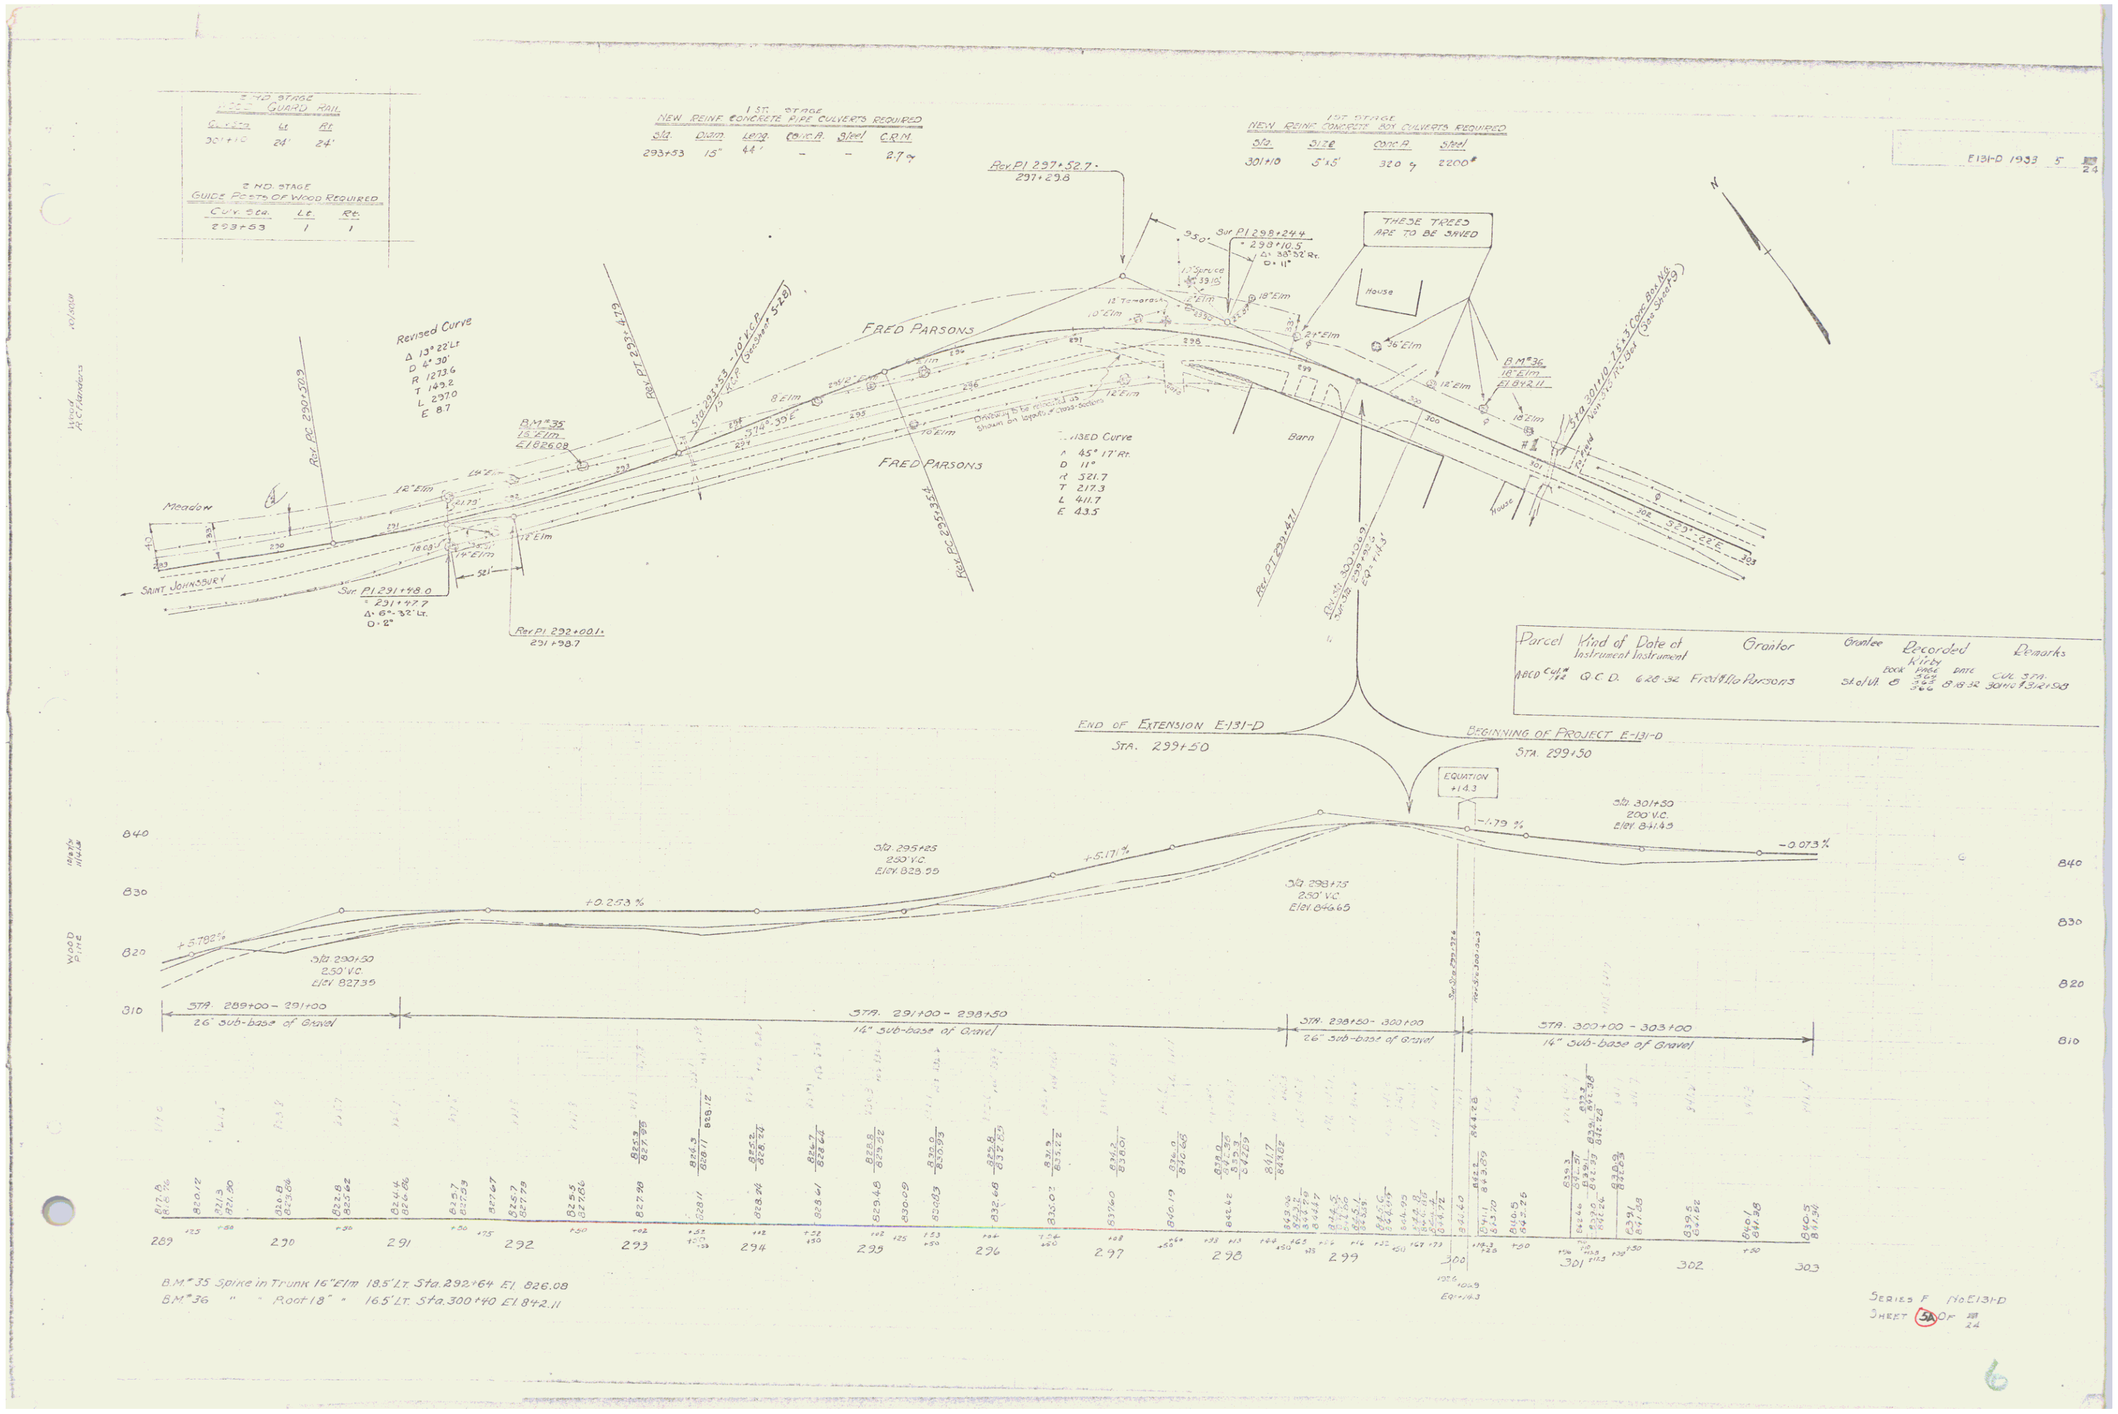

Parcel	Kind of Instrument	Date of Instrument	Grantor	Grantee	Recorded Book	Page	Date	Remarks
ABCD	Cul. & Ut.	Q.C.D. 6.28.32	Fred & Ida Parsons	St. of Vt.	Kitty 365 365 366		8.18.32	Cul. Sta. 300+10 & 3+21.98