FED. ROAD DIST. NO.	STATE	FED. AID PROJ. NO.	FISCAL YEAR	SHEET NO.	TOTAL SHEETS
9	VT.	31	1921	3	42

GUARD RAIL REQUIRED

ON LEFT

Sta 14+06 to 14+30 Length - 24 ft.

ON RIGHT

Sta 1+88 to 3+96 Length - 208 ft.

Sta 14+06 to 14+30 " 24 -

TOTAL THIS SHEET 256 ft.

NEW CULVERTS REQUIRED

Sta 14+18 18 in. Corr. Iron Pipe 30 ft.

Concrete Headwalls 1-2-4-5 1.5 cu. yds.

SUB BASE REQUIRED

Sta 4+00 to 14+00 Length 1000 ft.

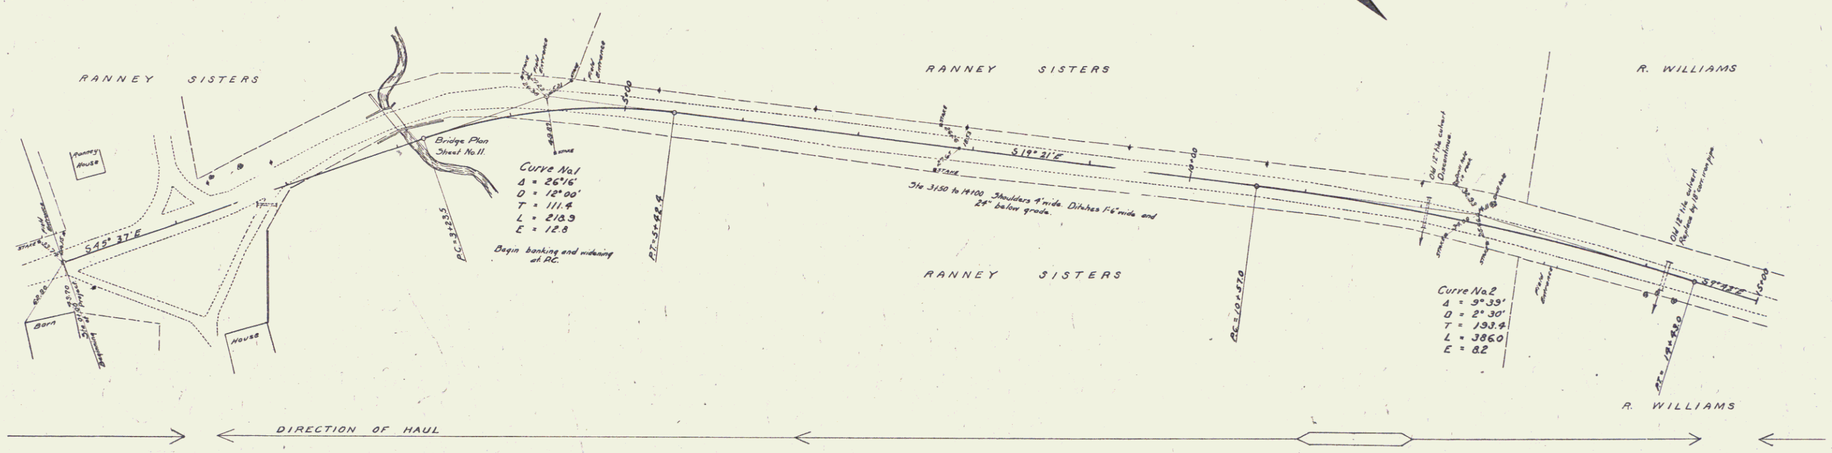

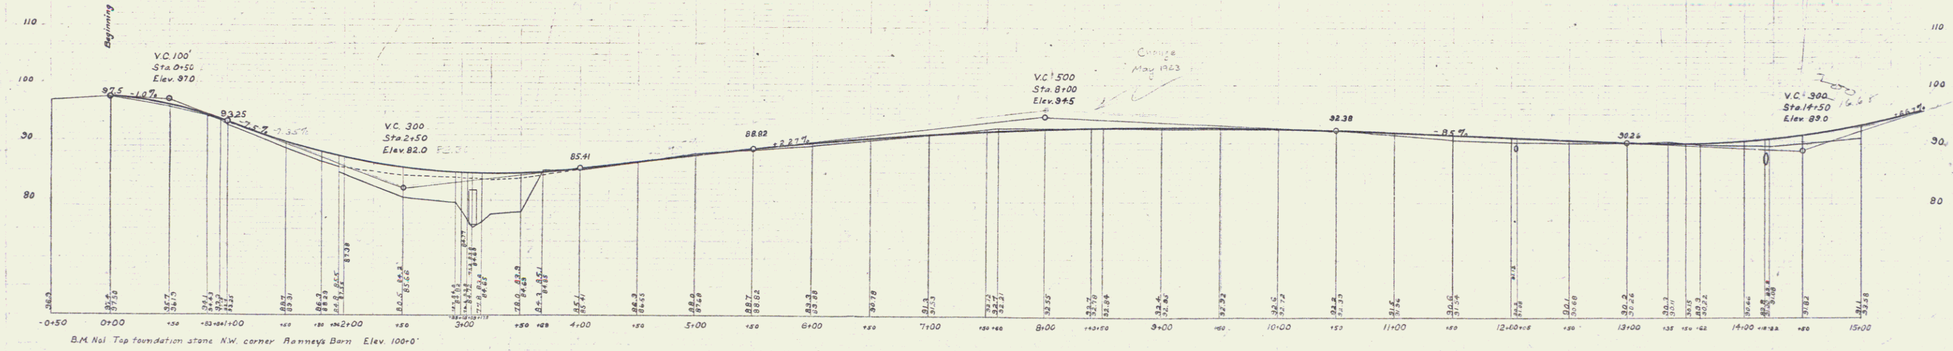

B.M. No. 1 Top foundation stone N.W. corner Ranney's Barn Elev. 100+0'

B.M. No. 2 Small drill hole on ledge in field on left of Sta. 11+06 Elev. 97.33

Series F No. 31

Sheet 3 of 42

2