PARCEL	INSTRUMENT	DATE	GRANTOR	GRANTEE	RECORDED CONCORD BOOK	PAGE	DATE	REMARKS
A.B	W.D.D.E	11-8-44	EDWARD & MARGUERITE BEGIN	ST OF VT.	33	182-3	11-15-44	

9		131(10)	1946	4	14

Δ ~~6°06' Lt.~~ 6°11' Lt.
D 1°30'
R 3819.8
T ~~2035~~ 206.3
L ~~4067~~ 412.2
E ~~54~~ 5.6

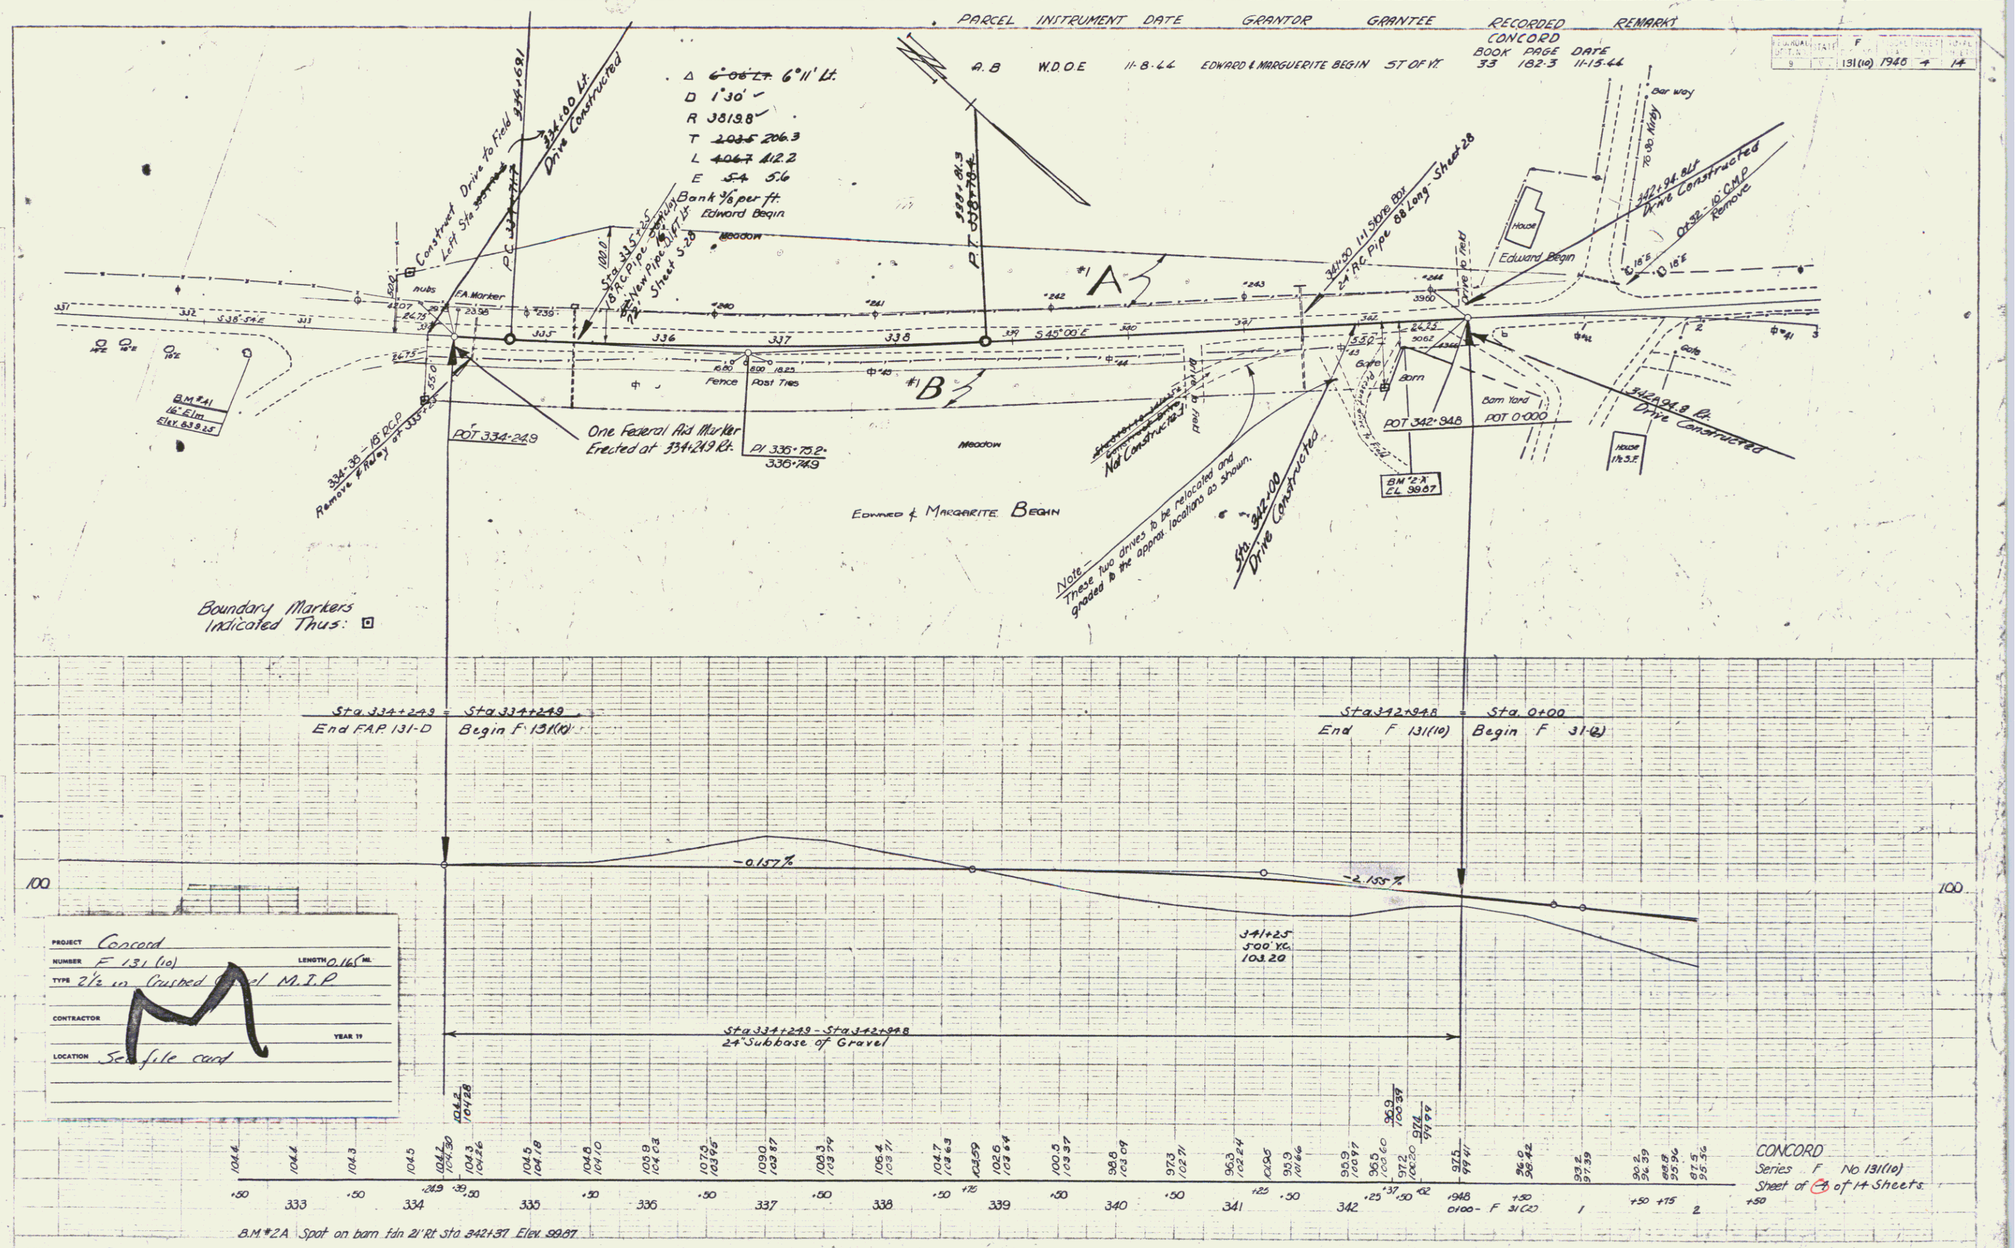

2