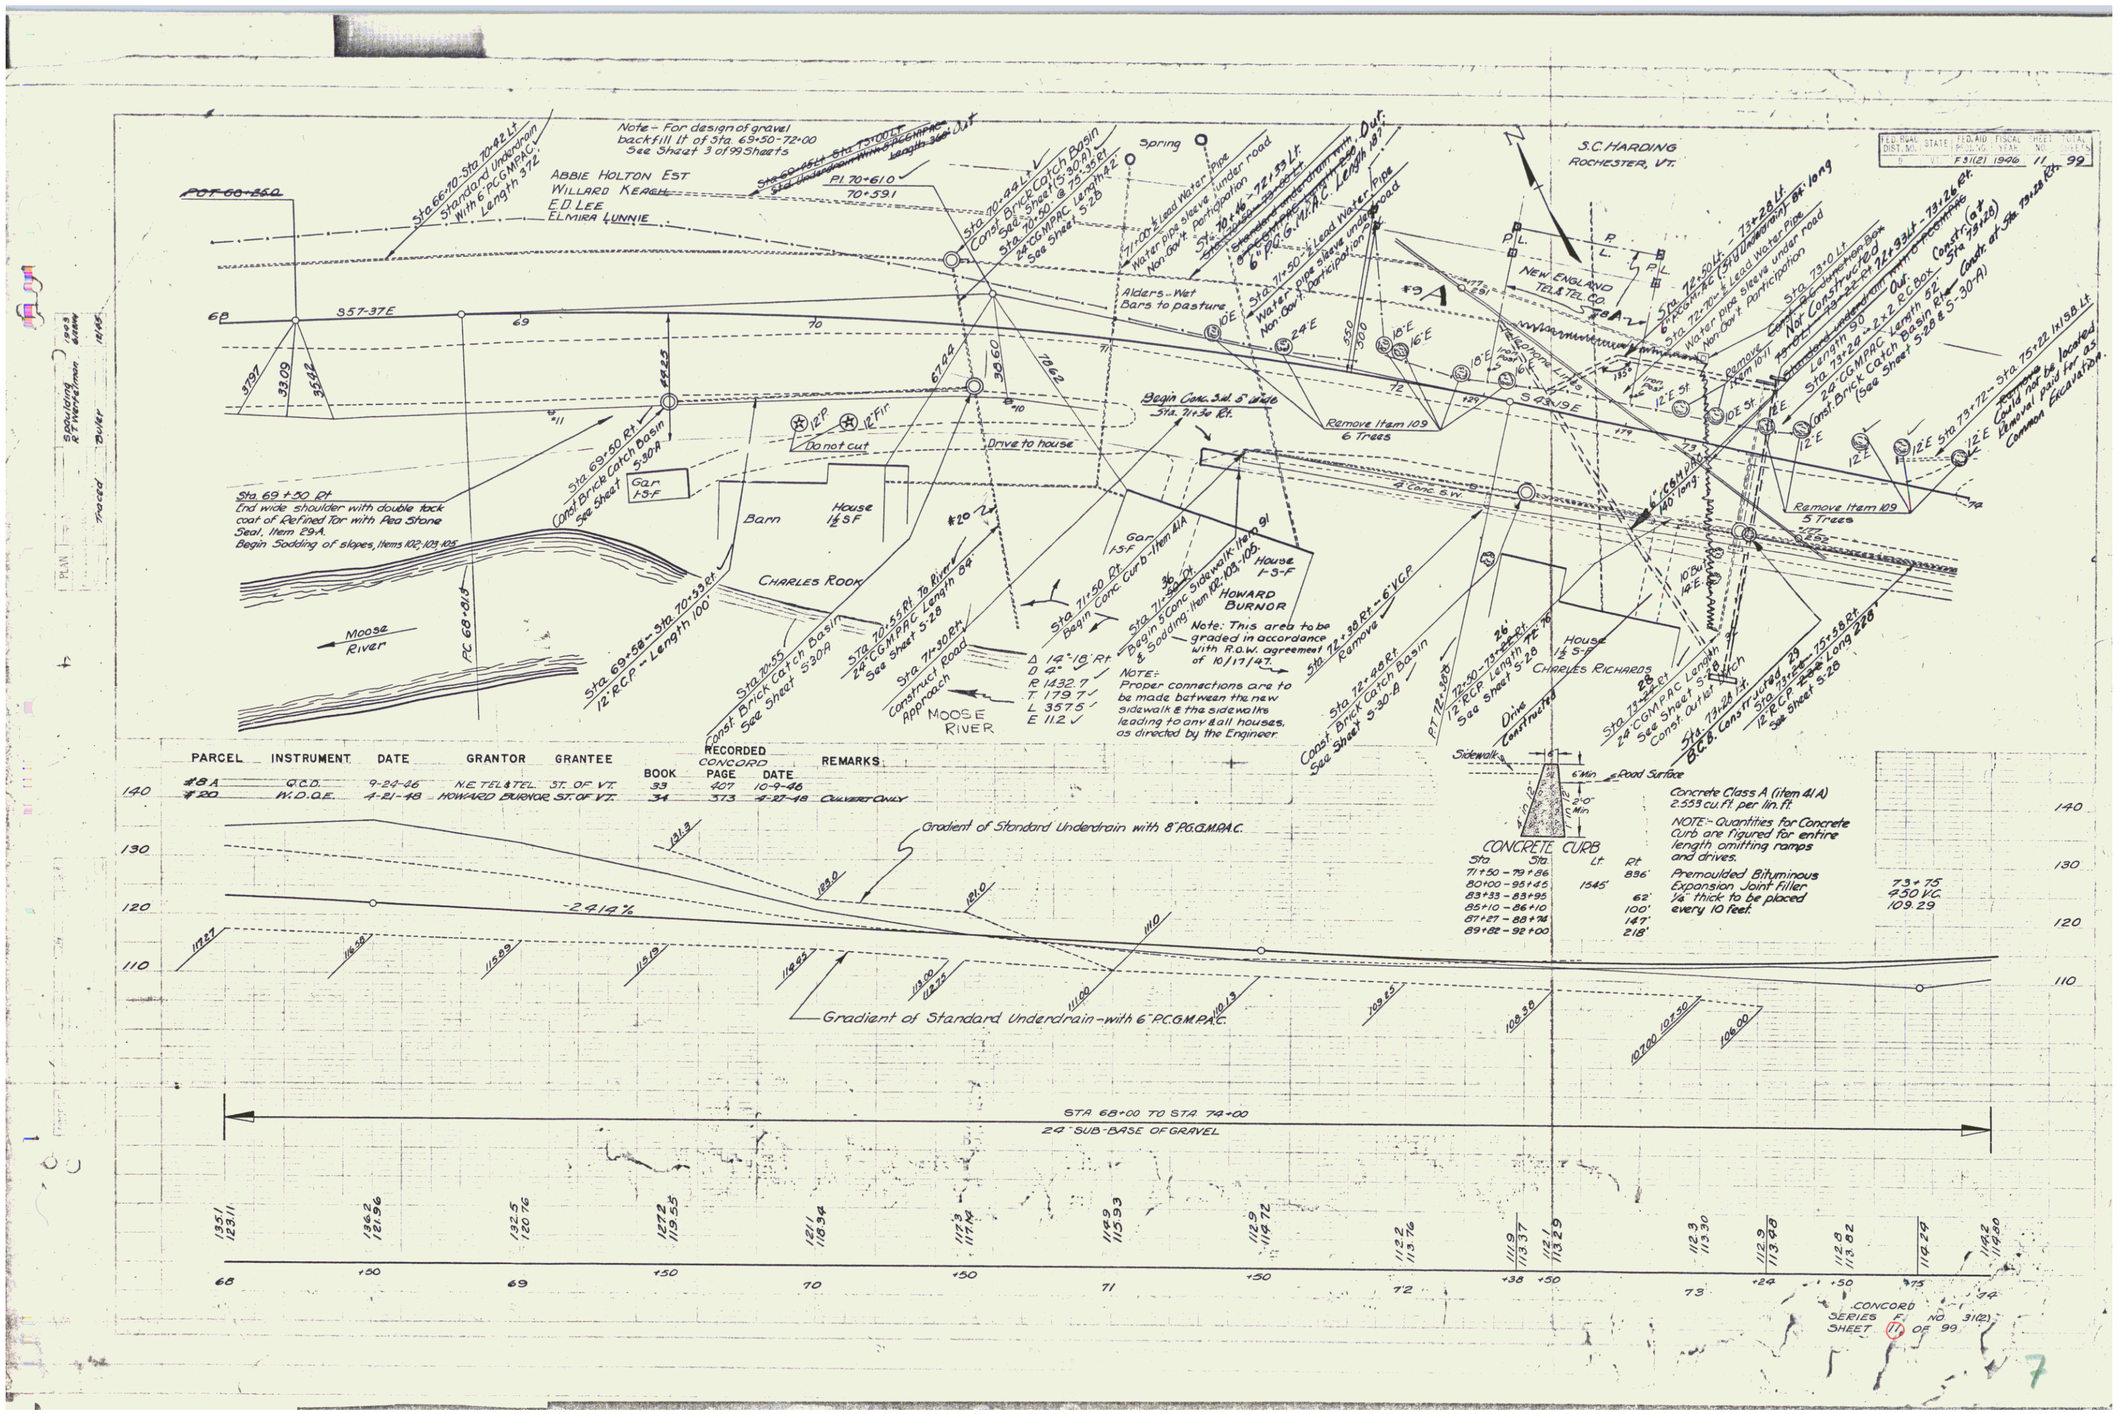

PARCEL	INSTRUMENT	DATE	GRANTOR	GRANTEE	RECORDED CONCORD BOOK	PAGE	DATE	REMARKS
#8 A	Q.C.D.	9-24-46	N.E. TEL & TEL.	ST. OF VT.	33	407	10-9-46	
#20	W.D.Q.E.	4-21-48	HOWARD BURNOR	ST. OF VT.	34	513	4-27-48	CULVERT ONLY