POOR ORIGINAL COPY

F-31(2) 1946 22 99

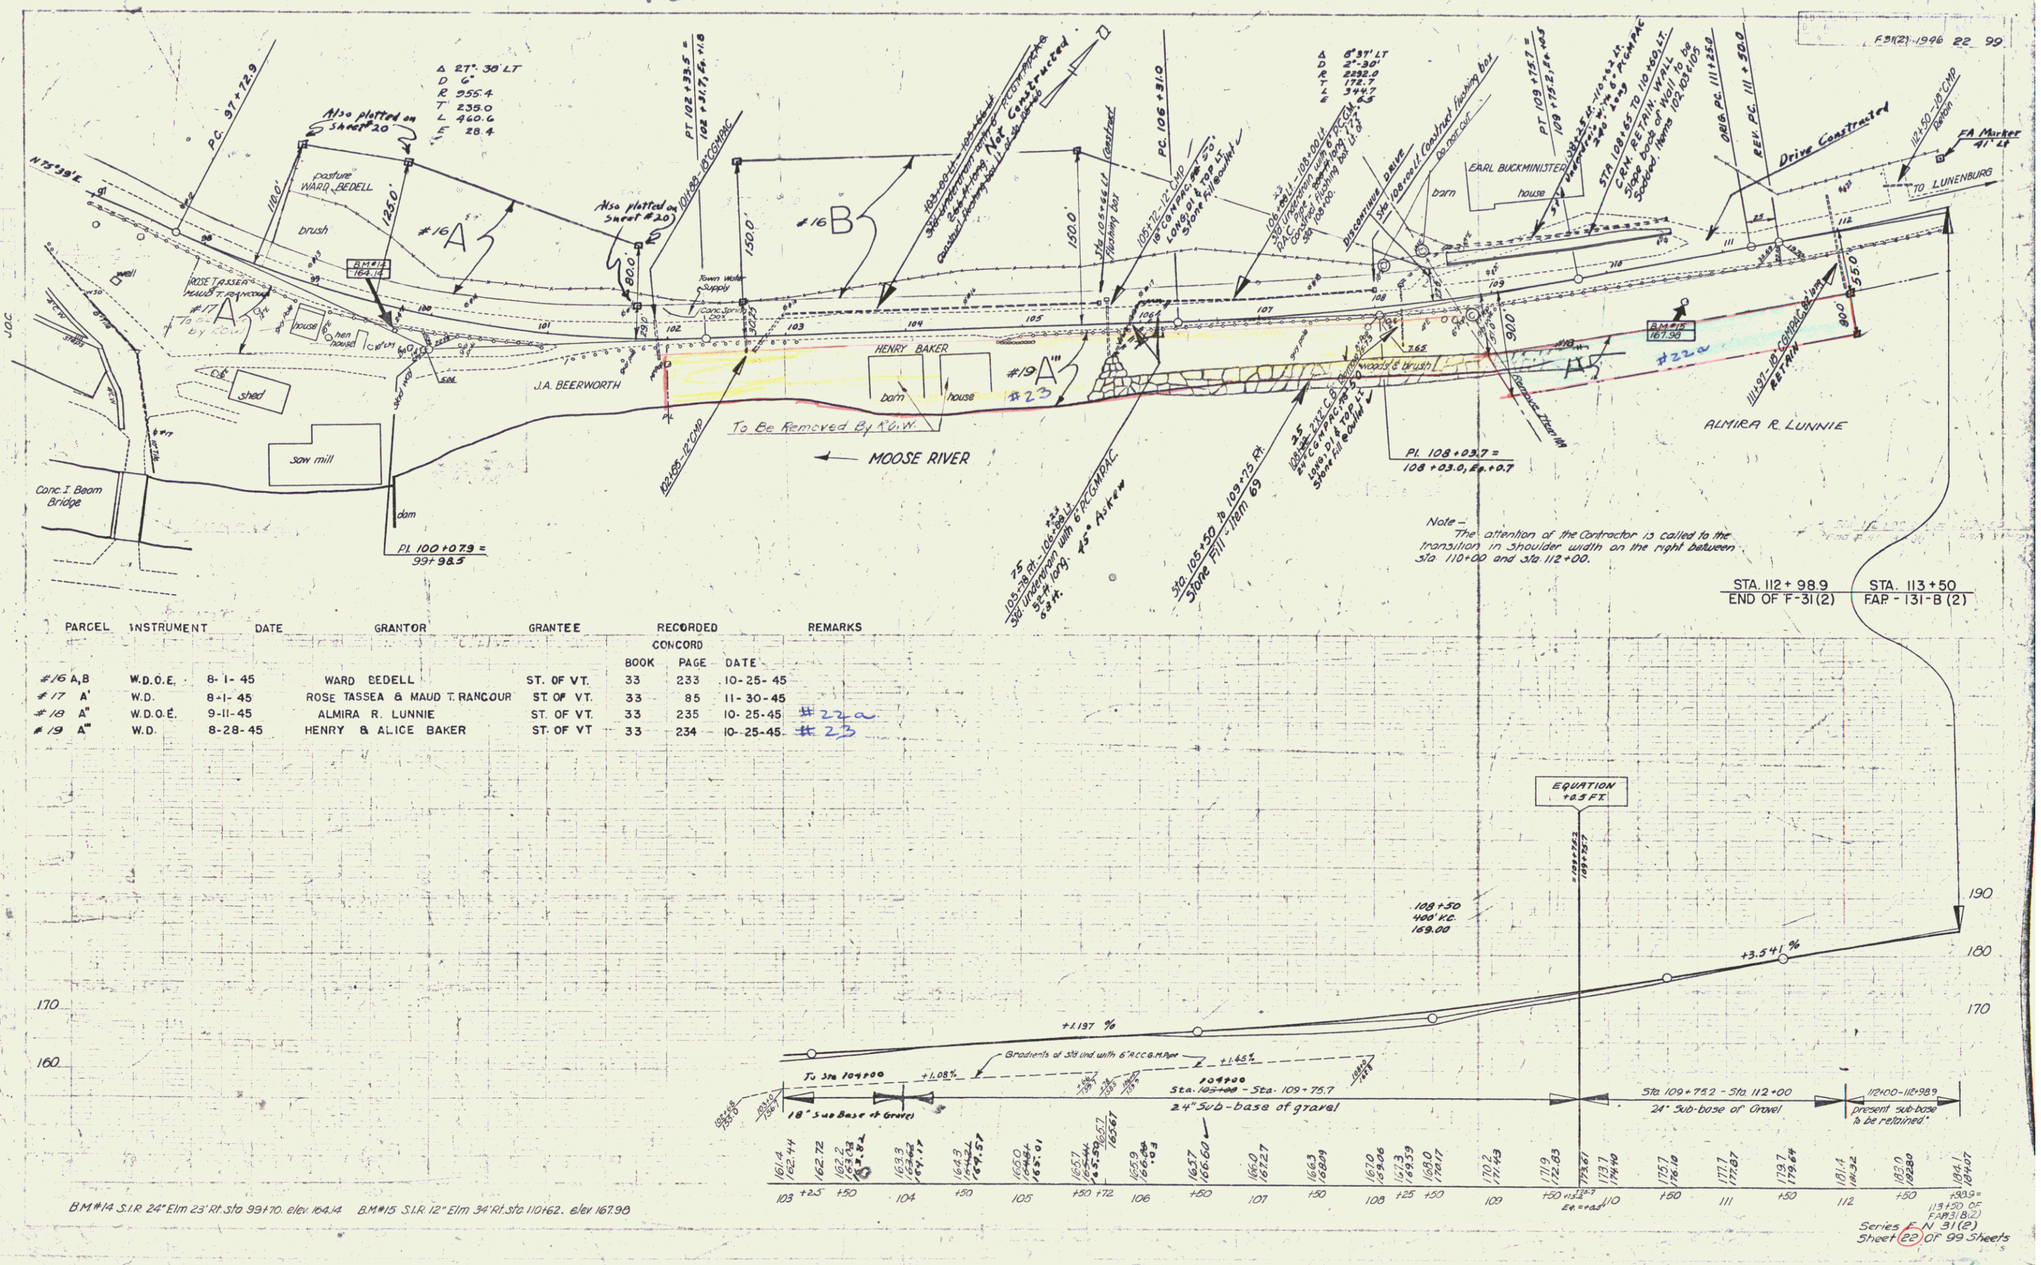

PARCEL	INSTRUMENT	DATE	GRANTOR	GRANTEE	RECORDED CONCORD BOOK	PAGE	DATE
#16 A,B	W.D.O.E.	8-1-45	WARD BEDELL	ST. OF VT.	33	233	10-25-45
#17 A'	W.D.	8-1-45	ROSE TASSEA & MAUD T. RANCOUR	ST. OF VT.	33	85	11-30-45
#18 A''	W.D.O.E.	9-11-45	ALMIRA R. LUNNIE	ST. OF VT.	33	235	10-25-45 #22a
#19 A'''	W.D.	8-28-45	HENRY & ALICE BAKER	ST. OF VT	33	234	10-25-45 #23

Series F-N 31(2)
Sheet (22) OF 99 Sheets

16