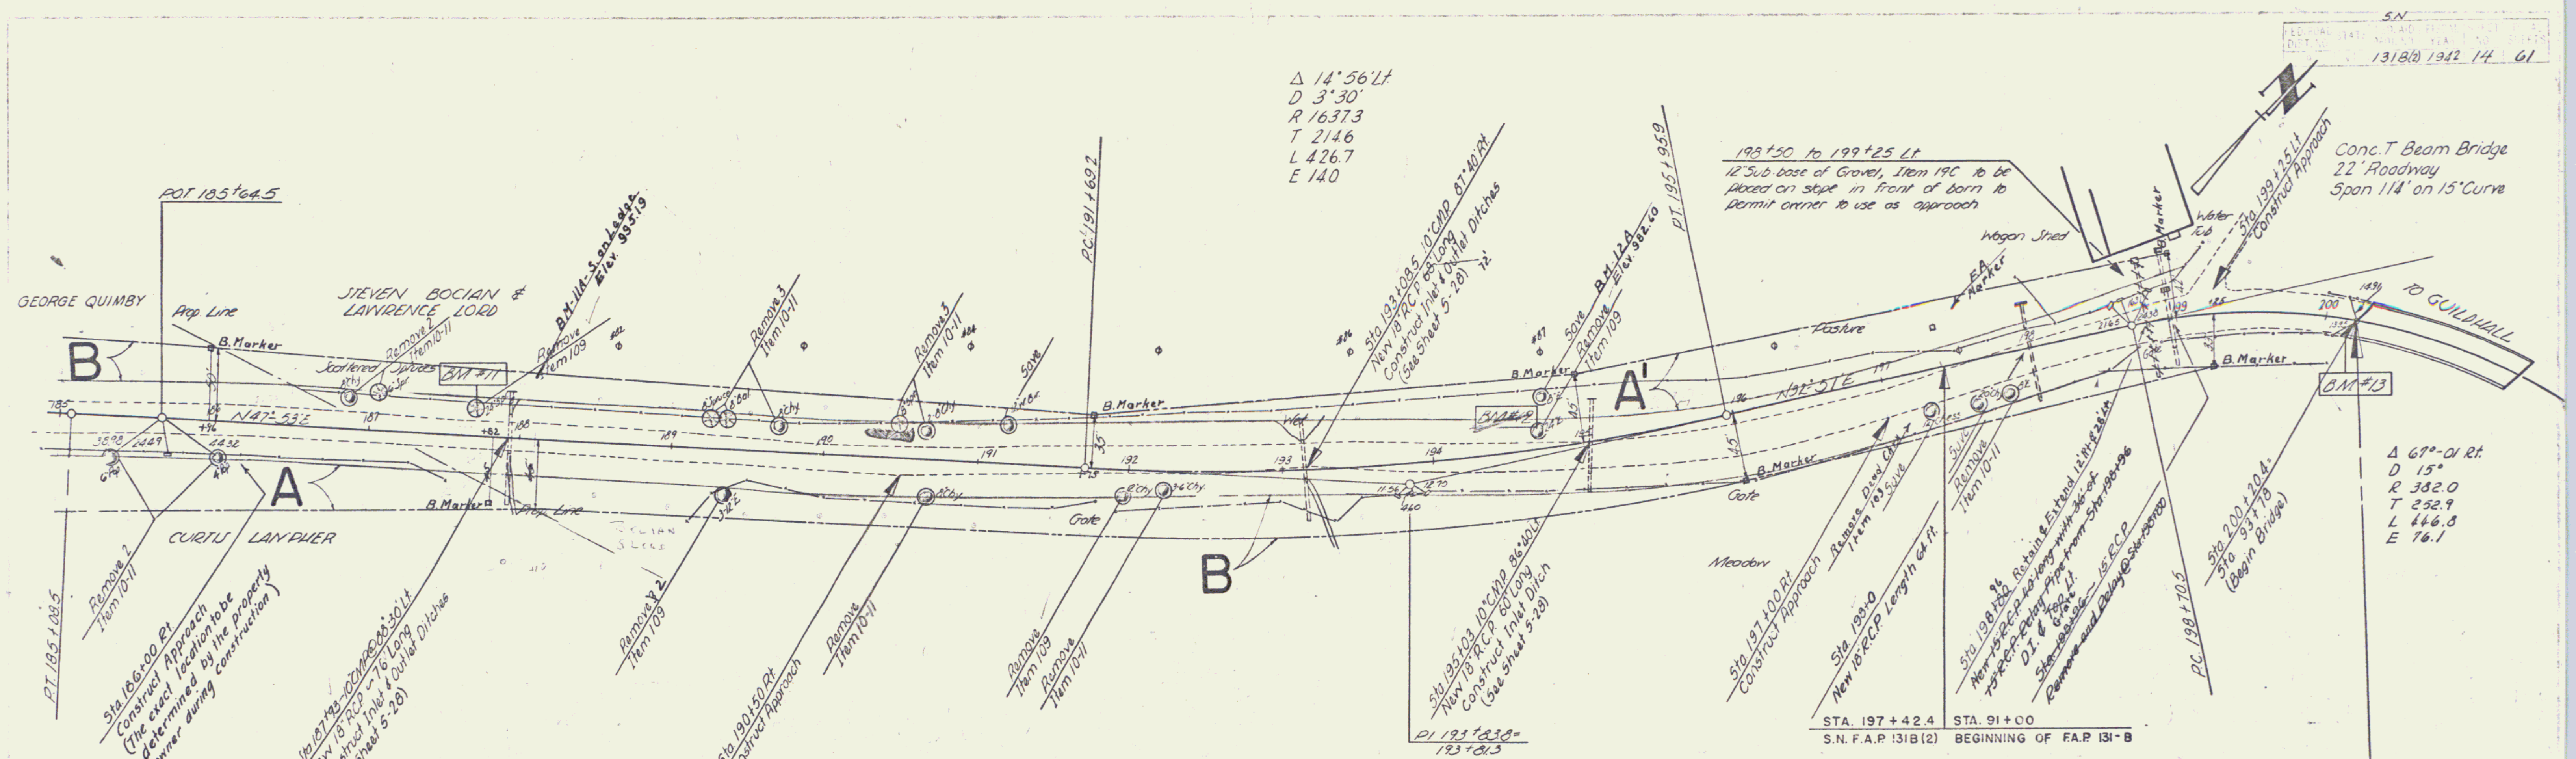

PARCEL	INSTRUMENT	DATE	GRANTOR	GRANTEE	RECORDED BOOK	RECORDED PAGE	RECORDED DATE	REMARKS
A'B	WDOE	6-26-41	LAURENCE A. LORD &	ST. OF VT.	31	451	7-4-41	CULV. STA. 198 + 00

STA. 200+20.4 END S.N. F.A.P 131 B(2) | STA. 93+78.0 F.A.P. 131-B

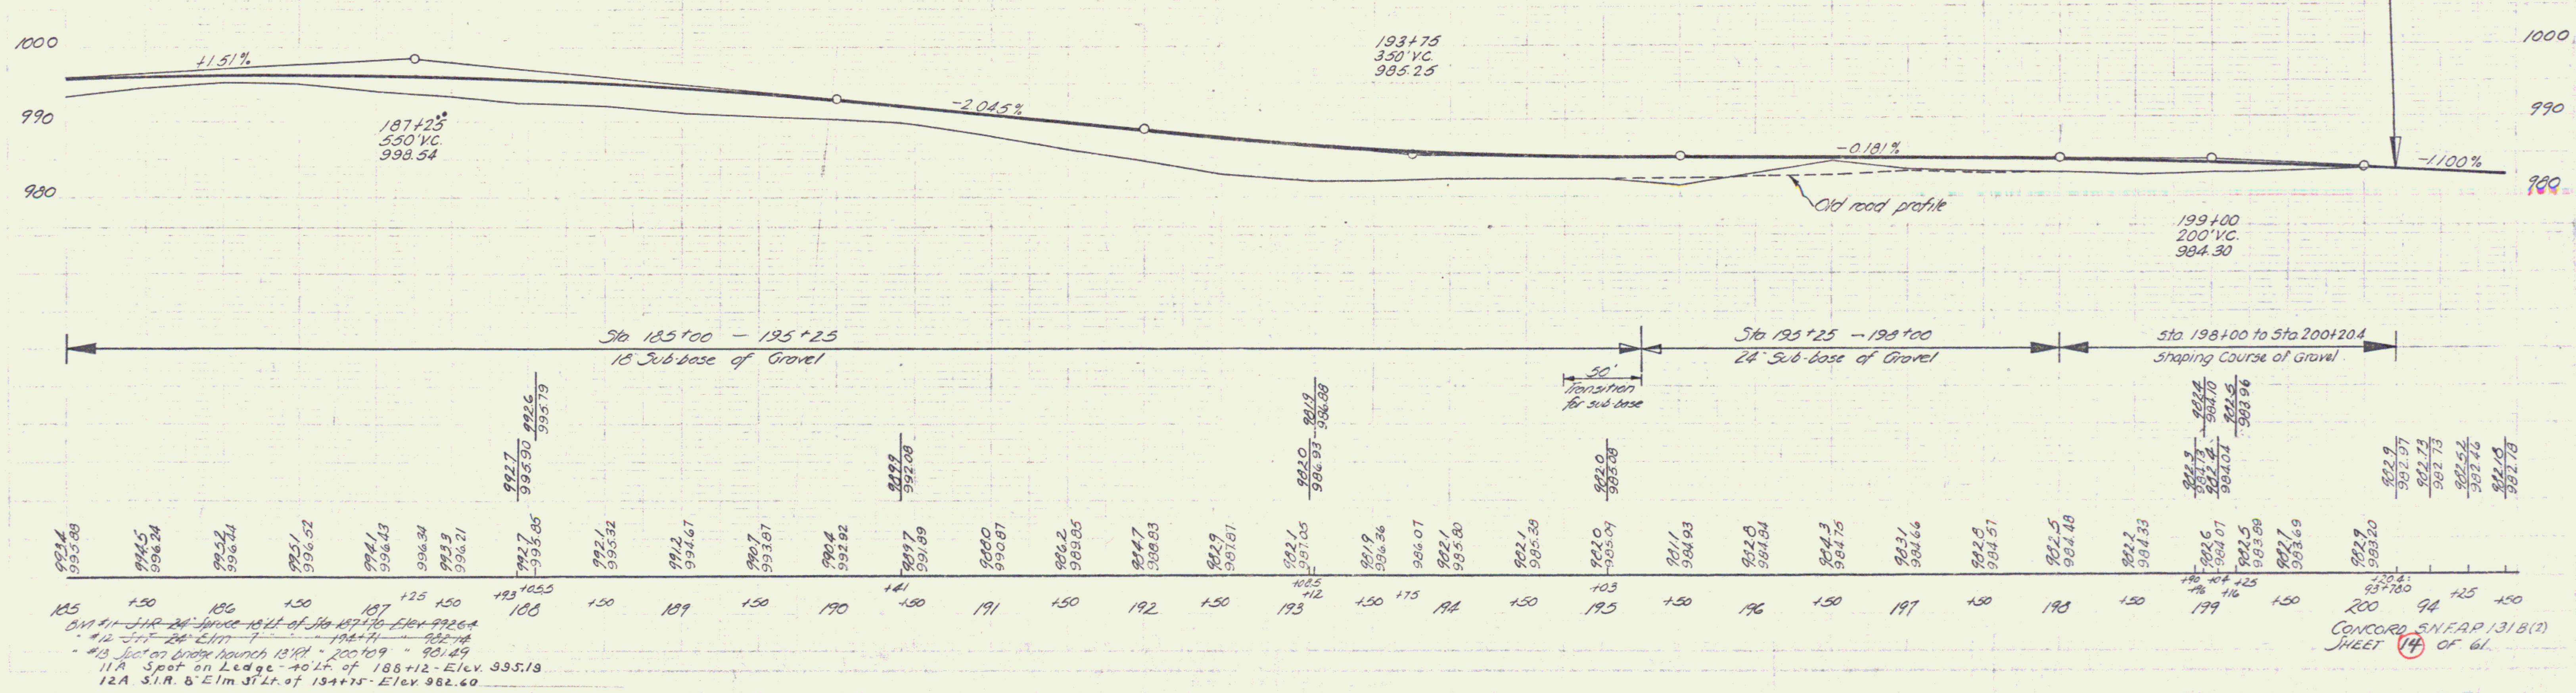

~~BM #11 S.I.R. 24" Spruce 18' Lt. of Sta. 187+70 Elev. 992.64~~
~~" #12 S.I.R. 24" Elm " " 194+71 " 982.14~~
" #13 Spot on bridge haunch 13' Rt. " 200+09 " 981.49
11A Spot on Ledge - 40' Lt. of 188+12 - Elev. 995.19
12A S.I.R. 8" Elm 31' Lt. of 194+75 - Elev. 982.60