| FED. ROAD REGION NO. | STATE | PROJECT NO. | FISCAL YEAR | SHEET NO. | TOTAL SHEETS |
|---|---|---|---|---|---|
| 1 | VT. | F-028-4(1) | POST WAR | 12 | 201 |

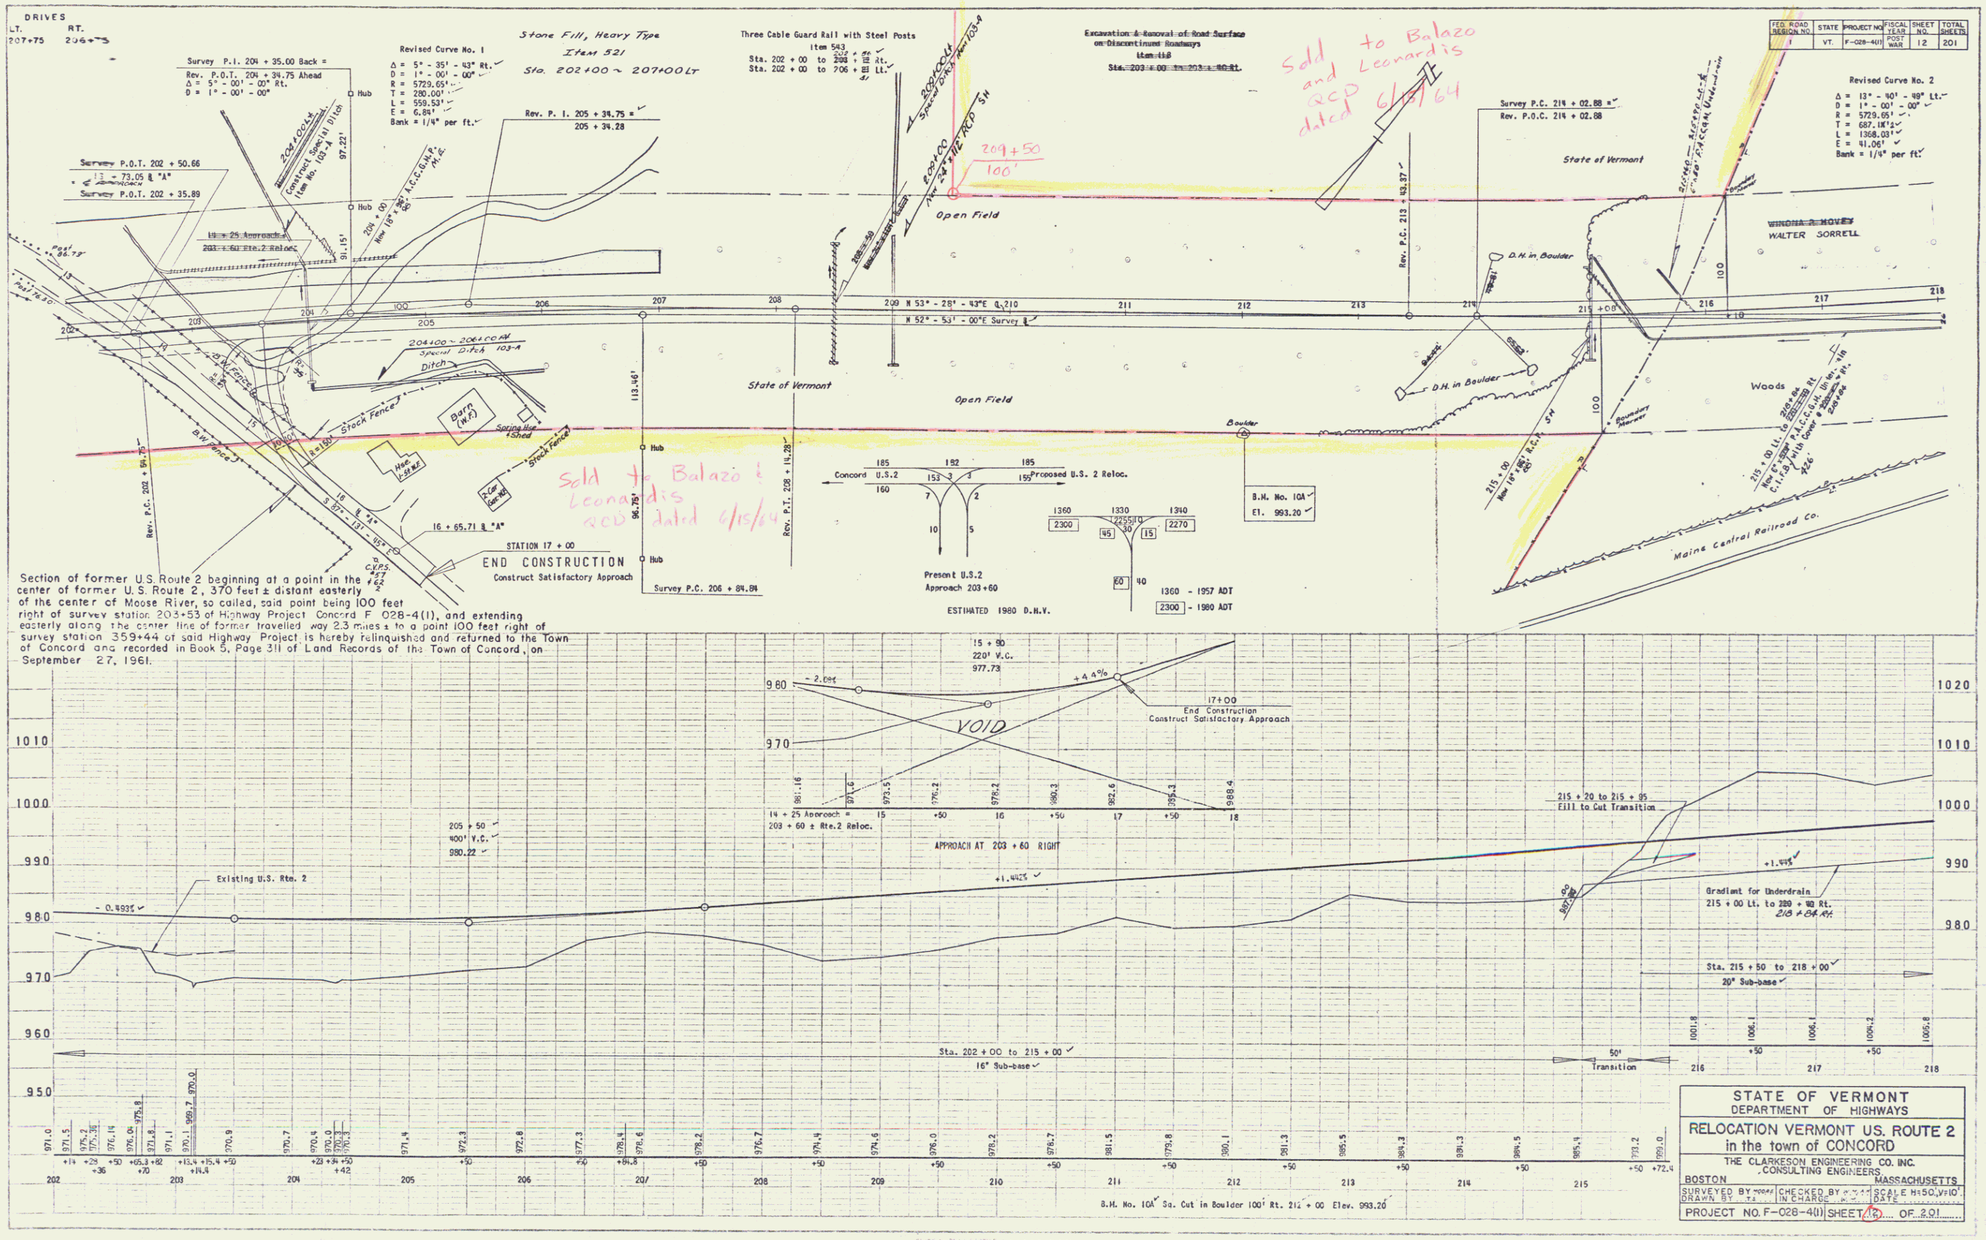


4