FED. ROAD REGION NO.	STATE	PROJECT NO.	FISCAL YEAR	SHEET NO.	TOTAL SHEETS
1	VT.	F-028-4(1)	POST WAR	14	201

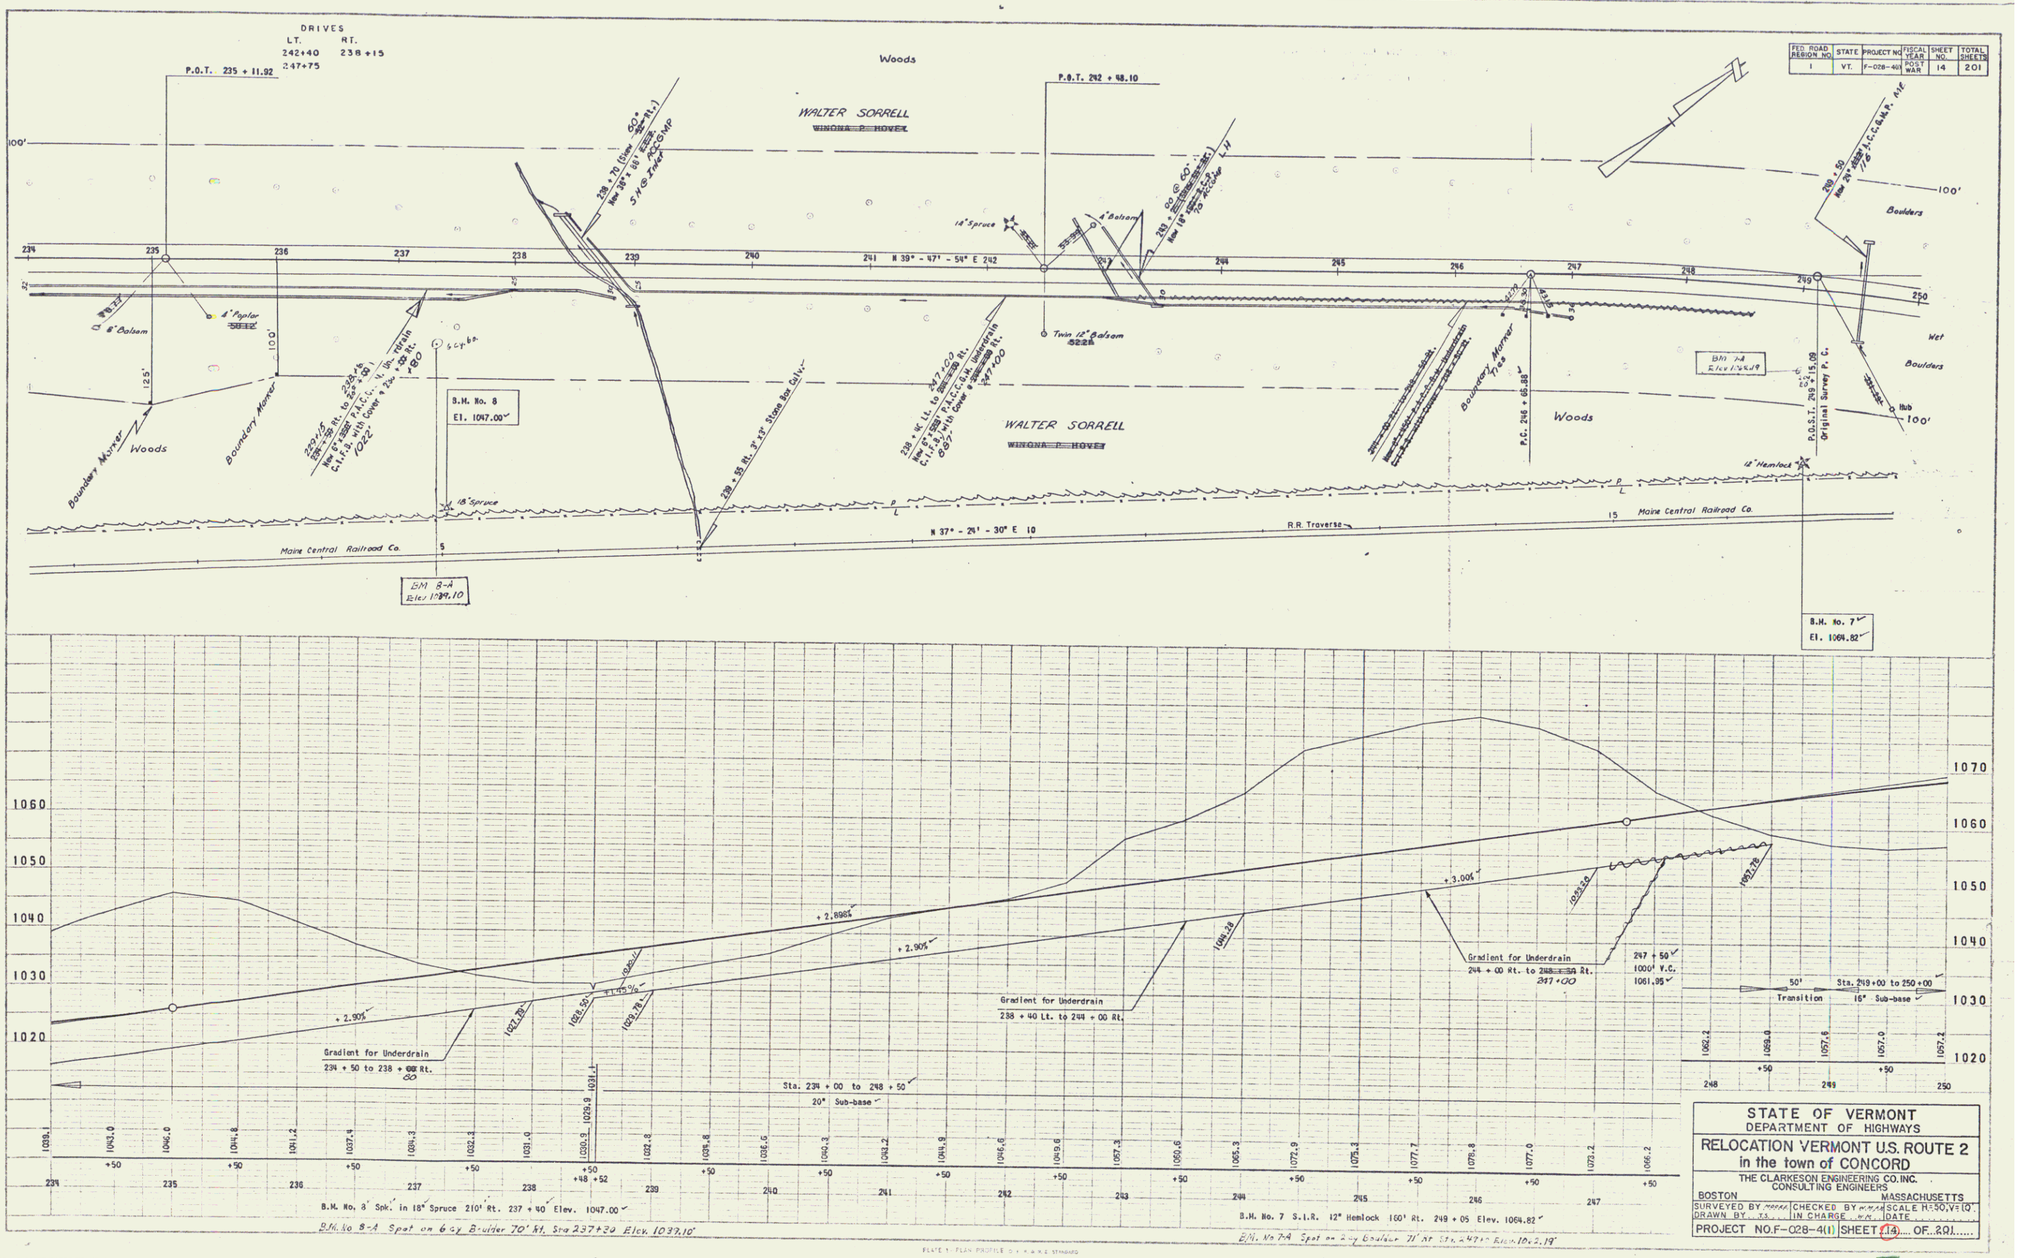

STATE OF VERMONT
DEPARTMENT OF HIGHWAYS

RELOCATION VERMONT U.S. ROUTE 2
in the town of CONCORD

THE CLARKESON ENGINEERING CO. INC.
CONSULTING ENGINEERS
BOSTON MASSACHUSETTS

SURVEYED BY ..... CHECKED BY ..... SCALE H=50, V=10
DRAWN BY T.S. IN CHARGE W.N. DATE .....

PROJECT NO. F-028-4(1) SHEET 14 OF 201

7