FED. ROAD REGION NO.	STATE	PROJECT NO.	FISCAL YEAR	SHEET NO.	TOTAL SHEETS
1	VT.	F-028-4(1)	POST WAR	20	201

MUCK EXCAVATION
STA. 311+50 – 321+50

DRIVES
LT. 320+40
RT. 322+30

PARKING AREA
328+00 – 330+50 LT.

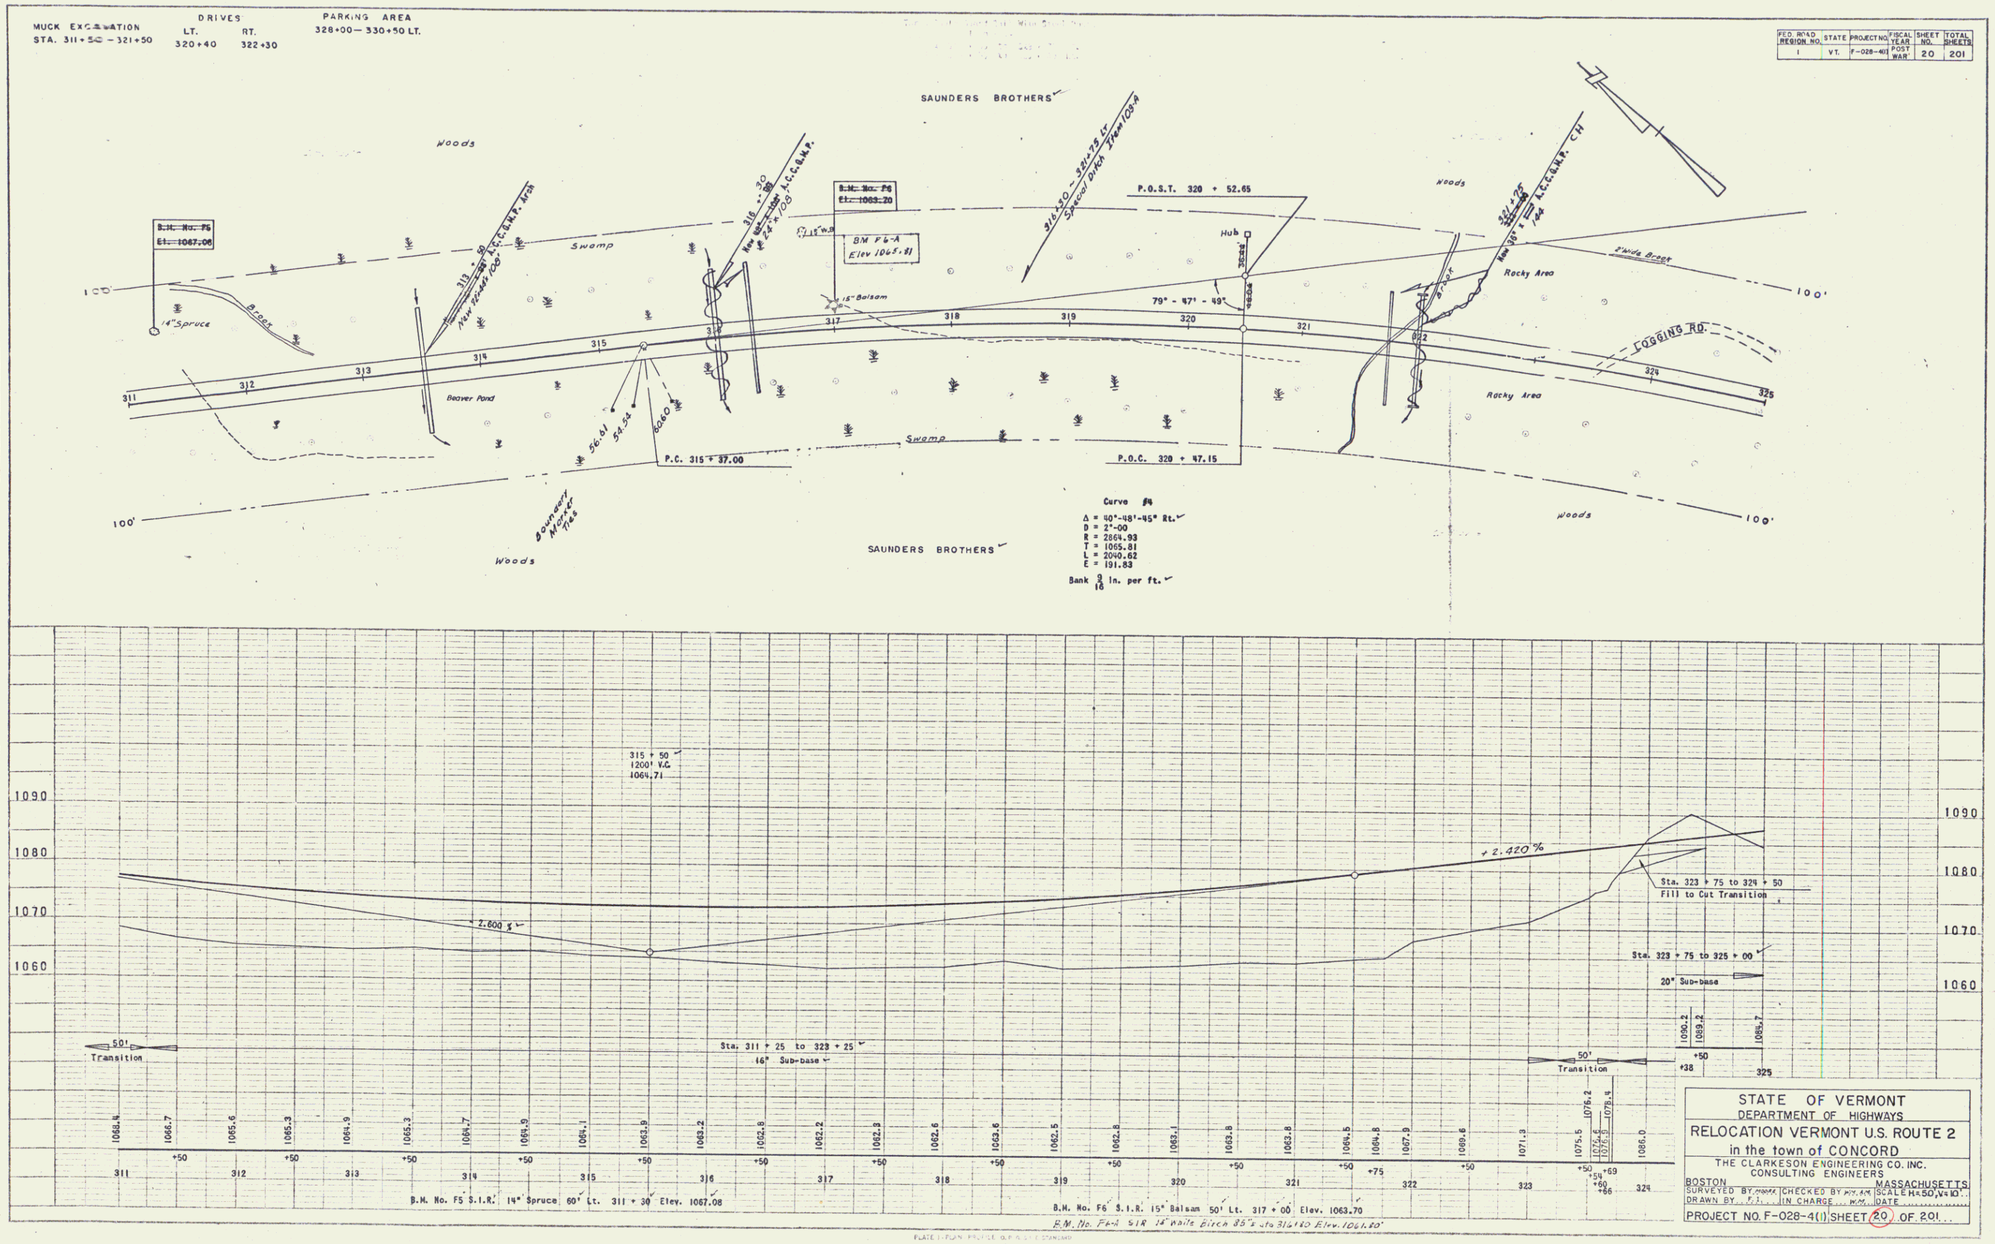

STATE OF VERMONT
DEPARTMENT OF HIGHWAYS

RELOCATION VERMONT U.S. ROUTE 2
in the town of CONCORD

THE CLARKESON ENGINEERING CO. INC.
CONSULTING ENGINEERS
BOSTON MASSACHUSETTS

SURVEYED BY [illegible] CHECKED BY [illegible] SCALE H.=50', V.=10'
DRAWN BY F.J. IN CHARGE W.M. DATE

PROJECT NO. F-028-4(1) SHEET 20 OF 201



12