FED. ROAD REGION NO.	STATE	PROJECT NO	FISCAL YEAR	SHEET NO.	TOTAL SHEETS
1	VT.	F-028-4(1)	POST WAR	21	201

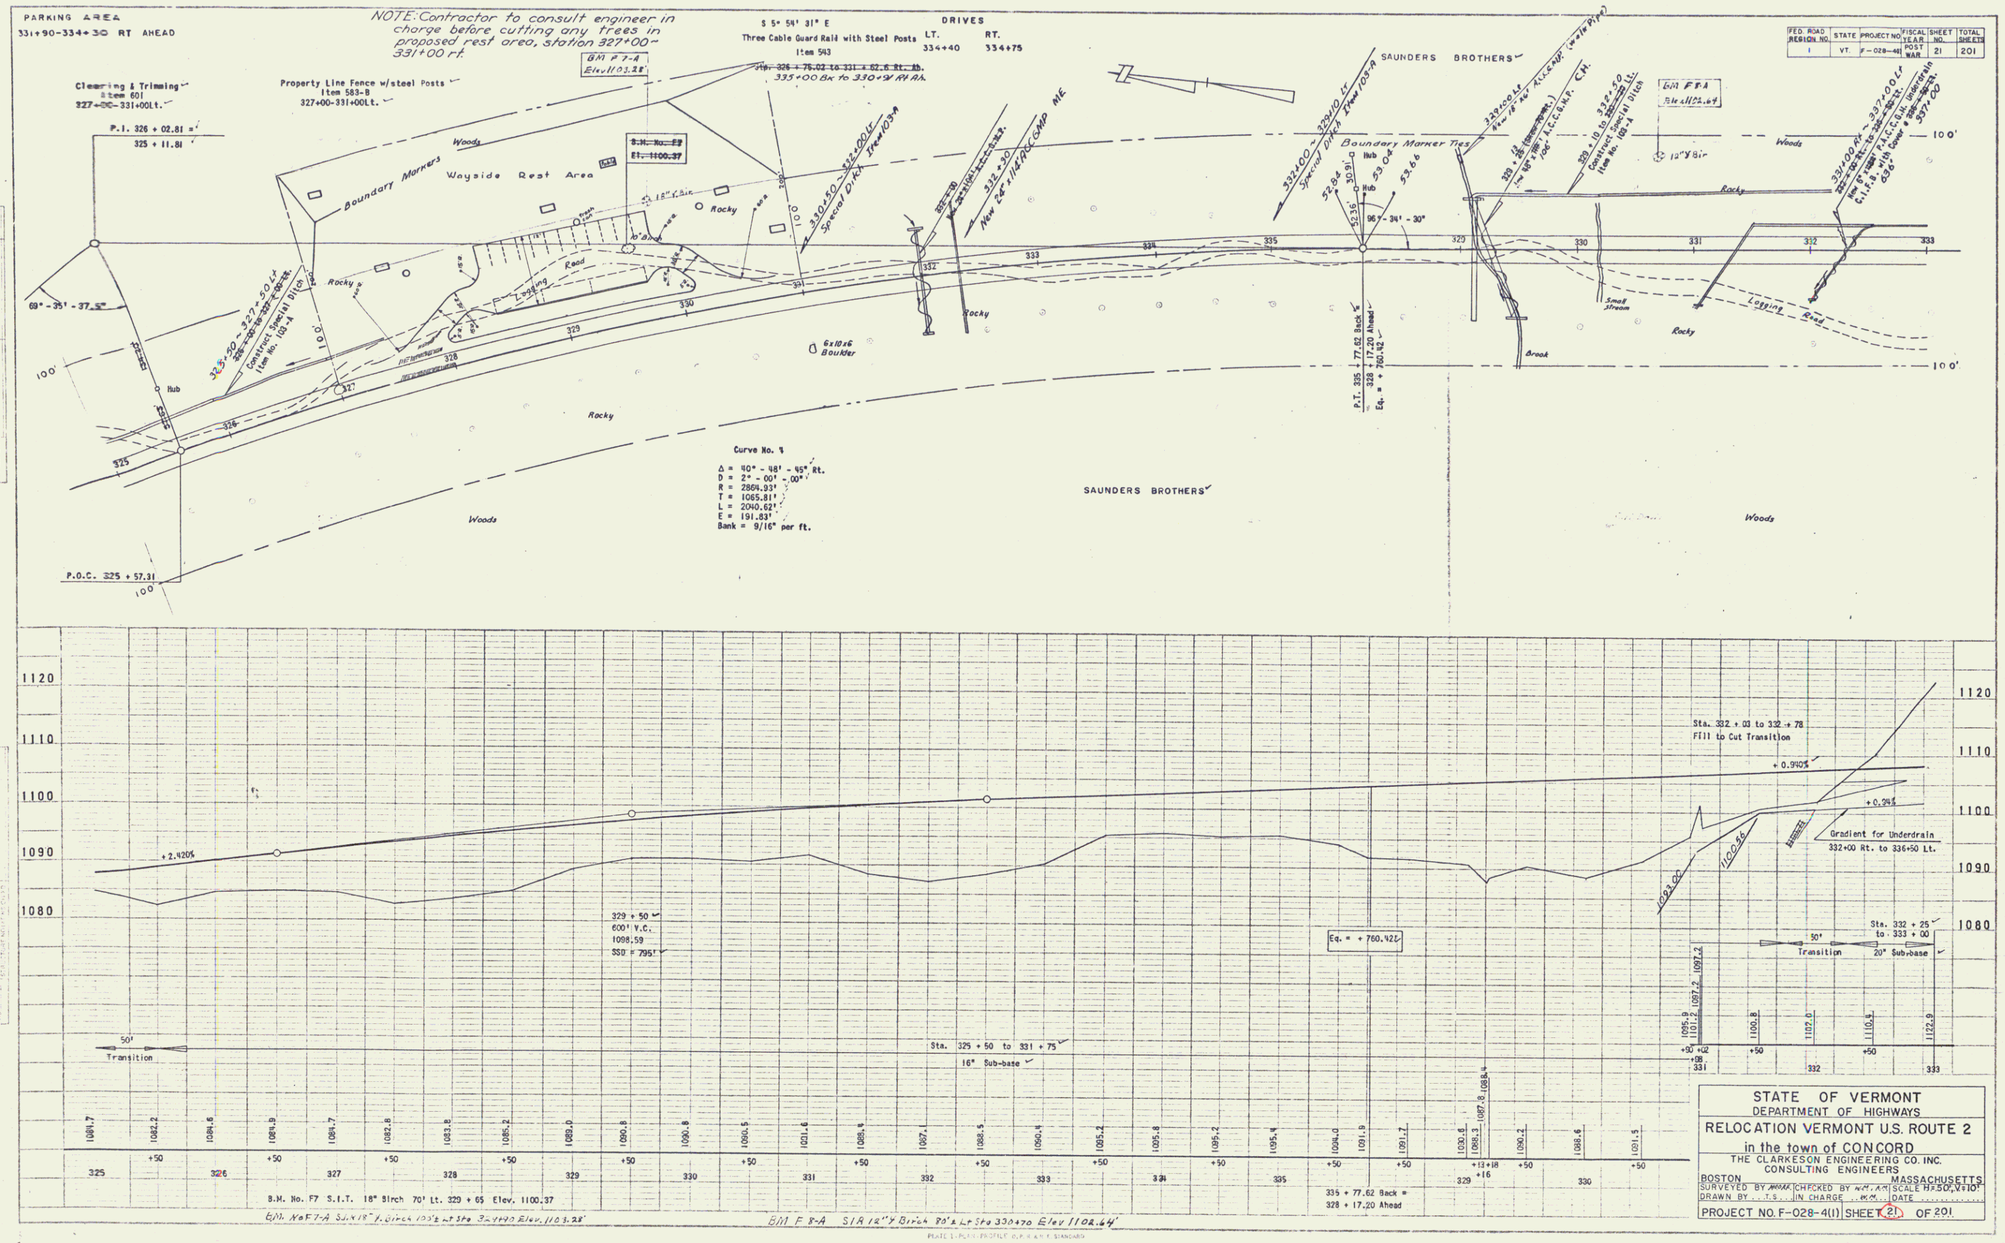

STATE OF VERMONT
DEPARTMENT OF HIGHWAYS
RELOCATION VERMONT U.S. ROUTE 2
in the town of CONCORD
THE CLARKESON ENGINEERING CO. INC.
CONSULTING ENGINEERS
BOSTON MASSACHUSETTS
SURVEYED BY [illegible] CHECKED BY [illegible] SCALE H:1"=50', V:1"=10'
DRAWN BY T.S. IN CHARGE [illegible] DATE
PROJECT NO. F-028-4(1) SHEET 21 OF 201

PLATE I-PLAN-PROFILE O.P.R.&R.V. STANDARD
KEUFFEL & ESSER CO. NEW YORK
K.S.E. Co. No. 340-10
2-54

15