FFA ROAD REGION NO.	STATE	PROJECT NO.	FISCAL YEAR	SHEET NO.	TOTAL SHEETS
1	VT.	F-028-4(1)	POST WAR	23	201

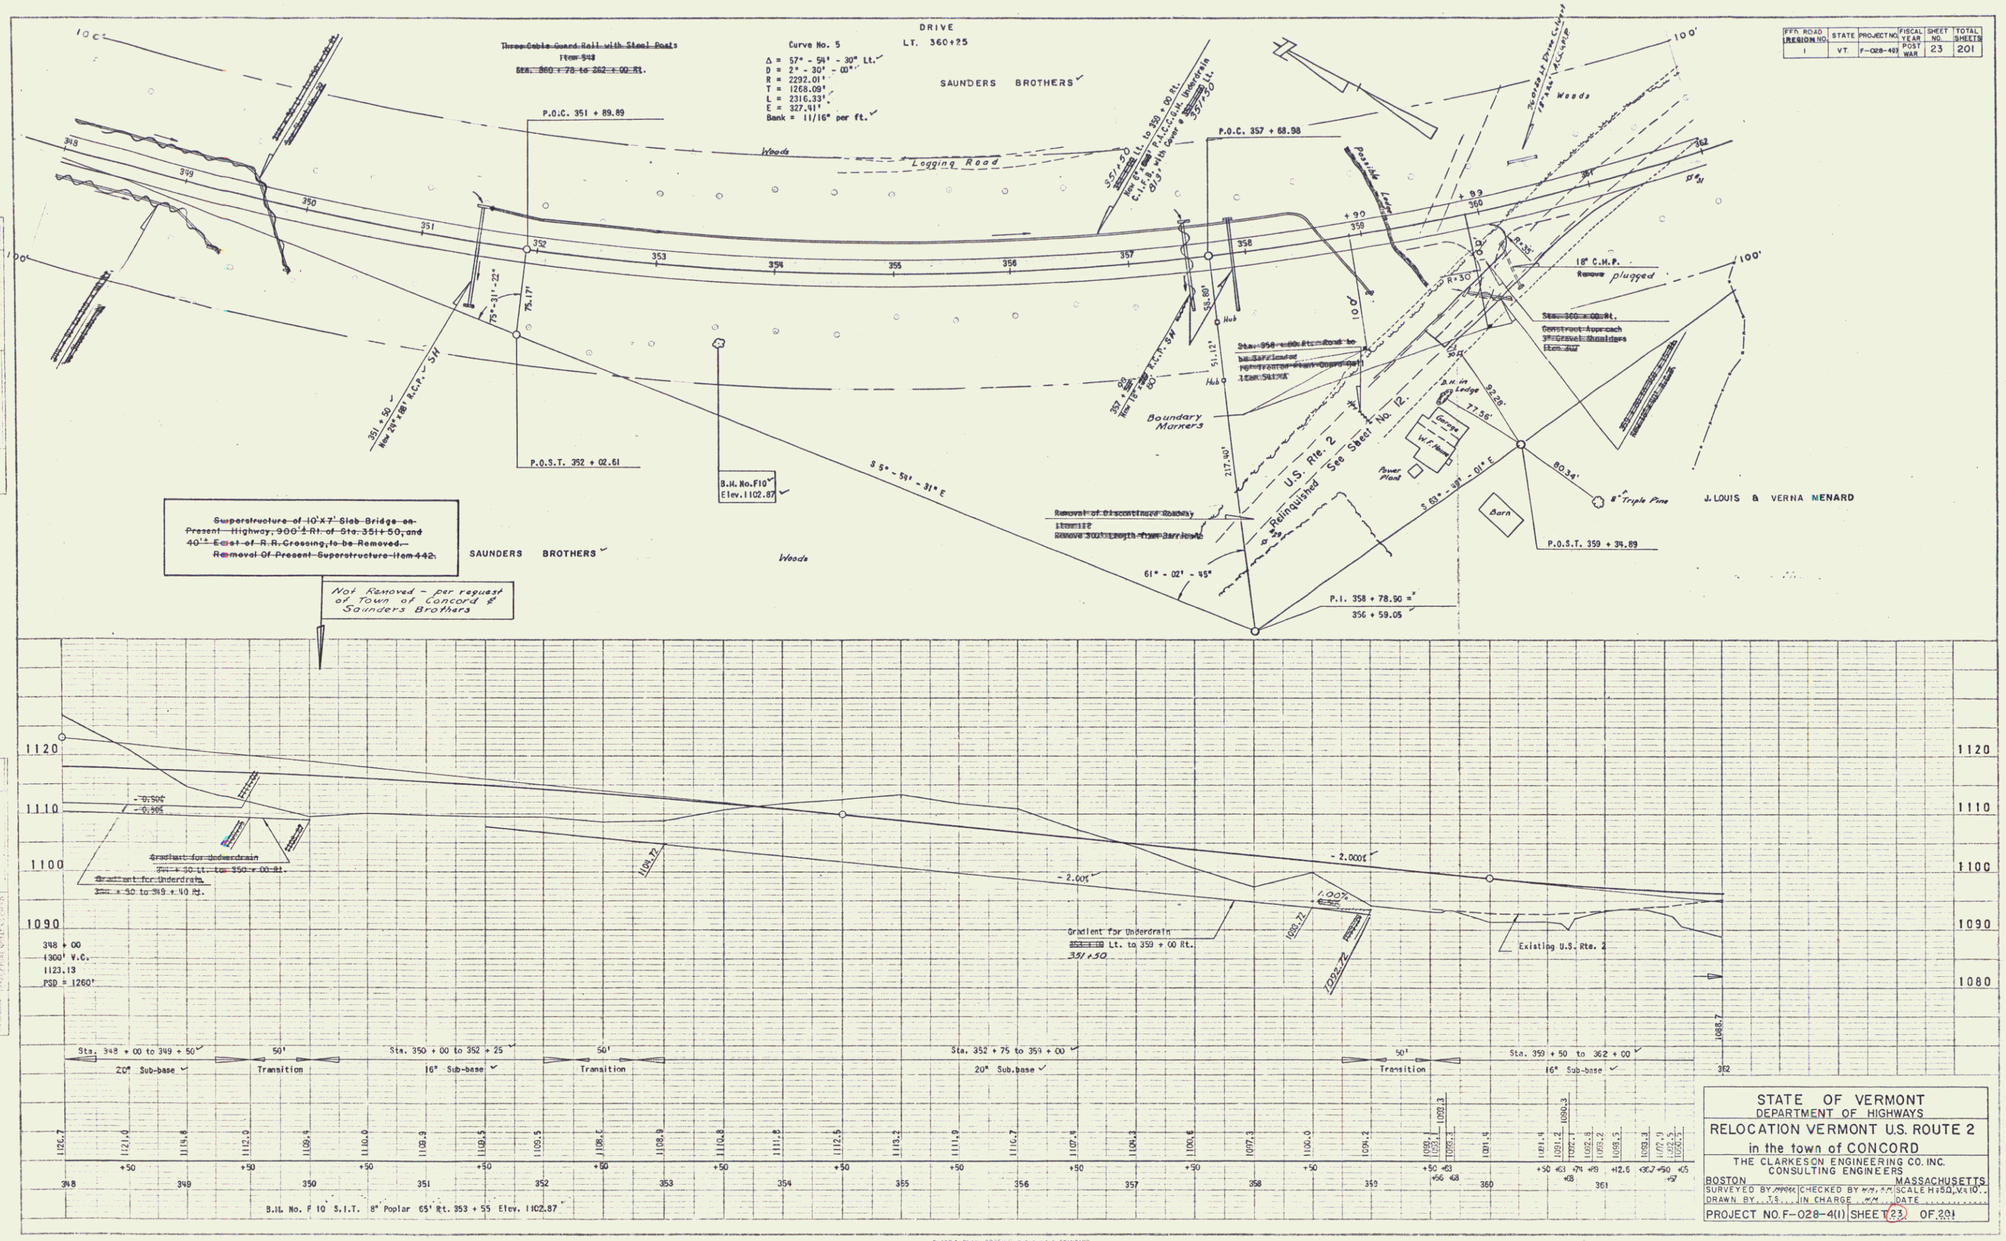

STATE OF VERMONT
DEPARTMENT OF HIGHWAYS
RELOCATION VERMONT U.S. ROUTE 2
in the town of CONCORD
THE CLARKESON ENGINEERING CO. INC.
CONSULTING ENGINEERS
BOSTON MASSACHUSETTS
SURVEYED BY MOORE CHECKED BY W.M. SCALE H 50, V 10
DRAWN BY T.S. IN CHARGE W.M. DATE
PROJECT NO. F-028-4(1) SHEET 23 OF 201

15