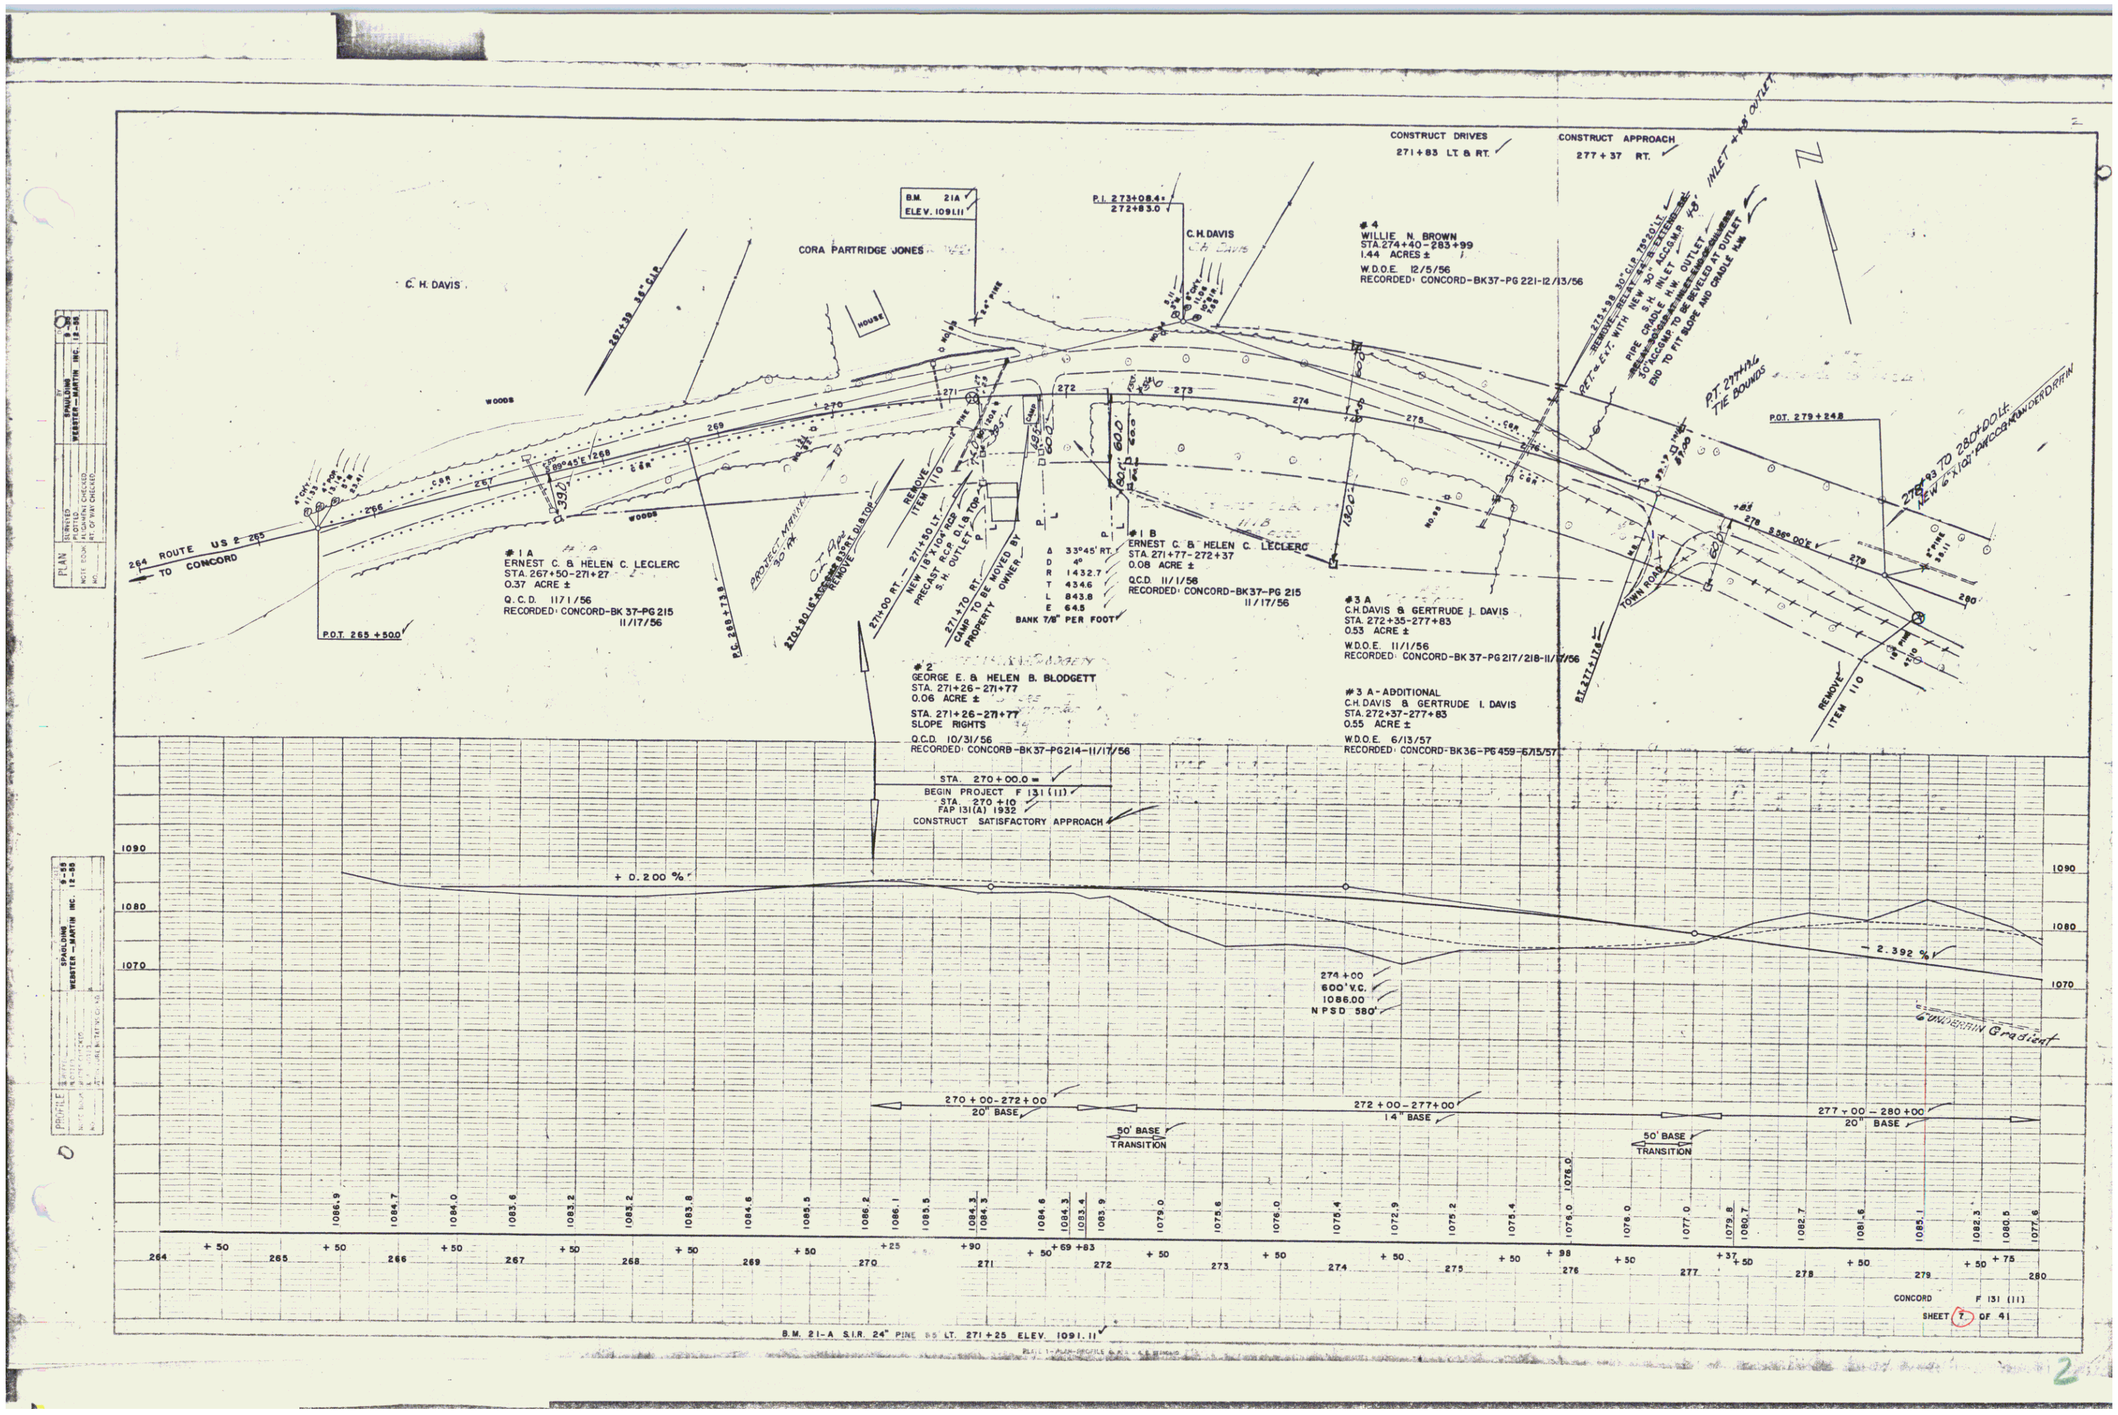
PLAN
PROFILE
SPAULDING
WEBSTER-MARTIN INC.
ROUTE US 2 265
TO CONCORD
P.O.T. 265 + 500
C. H. DAVIS
CORA PARTRIDGE JONES
HOUSE
WOODS
B.M. 21A
ELEV. 1091.11
P.I. 273+08.4
272+83.0
C.H. DAVIS
#1 A
ERNEST C. & HELEN C. LECLERC
STA. 267+50-271+27
0.37 ACRE ±
Q.C.D. 11/1/56
RECORDED: CONCORD-BK 37-PG 215
11/17/56
#1 B
ERNEST C. & HELEN C. LECLERC
STA. 271+77-272+37
0.08 ACRE ±
Q.C.D. 11/1/56
RECORDED: CONCORD-BK37-PG 215
11/17/56
#2
GEORGE E. & HELEN B. BLODGETT
STA. 271+26-271+77
0.06 ACRE ±
STA. 271+26-271+77
SLOPE RIGHTS
Q.C.D. 10/31/56
RECORDED: CONCORD-BK37-PG214-11/17/56
#3 A
C.H. DAVIS & GERTRUDE J. DAVIS
STA. 272+35-277+83
0.53 ACRE ±
W.D.O.E. 11/1/56
RECORDED: CONCORD-BK 37-PG 217/218-11/17/56
#3 A-ADDITIONAL
C.H. DAVIS & GERTRUDE I. DAVIS
STA. 272+37-277+83
0.55 ACRE ±
W.D.O.E. 6/13/57
RECORDED: CONCORD-BK36-PG 459-6/15/57
#4
WILLIE N. BROWN
STA. 274+40-283+99
1.44 ACRES ±
W.D.O.E. 12/5/56
RECORDED: CONCORD-BK37-PG 221-12/13/56
CONSTRUCT DRIVES
271+83 LT. & RT.
CONSTRUCT APPROACH
277+37 RT.
REMOVE ITEM 110
TOWN ROAD
P.O.T. 279+24.8
STA. 270+00.0 =
BEGIN PROJECT F 131 (11)
STA. 270+10
FAP 131(A) 1932
CONSTRUCT SATISFACTORY APPROACH
+ 0.200 %
- 2.392 %
274+00
600' V.C.
1086.00
N P S D 580'
Gradient
270+00-272+00
20" BASE
272+00-277+00
14" BASE
277+00-280+00
20" BASE
50' BASE TRANSITION
B.M. 21-A S.I.R. 24" PINE 55 LT. 271+25 ELEV. 1091.11
CONCORD
F 131 (11)
SHEET 7 OF 41