Parcel	Kind of Instrument	Date of Instrument	Grantor	Grantee	Recorded Lunenburg Book	Page	Date	Remarks
Culv. #1 & 3	Q.C.D	12-28-32	W.L. & M.S. Rowell	St. of Vt.	14A	32A	1-11-33	Culv. Sta. 164+7 / 171+68A

131 C 1932 16 68

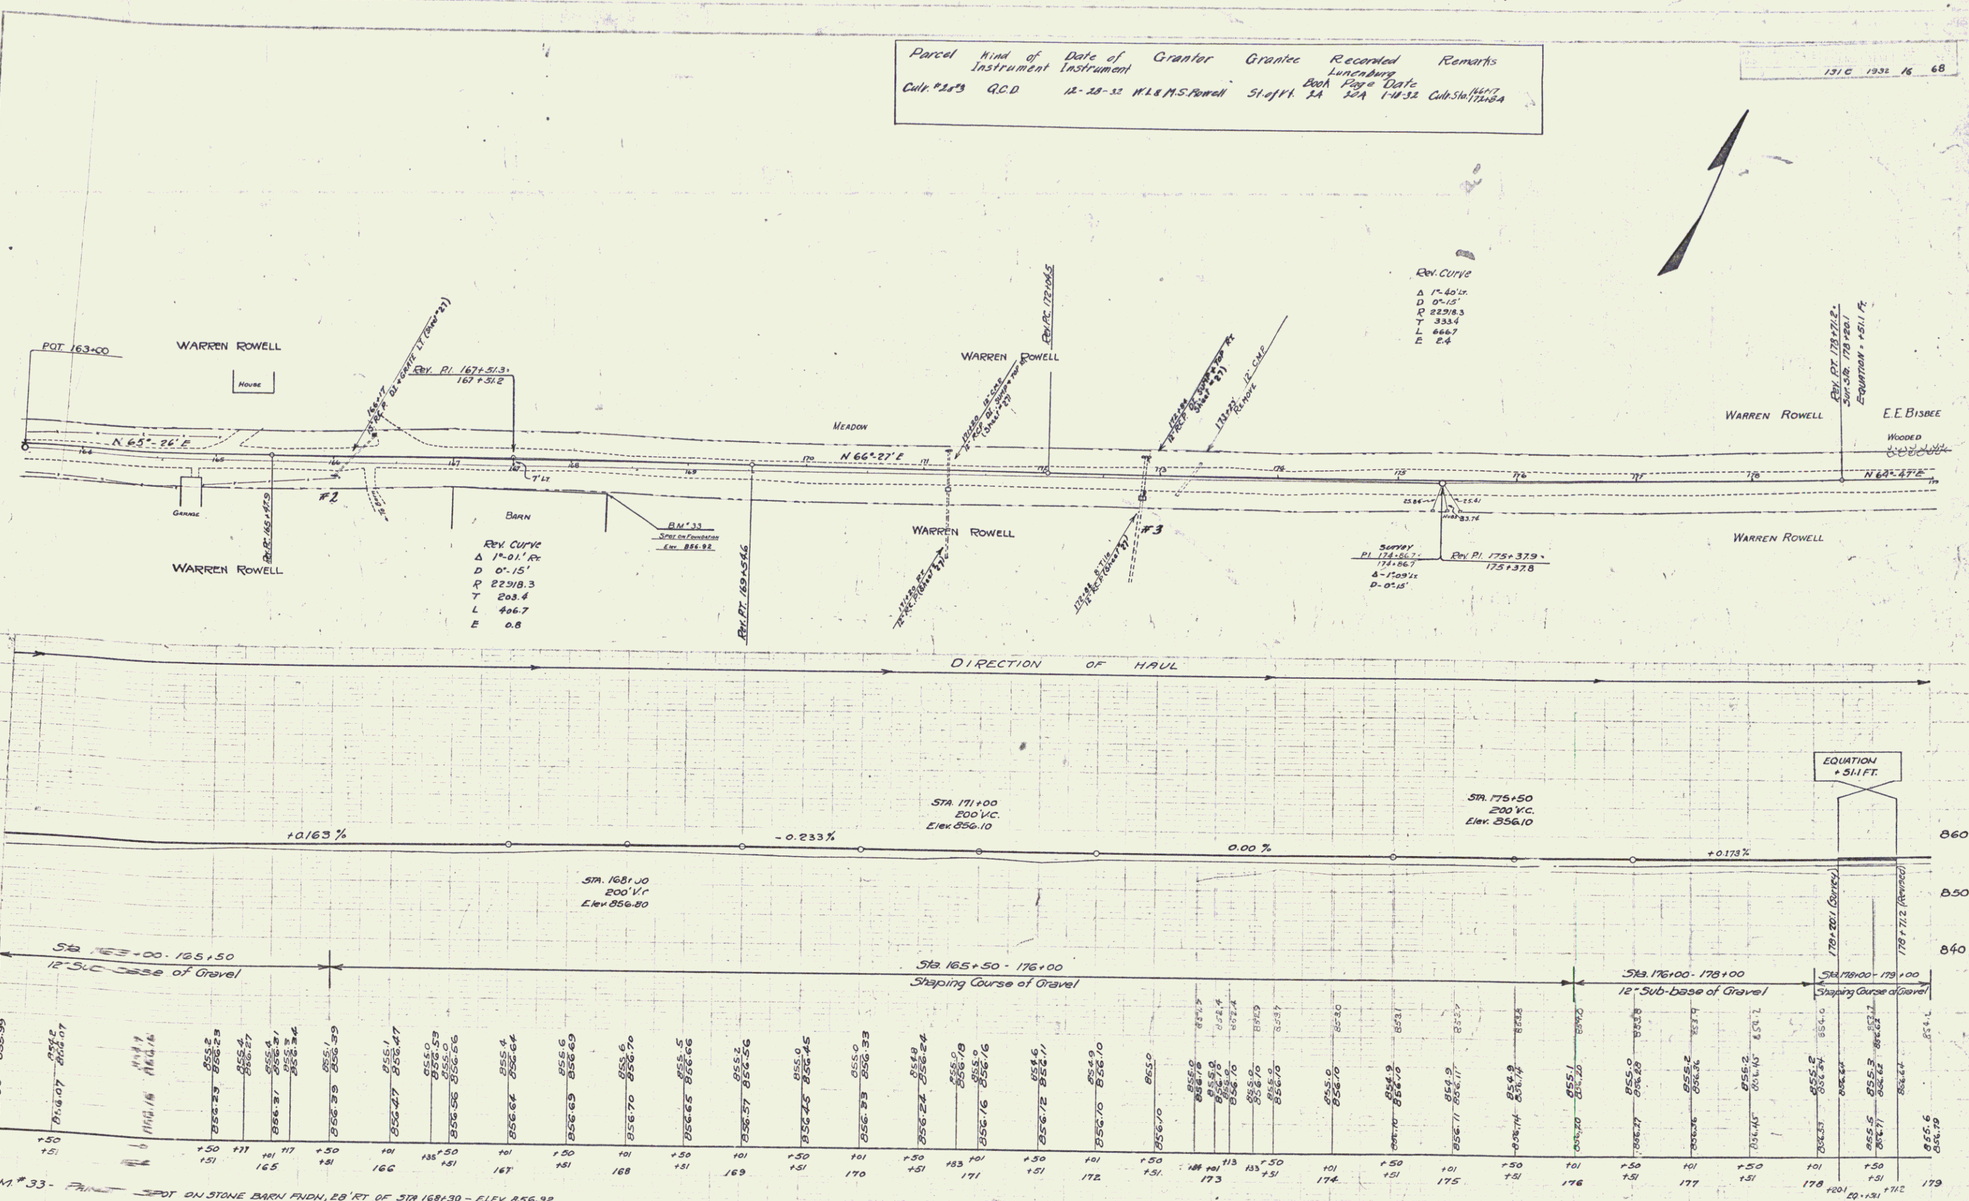

14