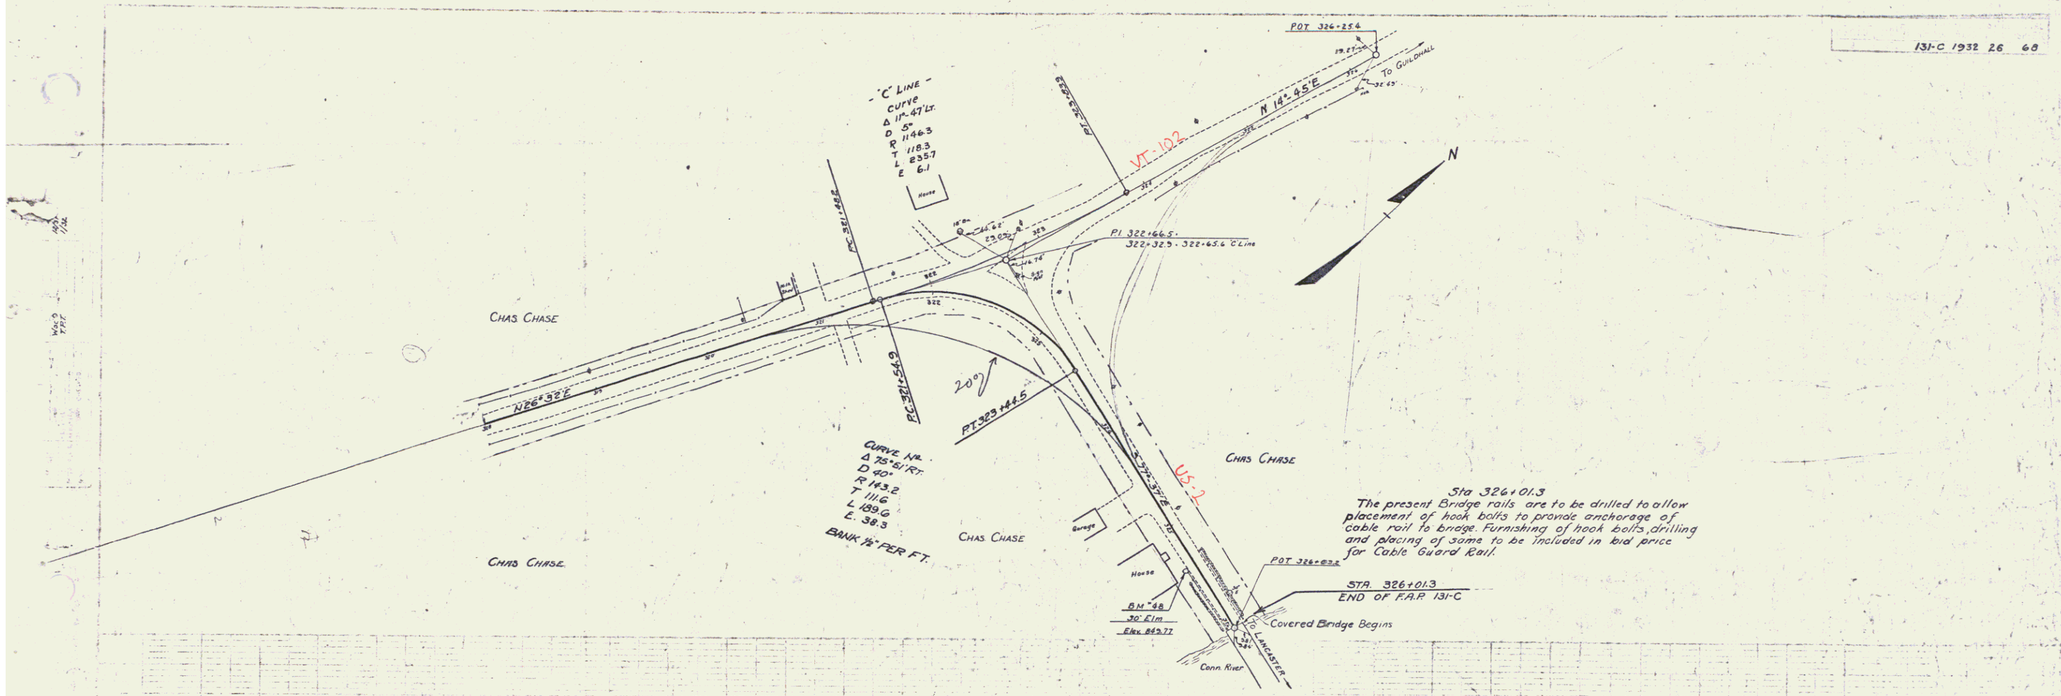

The present Bridge rails are to be drilled to allow placement of hook bolts to provide anchorage of cable rail to bridge. Furnishing of hook bolts, drilling and placing of same to be included in bid price for Cable Guard Rail.

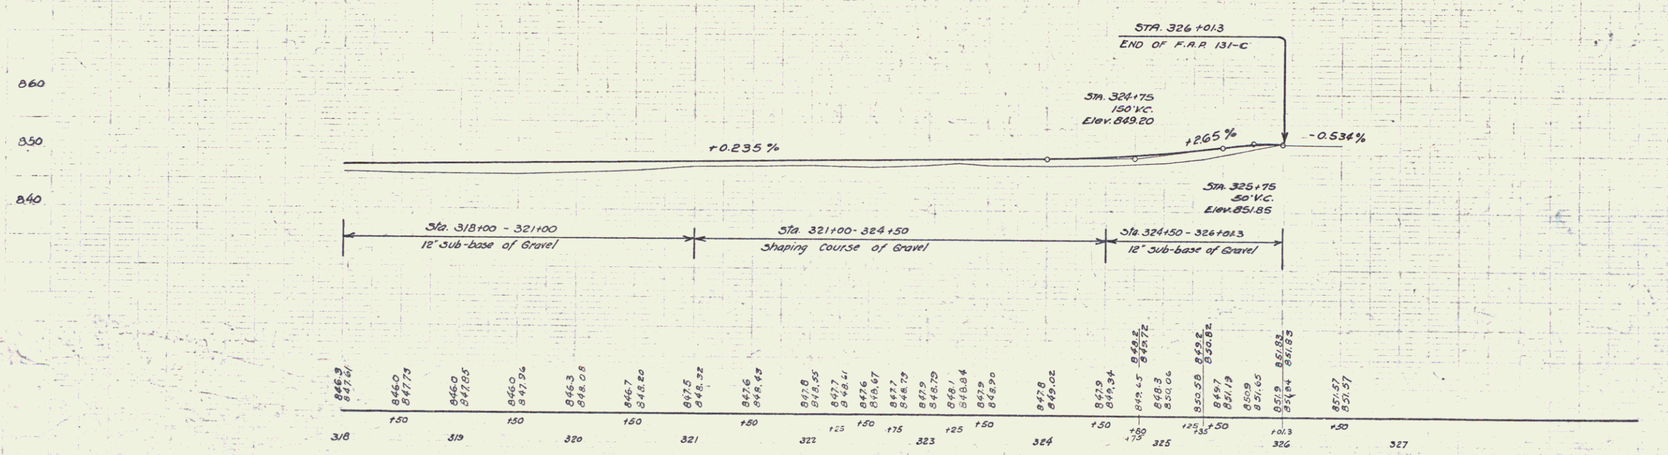

B.M. #48 - SPIKE IN ROOT OF 30" ELM, 8' RT. OF STA. 325+40 - ELEV. 849.77

U.S.G.S. B.M. ON GRANITE STEPS OF COURT HOUSE, LANCASTER, N.H. ELEV. 863.61

L.P.P. 11-10-31
J.E.F. - L.A.R. 11-1-31