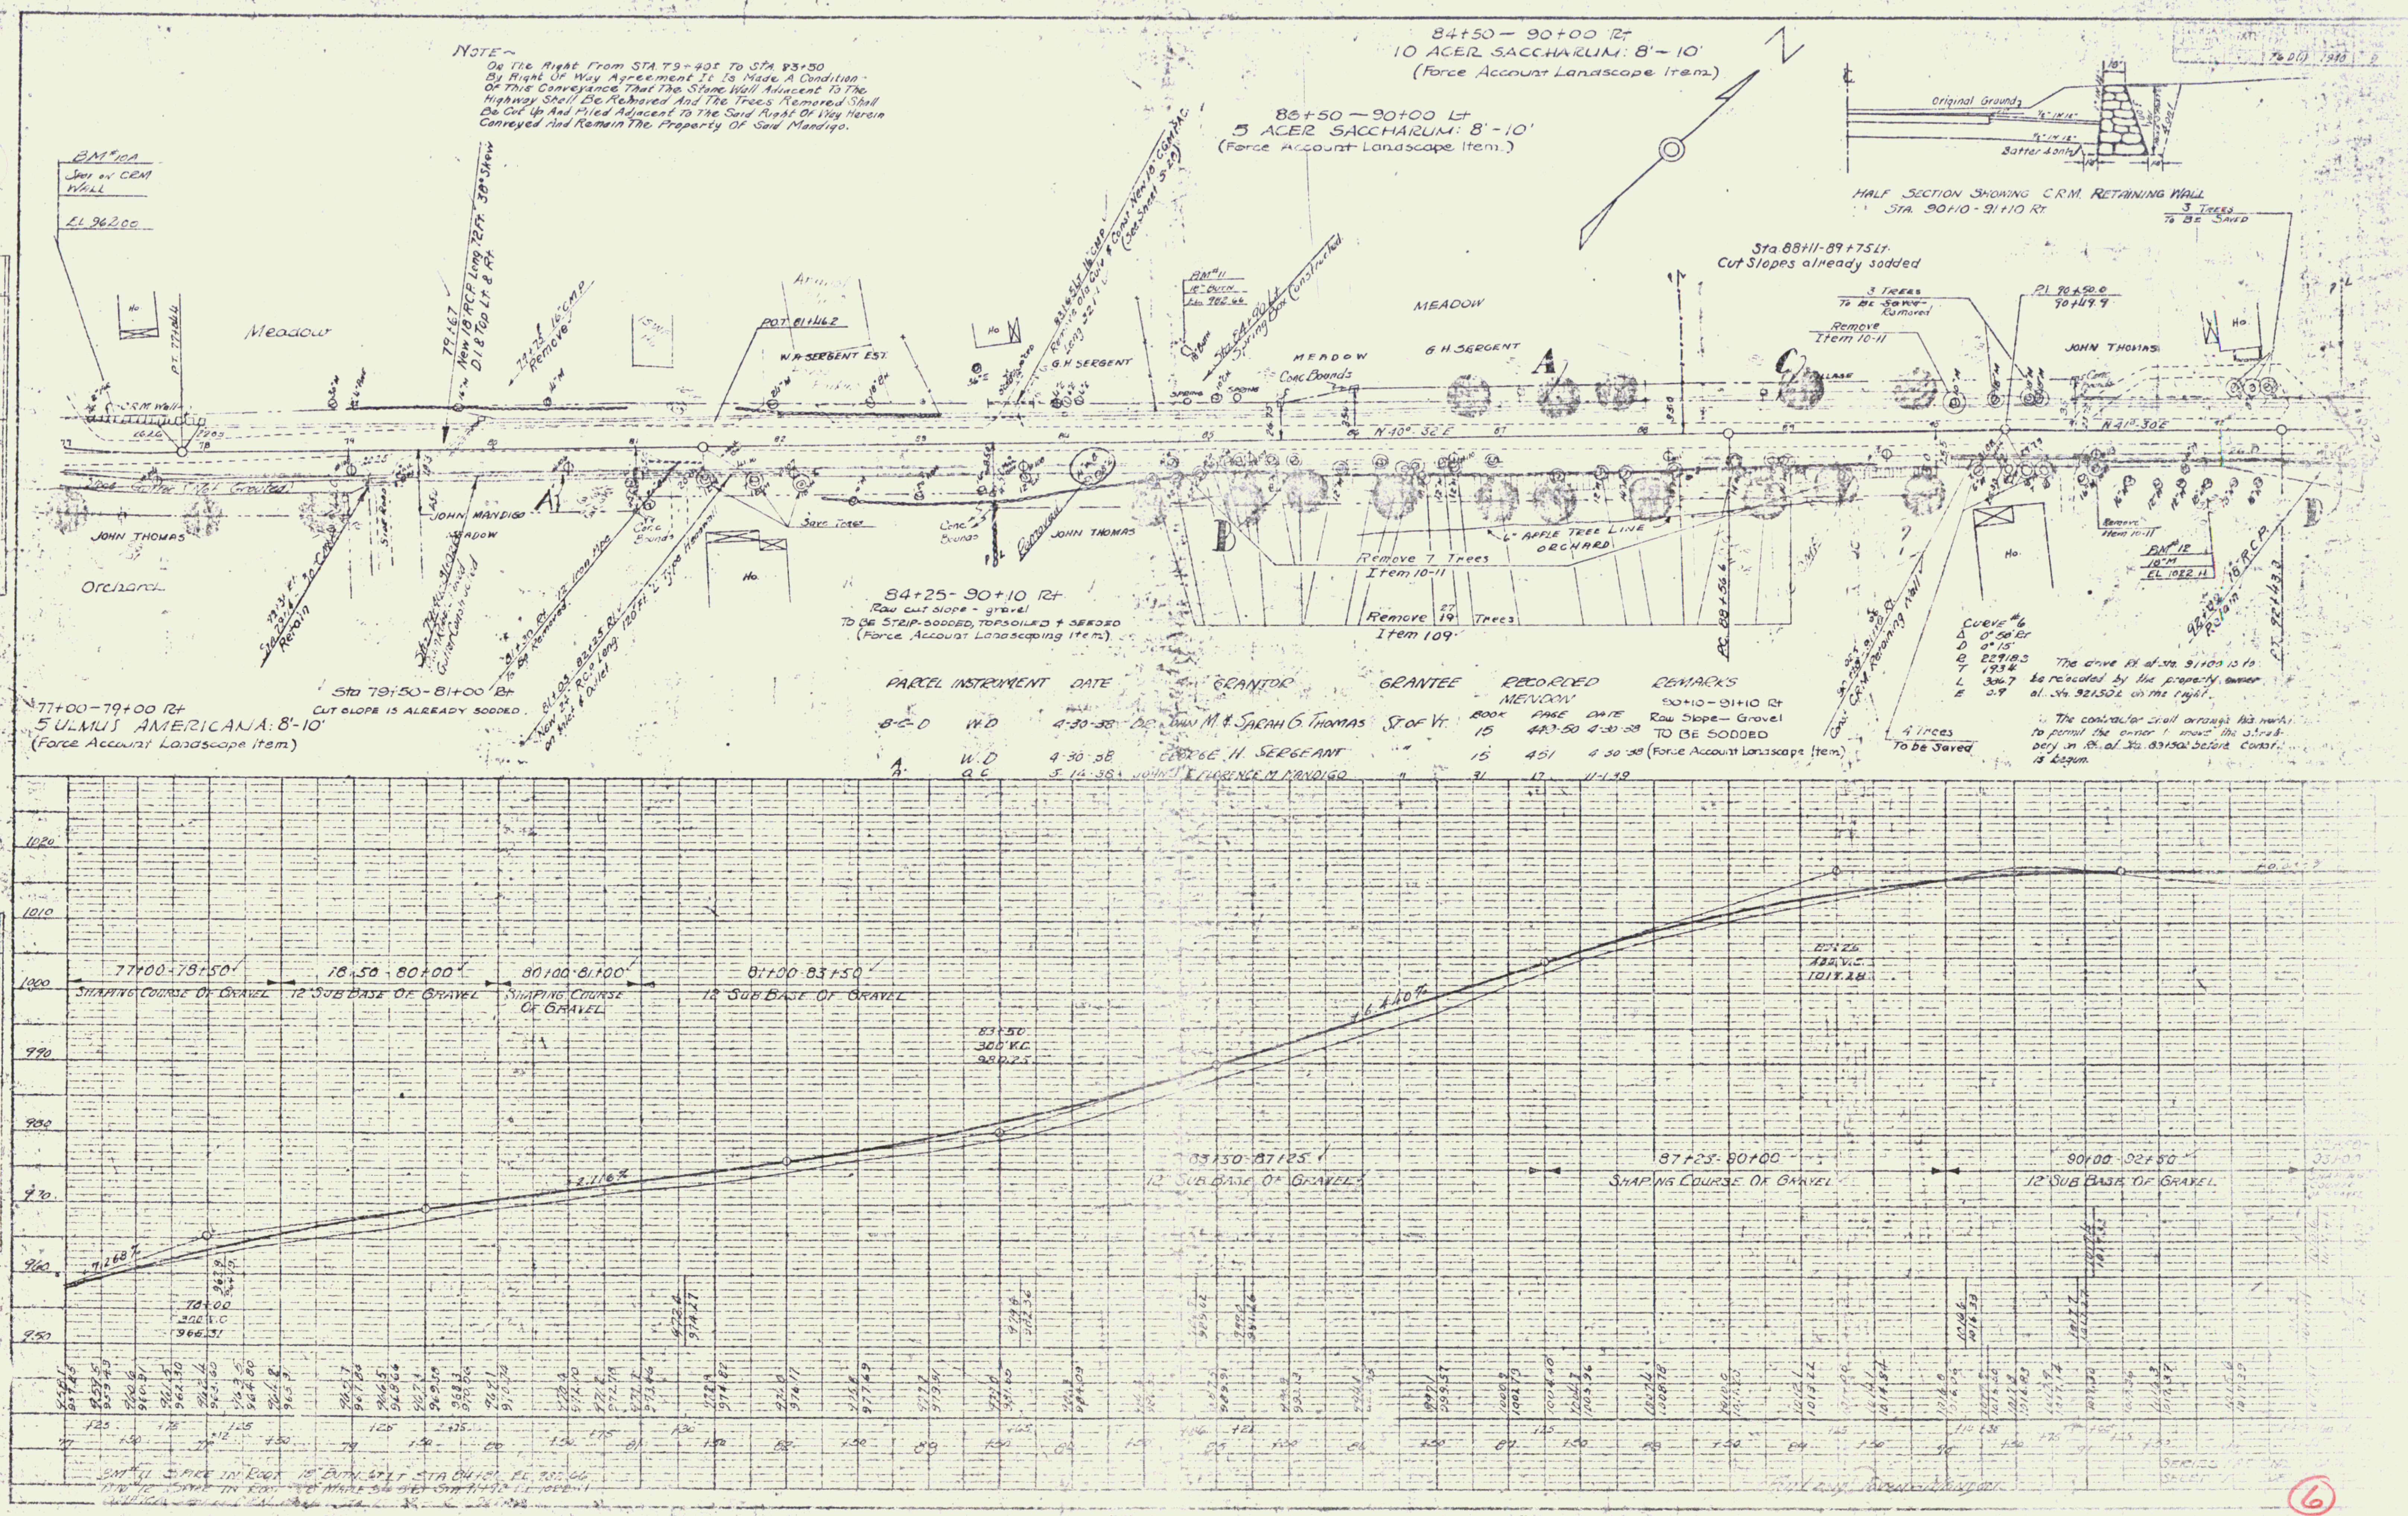

BM#10A
Spot on CRM Wall
EL 962.00
Meadow
PT. 77+04.4
C.R.M. Wall
JOHN THOMAS
Orchard
Gutter "Not Grouted"
79+67 New 18" R.C.P. Long 72 Ft. 38° Skew D.I. 8 Top Lt. & Rt.
79+75 16" C.M.P. Remove
JOHN MANDIGO
MEADOW
A
Sta 79+31 Rt 30" C.M. Retain
Sta 79+40-81+00 Rt Gutter Constructed
81+30 Rt 12" Iron Pipe To Be Removed
81+03-82+25 Rt New 24" R.C.P. Long 120 Ft. "L" Type Headwall on Inlet & Outlet
Conc Bounds
P.O.T. 81+46.2
W. A. SERGENT EST.
Save Trees
Ho.
83+65 Lt 16" C.M.P. Remove Old Culv. & Const. New 18" C.G.M.P.A.C. Leng 32 Ft (See Sheet 5-20)
G. H. SERGENT
BM#11 18" BUTN El. 982.66
Sta. 84+90 Lt Spring Box Constructed
MEADOW
Conc Bounds
SPRING
Removed
JOHN THOMAS
N 40° 32' E
G. H. SERGENT
A
B
Remove 7 Trees Item 10-11
6" Apple Tree Line ORCHARD
Remove 27/19 Trees Item 109
P.C. 88+56.6
C
Remove Item 10-11
3 Trees To Be ~~Saved~~ Removed
P.I. 90+50.0 90+49.9
JOHN THOMAS
Ho.
3 Trees To Be Saved
N 41° 30' E
Remove Item 10-11
BM#12 18" M EL 1022.11
92+20 18" R.C.P. Retain
P.T. 92+43.3
D
Const. C.R.M. Retaining Wall 90+10-91+10 Rt.
4 Trees To be Saved
Original Ground
Batter 4 on 1
HALF SECTION SHOWING C.R.M. RETAINING WALL STA. 90+10 - 91+10 Rt.
76 D(1) 1940
1020
1010
1000
990
980
970
960
950
+1.268%
78+00 300' V.C. 966.31
+2.116%
83+50 300' V.C. 980.25
+6.440%
87+25 400' V.C. 1017.28
77+00-78+50 SHAPING COURSE OF GRAVEL
78+50-80+00 12" SUB BASE OF GRAVEL
80+00-81+00 SHAPING COURSE OF GRAVEL
81+00-83+50 12" SUB BASE OF GRAVEL
83+50-87+25 12" SUB BASE OF GRAVEL
87+25-90+00 SHAPING COURSE OF GRAVEL
90+00-92+50 12" SUB BASE OF GRAVEL
77
78
79
80
81
82
83
84
85
86
87
88
89
90
91
BM#11 Spike in Root 18" Butn. 51' Lt Sta 84+60 El. 982.66
BM#12 Spike in Root 18" Maple 54' Rt Sta 91+92 El. 1022.11
PLAN
PROFILE

NOTE—
On The Right From STA. 79+40± To STA. 83+50 By Right Of Way Agreement It Is Made A Condition Of This Conveyance That The Stone Wall Adjacent To The Highway Shall Be Removed And The Trees Removed Shall Be Cut Up And Piled Adjacent To The Said Right Of Way Herein Conveyed And Remain The Property Of Said Mandigo.

77+00—79+00 Rt
5 ULMUS AMERICANA: 8'-10'
(Force Account Landscape Item)

Sta 79+50-81+00 Rt
CUT SLOPE IS ALREADY SODDED.

84+25-90+10 Rt
Raw cut slope - gravel
TO BE STRIP-SODDED, TOPSOILED & SEEDED
(Force Account Landscaping Item)

84+50— 90+00 Rt
10 ACER SACCHARUM: 8'—10'
(Force Account Landscape Item)

88+50—90+00 Lt
5 ACER SACCHARUM: 8'-10'
(Force Account Landscape Item)

Sta. 88+11-89+75 Lt.
Cut Slopes already sodded

PARCEL	INSTRUMENT	DATE	GRANTOR	GRANTEE	RECORDED MENDON BOOK	PAGE	DATE
B-C-D	W.D	4-30-38	Dr. John M. & Sarah G. Thomas	St. of Vt.	15	449-50	4-30-38
A	W.D	4-30-38	George H. Sergeant	"	15	451	4-30-38
A	Q.C	5-14-38	John & Florence M. Mandigo	"	31	17	11-1-39

REMARKS
90+10—91+10 Rt
Raw Slope— Gravel
TO BE SODDED
(Force Account Landscape Item)

Curve #6
Δ 0° 58' Rt
D 0° 15'
R 22918.3
T 193.4
L 386.7
E 0.9

The drive Rt. at Sta. 91+00 is to be relocated by the property owner at Sta. 92+50± on the right.

The contractor shall arrange his work to permit the owner to move the shrubbery on Rt. at Sta. 83+50± before Const. is begun.

⑥

8