WOOD GUARD RAIL REQUIRED		
CULVERT STATION	LEFT	RIGHT
52 +35	24'	—
53 +75	24'	24'

CABLE GUARD RAIL REQUIRED		
STATION	LEFT	RIGHT
52+33 to 54+30	—	208'
53+74 " 55+14	120'	—

NEW CORRUGATED GALVANIZED METAL PIPE CULVERTS REQUIRED					
STATION	DIAM.	LENGTH	CONC. A	REINF. STEEL	CEM. PUG. MASONRY
53 + 75	24"	40'	—	—	4.0 c.y.
52 +35	18"	44'	—	—	3.3 "

NEW REINF. CONC. BOX CULVERTS REQUIRED			
STATION	SIZE	CONC. A	REINF. STEEL
54+18	5'x6'	43.0 c.y.	3231 lbs.
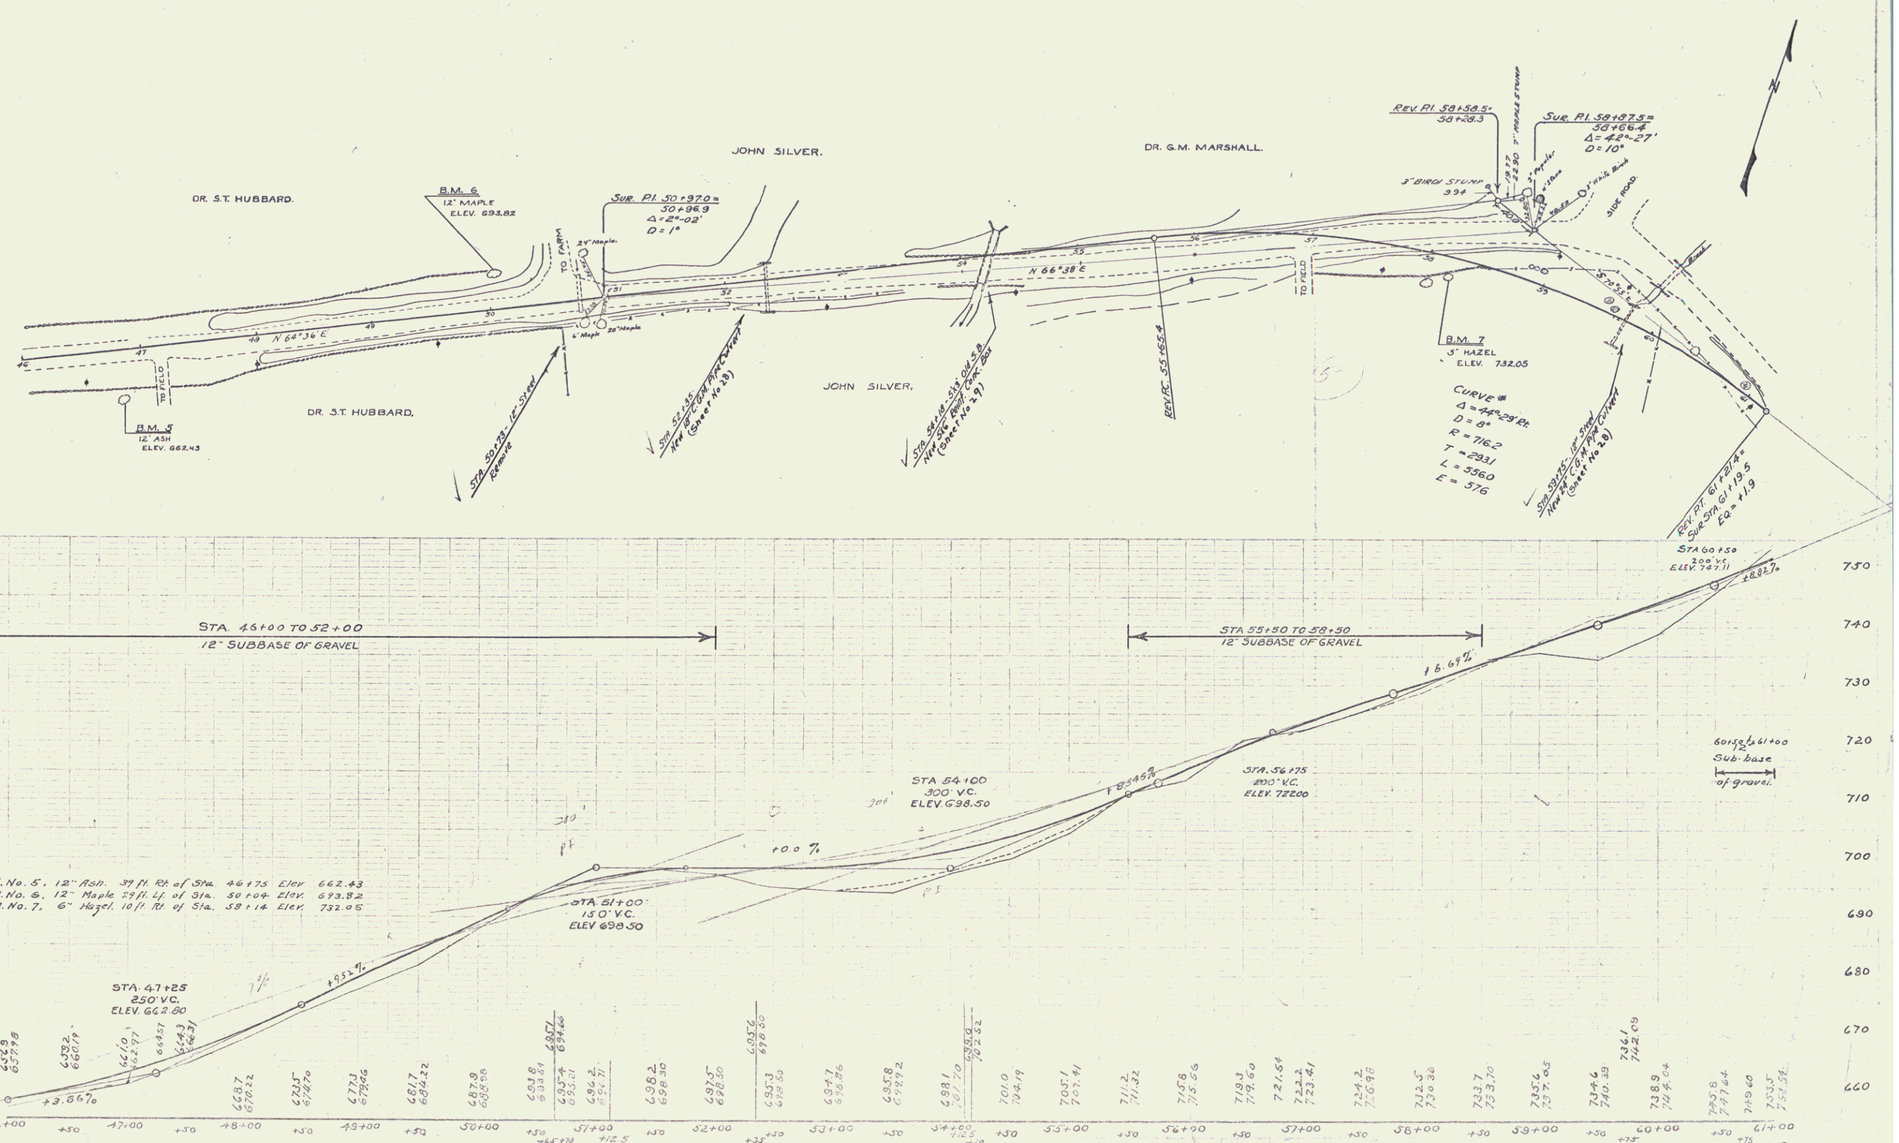
STATE	FEDERAL PROJECT NO.	SHEET NO.	TOTAL SHEETS
		76-B 1930	16 69