WOOD GUARD RAIL REQUIRED

CULVERT STATION	LEFT	RIGHT
92 + 28	24'	24'

NEW REINF. CONC. BOX CULVERT'S REQUIRED

STATION	SIZE	CONC. A	REINF. STEEL
92+28	3x3'	16.0 c.y.	1066 lbs

76-B 1930 19 69

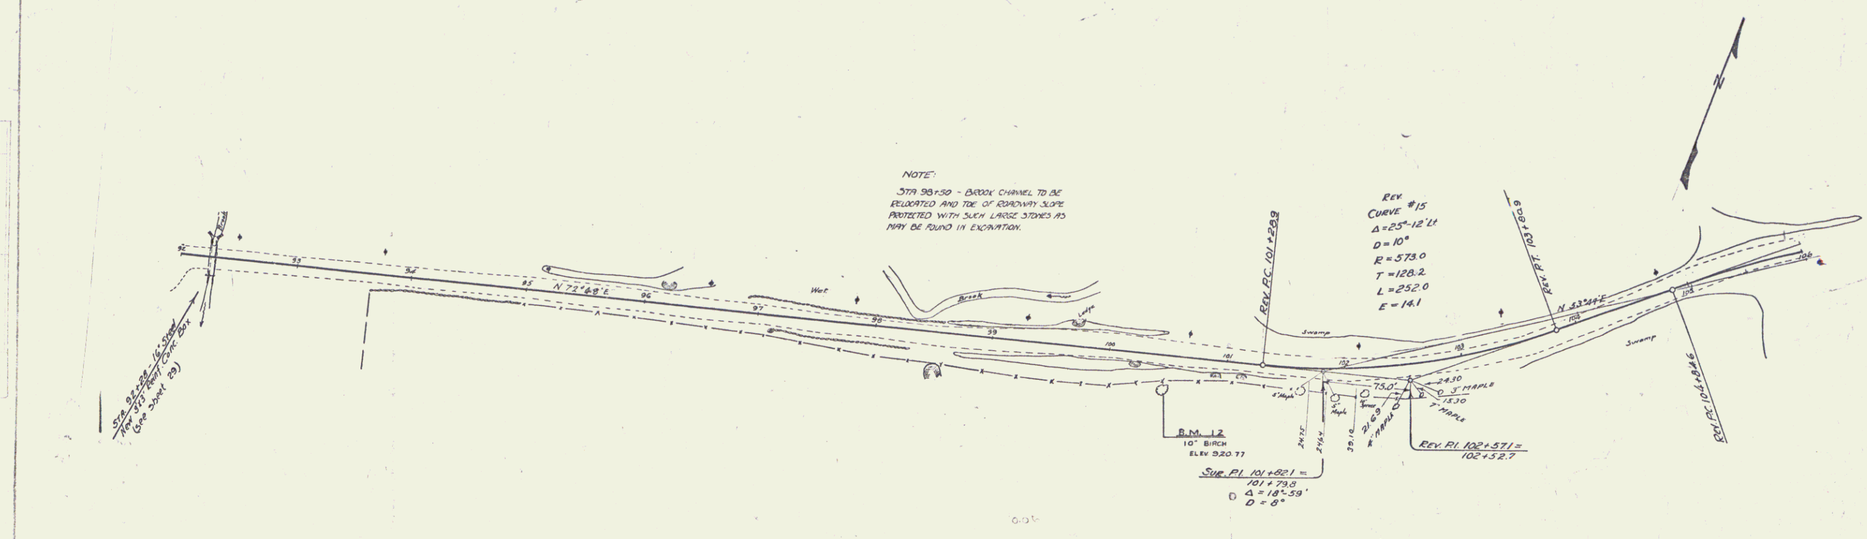

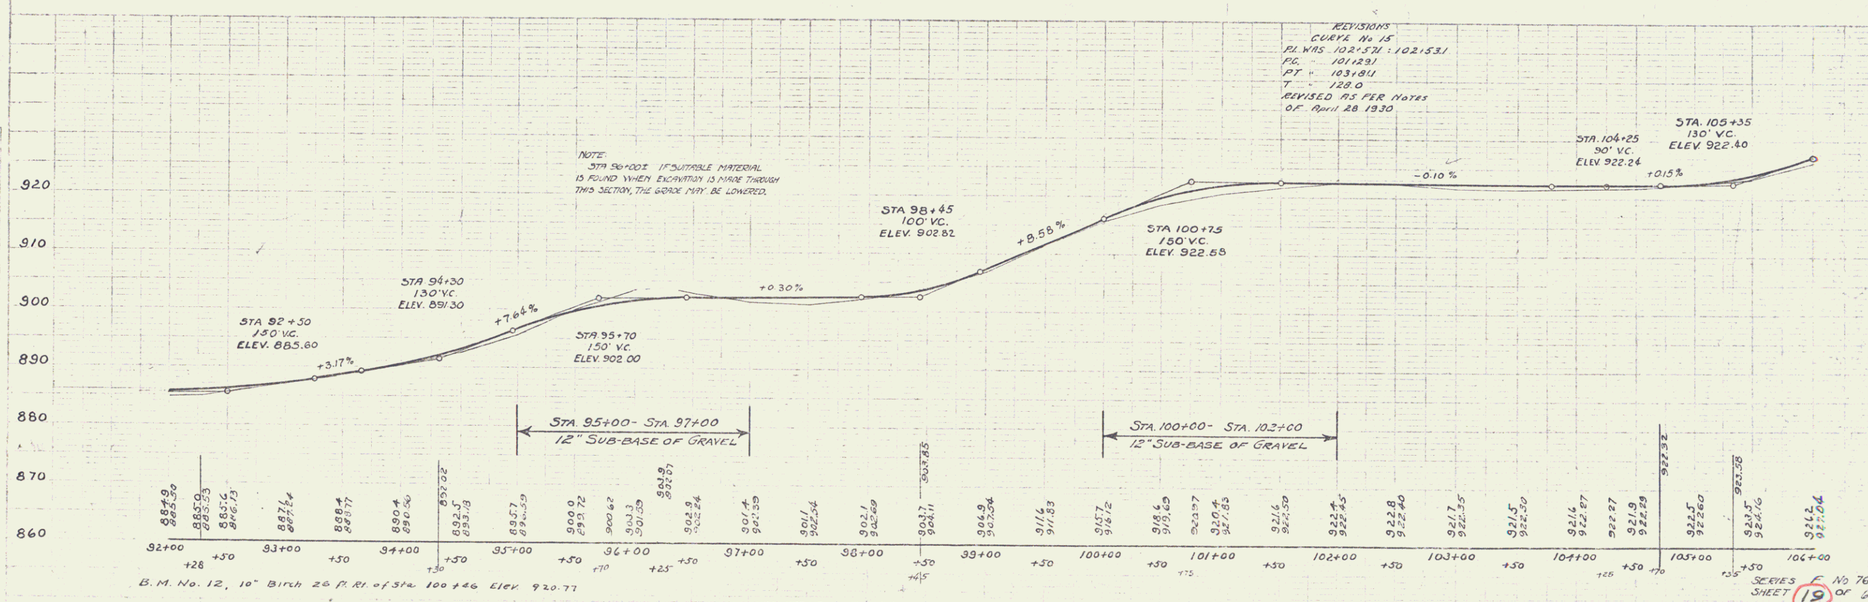

SERIES C No 76-B
SHEET 19 OF 69

7