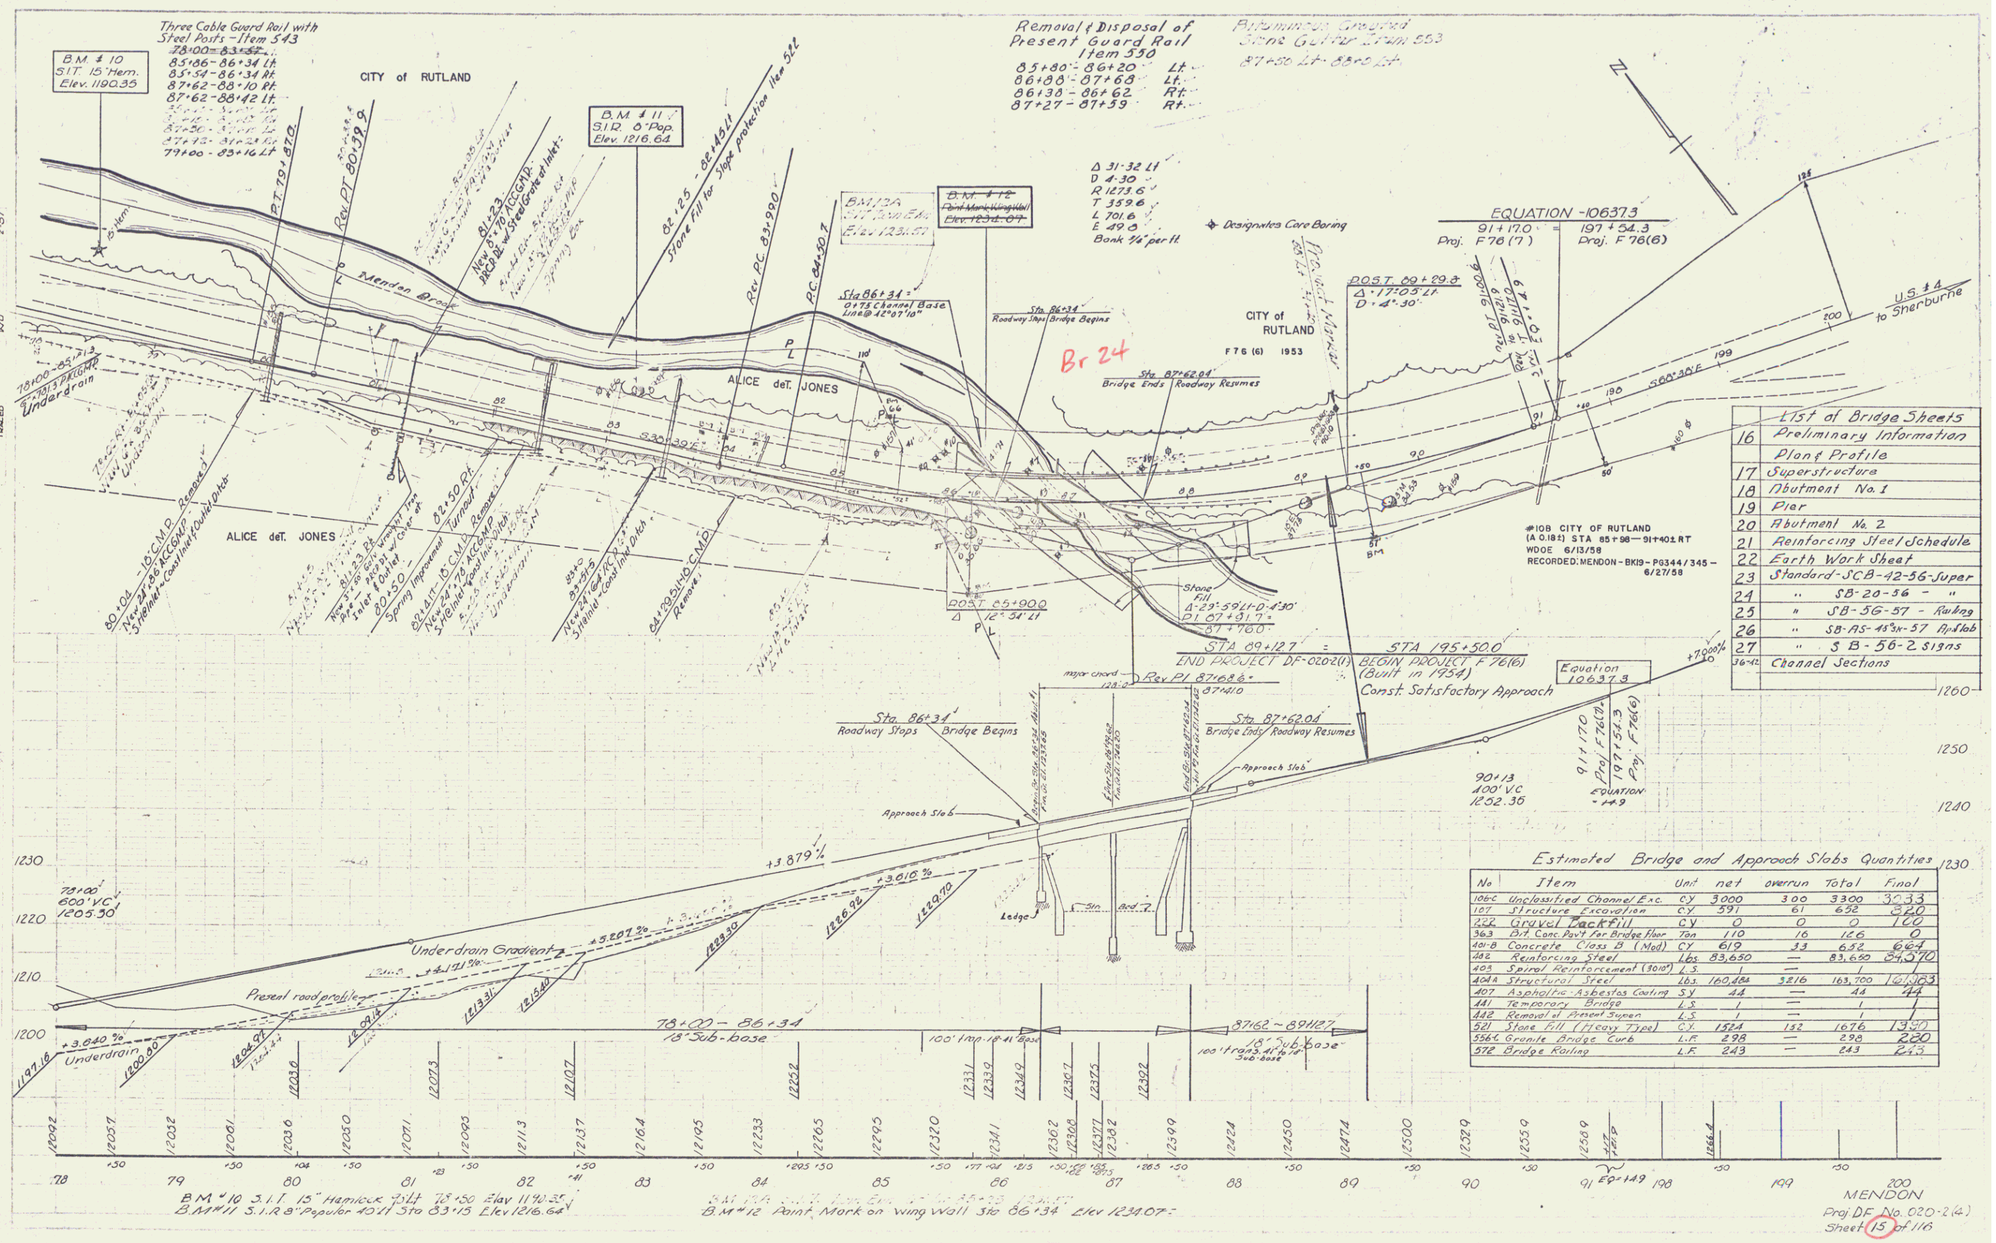


| | List of Bridge Sheets |
|---|---|
| 16 | Preliminary Information |
| | Plan & Profile |
| 17 | Superstructure |
| 18 | Abutment No. 1 |
| 19 | Pier |
| 20 | Abutment No. 2 |
| 21 | Reinforcing Steel Schedule |
| 22 | Earth Work Sheet |
| 23 | Standard-SCB-42-56-Super |
| 24 | " SB-20-56 - " |
| 25 | " SB-5G-57 - Railing |
| 26 | " SB-AS-45°Sk-57 Ap. Slab |
| 27 | " S B-56-2 Signs |
| 36-42 | Channel Sections |

Estimated Bridge and Approach Slabs Quantities

| No | Item | Unit | net | overrun | Total | Final |
|---|---|---|---|---|---|---|
| 10b-C | Unclassified Channel Exc. | CY | 3000 | 300 | 3300 | 3033 |
| 107 | Structure Excavation | CY | 591 | 61 | 652 | 820 |
| 222 | Gravel Backfill | CY | 0 | 0 | 0 | 100 |
| 363 | Bit Conc. Pavt for Bridge Floor | Ton | 110 | 16 | 126 | 0 |
| 401-B | Concrete Class B (Mod) | CY | 619 | 33 | 652 | 664 |
| 442 | Reinforcing Steel | Lbs. | 83,650 | — | 83,650 | 84,570 |
| 405 | Spiral Reinforcement (30105) | L.S. | 1 | — | 1 | 1 |
| 404A | Structural Steel | Lbs. | 160,484 | 3216 | 163,700 | 164,063 |
| 407 | Asphaltic-Asbestos Coating | SY | 44 | — | 44 | 44 |
| 441 | Temporary Bridge | L.S. | 1 | — | 1 | 1 |
| 442 | Removal of Present Super. | L.S. | 1 | — | 1 | 1 |
| 521 | Stone Fill (Heavy Type) | CY | 1544 | 132 | 1676 | 1320 |
| 556C | Granite Bridge Curb | L.F. | 298 | — | 298 | 220 |
| 572 | Bridge Railing | L.F. | 243 | — | 243 | 243 |

B.M. # 10 S.I.T. 15" Hemlock S.Lt. 78+50 Elev 1190.35
B.M. # 11 S.I.R. 8" Popular 40 Lt Sta 83+15 Elev 1216.64
B.M. # 12 Point Mark on wing Wall Sta 86+34 Elev 1234.07

9