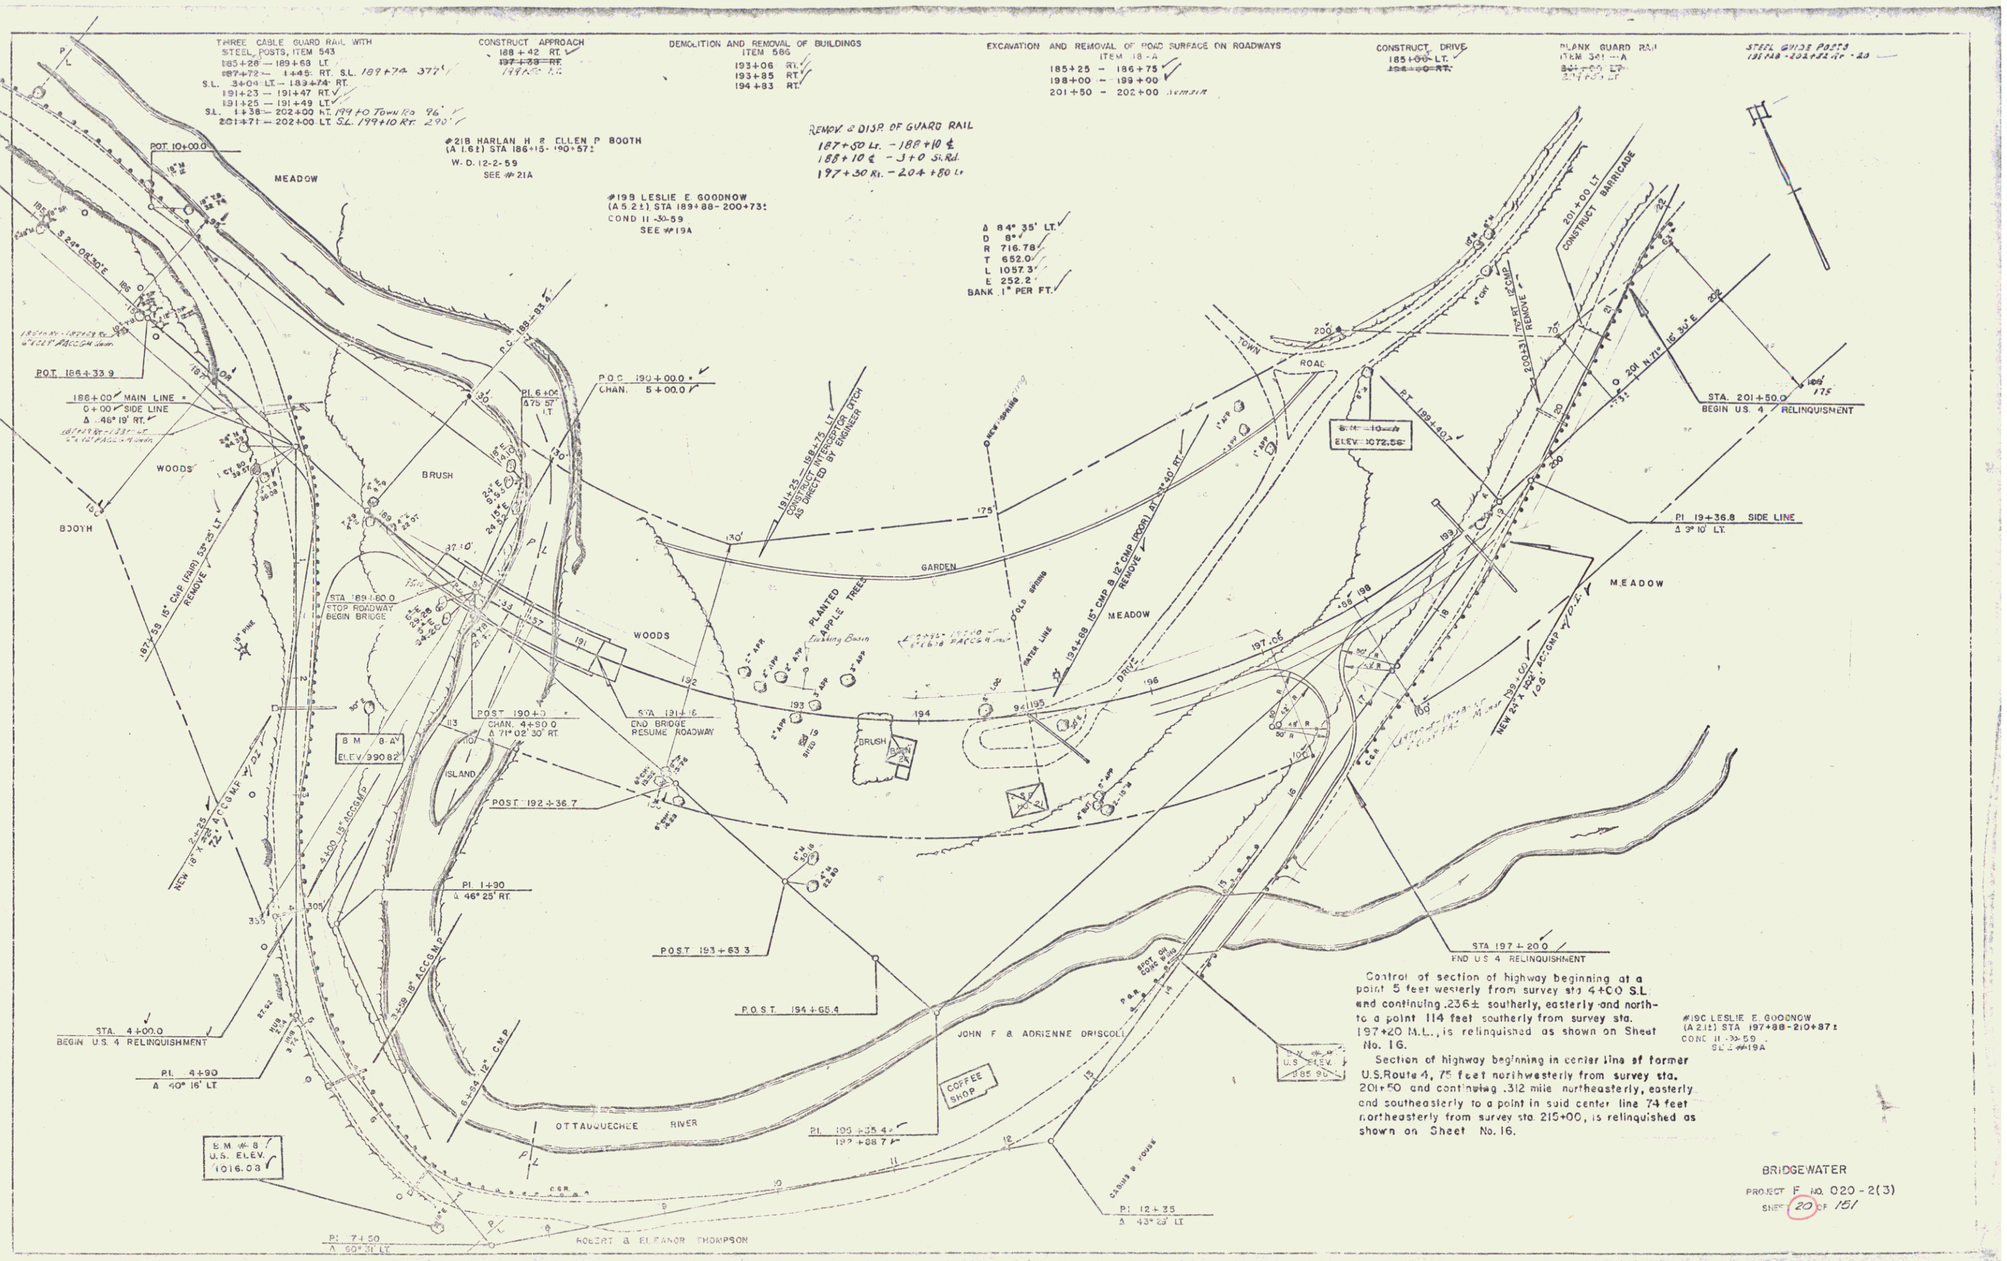

Control of section of highway beginning at a point 5 feet westerly from survey sta 4+00 S.L. and continuing .236± southerly, easterly and northerly to a point 114 feet southerly from survey sta. 197+20 M.L., is relinquished as shown on Sheet No. 16.

Section of highway beginning in center line of former U.S. Route 4, 75 feet northwesterly from survey sta. 201+50 and continuing .312 mile northeasterly, easterly and southeasterly to a point in said center line 74 feet northeasterly from survey sta 215+00, is relinquished as shown on Sheet No. 16.

BRIDGEWATER

PROJECT F. NO. 020-2(3)

SHEET 20 OF 151