15 7.50
TITLE TAKEN: COND. 11/23/59
RECORDED: BRIDGEWATER — BK 33—PG 393—422—12/4/59

Construct Turnout
332+60 — 333+00

327+00 — 333+33
Construct Drive
327+00 Rt.
329+30 Rt.

Project Marker 1962 F020-2(5)
F020-2(8)

Lot Boundary Marker


3692.00

79.83' Tie Bound

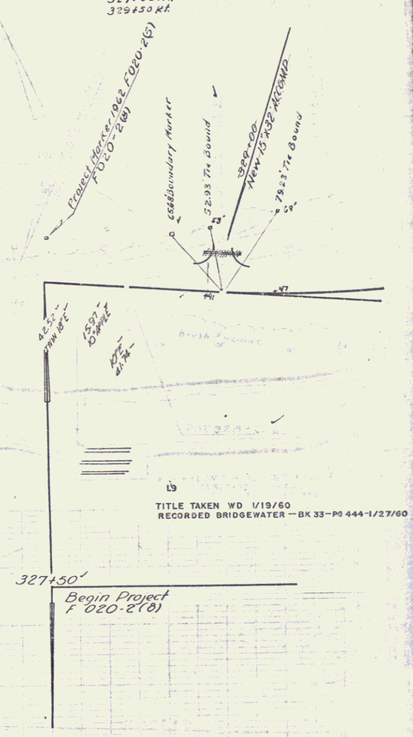

19
TITLE TAKEN WD 1/19/60
RECORDED BRIDGEWATER — BK 33—PG 444—1/27/60

B.M. 20A S.I.T. 30" Beech 80' Lt. 330+50 Elevation 890.30

9 140

2