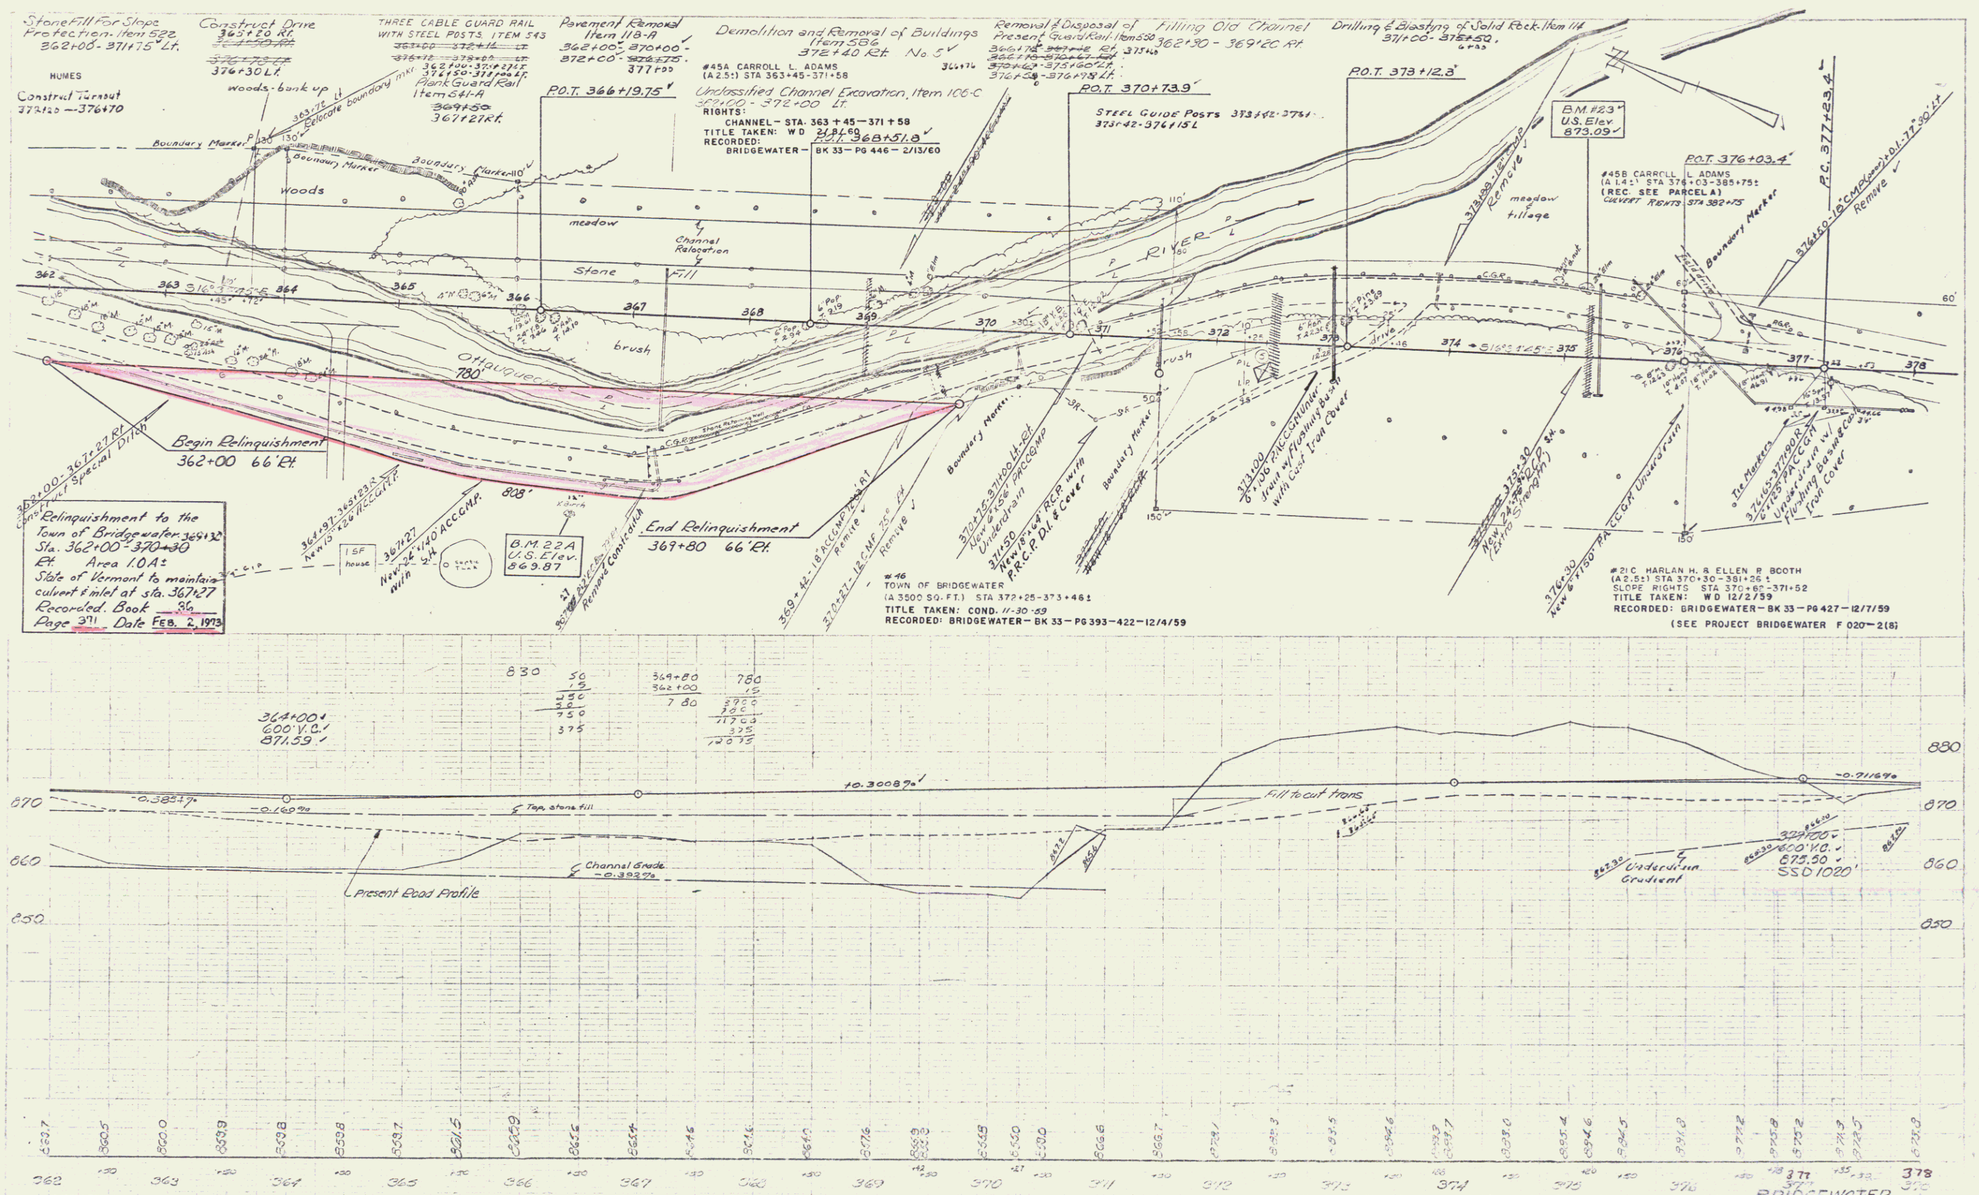
Stone Fill For Slope Protection - Item 522
362+00 - 371+75' Lt.
Construct Drive
363+20 Rt.
376+30 Lt.
THREE CABLE GUARD RAIL WITH STEEL POSTS ITEM 543
Pavement Removal Item 118-A
362+00 - 370+00
372+00 - 377+75
Demolition and Removal of Buildings Item 586
371+40 Rt. No. 5
Removal & Disposal of Present Guard Rail Item 530
362+30 - 369+20 Rt.
Filling Old Channel
Drilling & Blasting of Solid Rock Item 114
371+00 - 375+50
HUMES
Construct Turnout
372+25 - 376+70
woods - bank up
Boundary Marker
Woods
meadow
Stone Fill
brush
Channel Relocation
Unclassified Channel Excavation, Item 106-C
372+00 - 372+00 Lt.
RIGHTS:
CHANNEL - STA. 363 + 45 - 371 + 58
TITLE TAKEN: WD 2/8/60
RECORDED:
BRIDGEWATER - BK 33 - PG 446 - 2/13/60
P.O.T. 366+19.75'
P.O.T. 368+51.8
P.O.T. 370+73.9'
STEEL GUIDE POSTS 373+42-376+
P.O.T. 373+12.3'
B.M. #23 U.S. Elev. 873.09
P.O.T. 376+03.4'
P.C. 377+23.4'
#45B CARROLL L. ADAMS
(A 1.4±) STA 376+03-385+75±
(REC. SEE PARCEL A)
GUIDE POSTS STA 382+75
meadow
tillage
RIVER
Ottauquechee
780'
808'
Begin Relinquishment
362+00 66' Rt.
End Relinquishment
369+80 66' Rt.
Relinquishment to the Town of Bridgewater 36+32
Sta. 362+00 - 370+30
Rt Area 1.0A±
State of Vermont to maintain culvert & inlet at sta. 367+27
Recorded. Book 36
Page 371 Date FEB. 2, 1973
B.M. 22A U.S. Elev. 869.87
#46
TOWN OF BRIDGEWATER
(A 3500 SQ. FT.) STA 372+25-373+46±
TITLE TAKEN: COND. IV-30-69
RECORDED: BRIDGEWATER - BK 33 - PG 393-422-12/4/59
#21C HARLAN H. & ELLEN P. BOOTH
(A 2.5±) STA 370+30-381+26±
SLOPE RIGHTS STA 370+65-371+52
TITLE TAKEN: WD 12/2/59
RECORDED: BRIDGEWATER - BK 33 - PG 427 - 12/7/59
(SEE PROJECT BRIDGEWATER F 020-2(8)
364+00
600' V.C.
871.59
+0.3008%
-0.3854%
-0.169%
-0.911%
Top stone fill
Channel Grade -0.3927%
Present Road Profile
Fill to cut trans
Underdrain Gradient
304+00
600' V.C.
872.50
SSD 1020'
B.M. 22A Spike in Y. Birch 175' Rt 366+50 Elevation 869.87
B.M. #23 S.I.R. 24" Elm 60' Lt. Sta. 375+17' Elevation 873.09'
BRIDGEWATER
F020-2(8)
Sheet 14 of 140