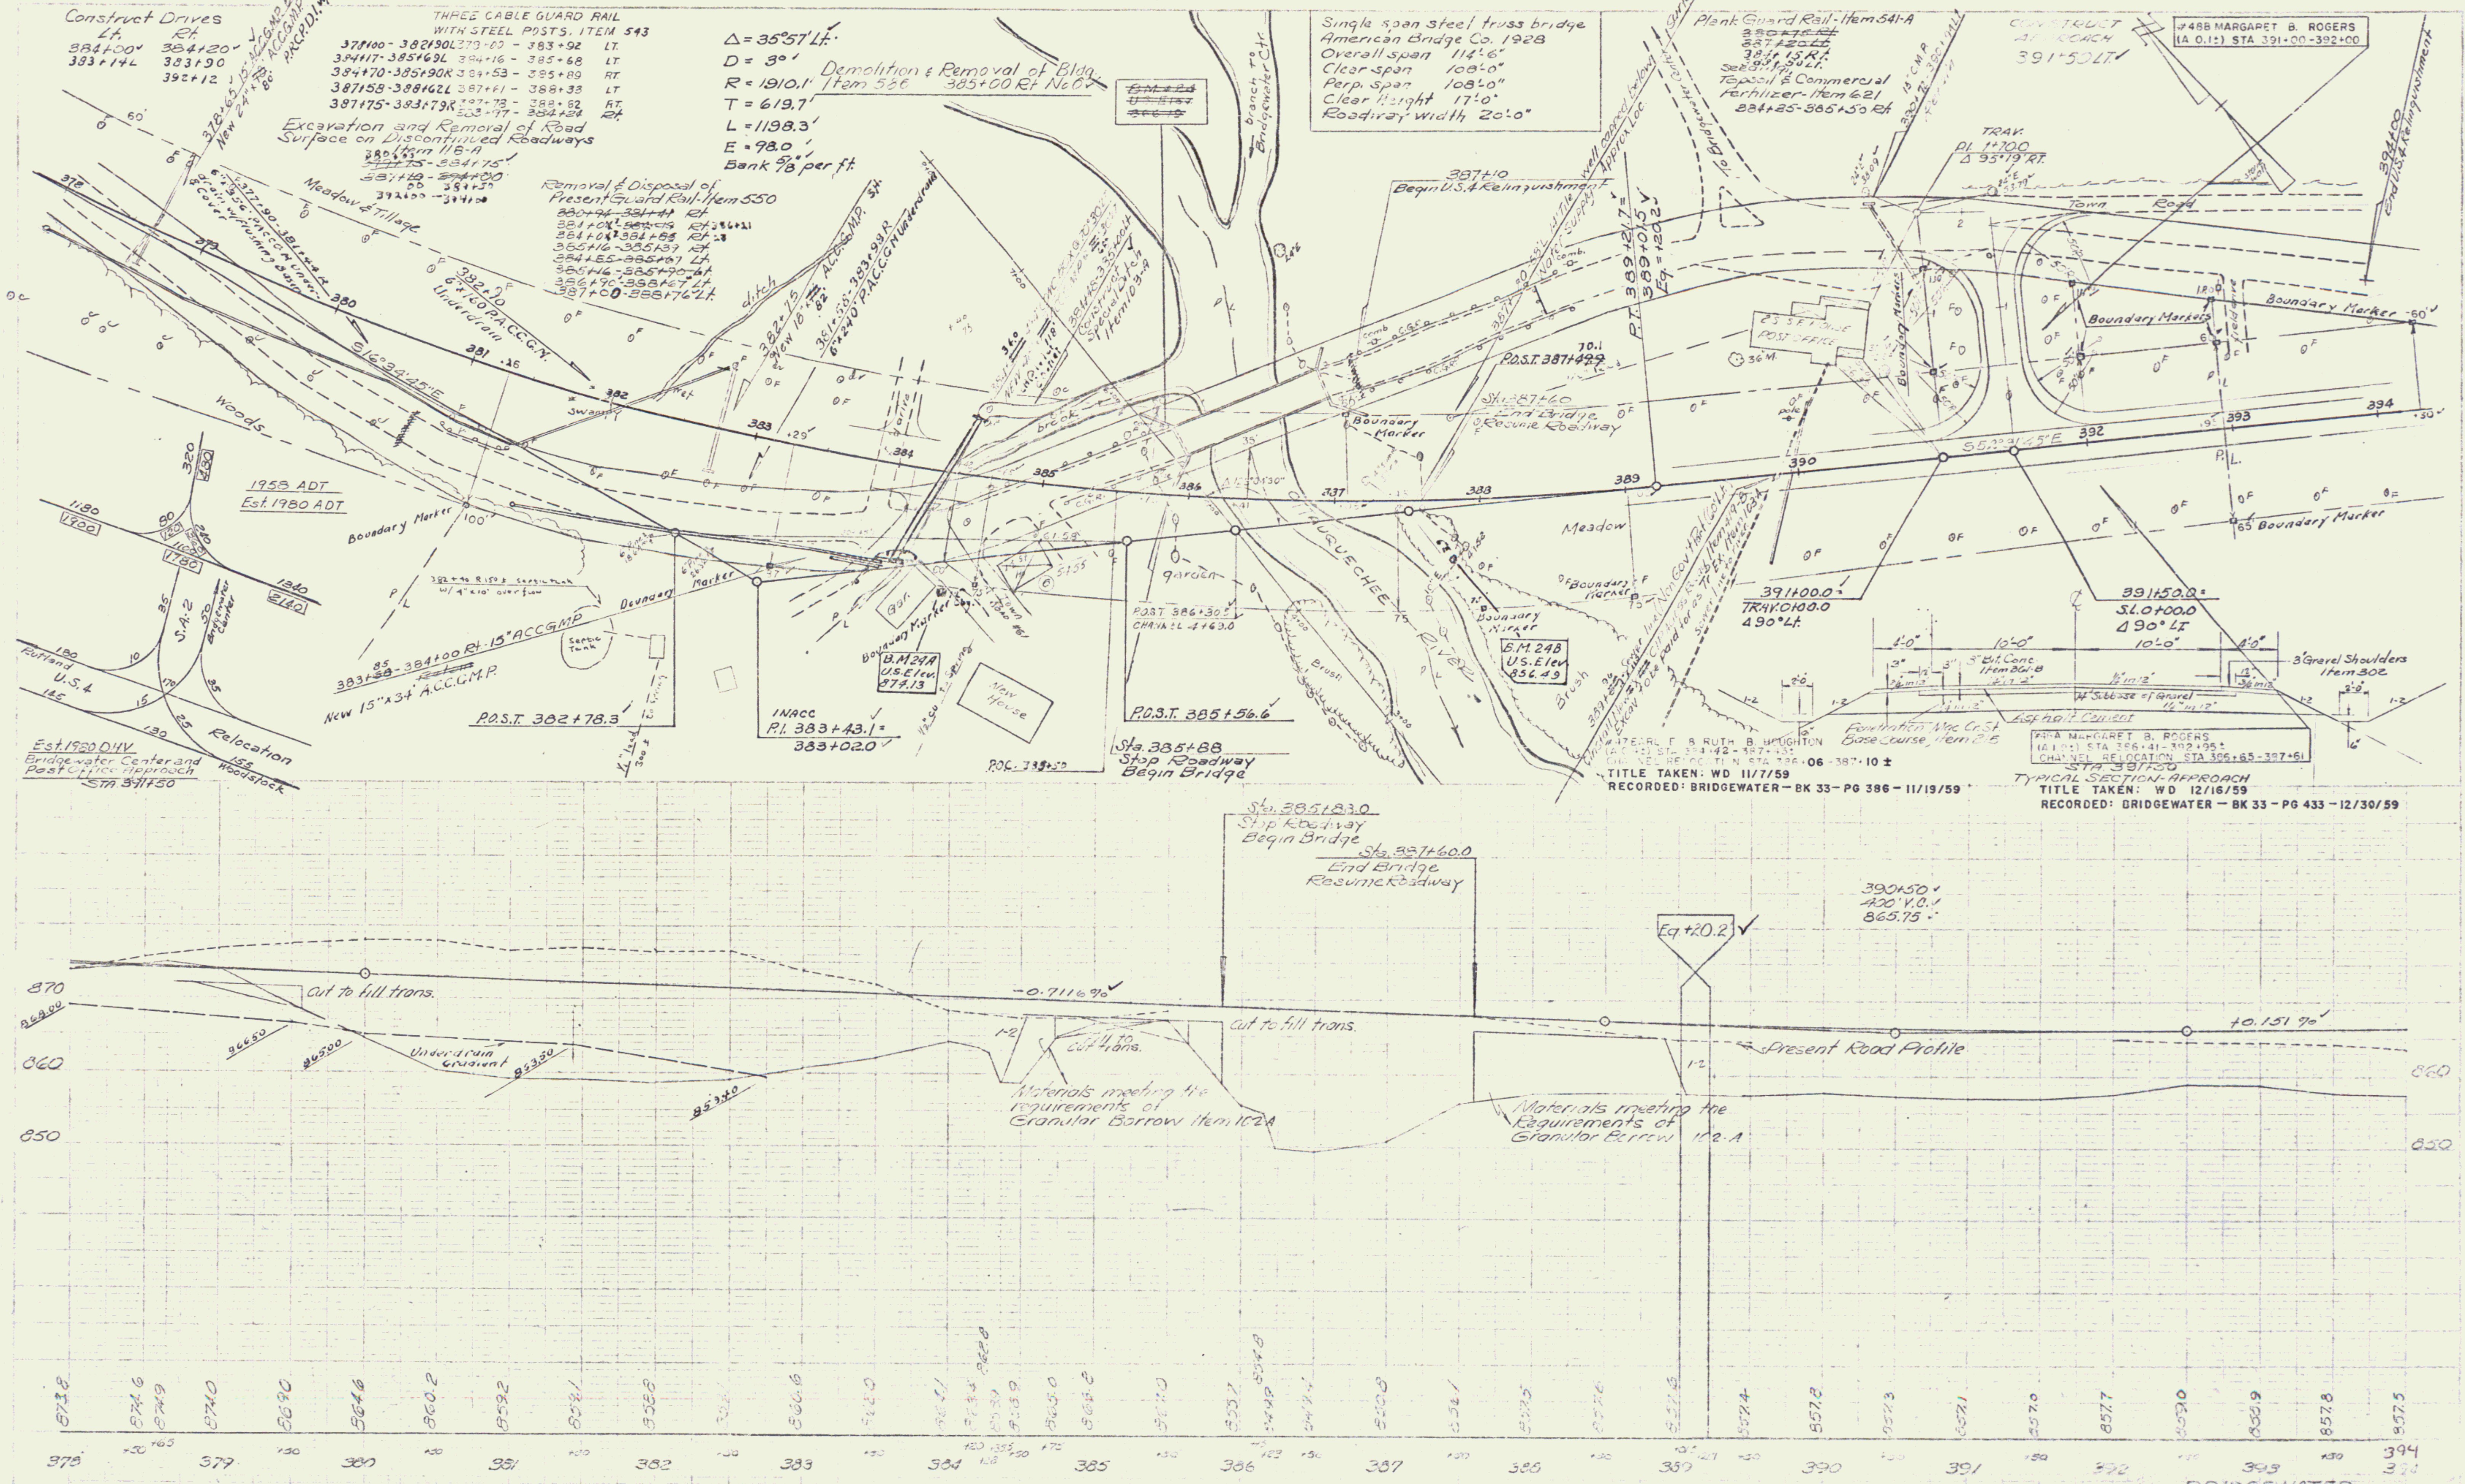
Construct Drives
Lt. Rt.
384+00 384+20
383+14L 383+90
392+12
378+65 15" ACCGMP 84' Lt.
New 24"x78' ACCGMP
80' P.R.C.P.D.I. w/Cover
THREE CABLE GUARD RAIL
WITH STEEL POSTS. ITEM 543
378+00 - 382+90L 378+00 - 383+92 LT.
384+17 - 385+69L 384+16 - 385+68 LT.
384+70 - 385+90R 384+53 - 385+89 RT.
387+58 - 388+62L 387+61 - 388+33 LT
387+75 - 383+79R 387+73 - 388+62 RT.
383+77 - 384+24 Rt.
Excavation and Removal of Road
Surface on Discontinued Roadways
Item 118-A
380+65 - 384+75
~~377+75~~
387+10 - ~~384+00~~
387+50
392+00 - 394+00
Δ = 35°57' Lt.
D = 3°
R = 1910.1'
T = 619.7'
L = 1198.3'
E = 98.0'
Bank 5/8" per ft.
Demolition & Removal of Bldg.
Item 586 385+00 Rt No.67
Removal & Disposal of
Present Guard Rail-Item 550
~~380+94 - 381+41~~ Rt
381+0x - ~~382+19~~ Rt 386+21
384+0x 384+88 Rt
385+16 - 385+39 Rt
384+55 - 385+67 Lt.
385+16 - 385+90 Lt.
386+90 - 388+67 Lt.
387+00 - 388+76 Lt.
~~B.M. 24A U.S. Elev 874.13~~
branch to Bridgewater Ctr.
Single span steel truss bridge
American Bridge Co. 1928
Overall span 114'-6"
Clear span 108'-0"
Perp. span 108'-0"
Clear Height 17'-0"
Roadway width 20'-0"
Plank Guard Rail-Item 541-A
~~380+78 Rt~~
~~387+20 Lt~~
384+15 Rt.
391+50 Lt.
Seeding,
Topsoil & Commercial
Fertilizer-Item 621
384+85-385+50 Rt
15" C.M.P.
390+78 - 390+94 Lt.
Retain
CONSTRUCT APPROACH
391+50 Lt.
#48B MARGARET B. ROGERS
(A 0.1±) STA 391+00-392+00
394+00
End U.S. 4 Relinquishment
To Bridgewater Center
Surface
Meadow & Tillage
E 377+90 - 381+44 R
6" x 356' P.A.C.C.G.N. Underdrain w/ flushing basin
8" drain w/ cover
382+90
6" x 160 P.A.C.C.G.N.
Underdrain
S16°34'45"E
378
379
380
381
382
383
384
385
386
387
388
389
390
392
393
394
Woods
Swamp
Wet
ditch
382+75
New 18" x 82' A.C.C.G.M.P.
381+58 - 383+98 R
6" x 240' P.A.C.C.G.N. Underdrain
384+45 - 385+00 Lt.
Construct Special Ditch
Item 103-A
brook
garden
Gar.
New House
Boundary Marker
Boundary Markers
Boundary Marker 60'
Boundary Marker 65'
B.M. 24A
U.S. Elev.
874.13
B.M. 24B
U.S. Elev
856.49
1958 ADT
Est. 1980 ADT
320
180
1180
1900
90
120
110
280
1780
1340
2140
Rutland
U.S. 4
145
10
15
170
35
S.A. 2
50
Bridgewater Center
25
130
155
Woodstock
Relocation
Est. 1980 DHV
Bridgewater Center and
Post Office Approach
STA. 391+50
382+40 R 150± Septic tank
w/ 4" x 10' overflow
Septic Tank
383+85 - 384+00 Rt. 15" ACCGMP
Retain
New 15" x 34' A.C.C.G.M.P.
P.O.S.T. 382+78.3
P.L.
100'
1½" lead
300±
INACC
P.I. 383+43.1 =
383+02.0
P.O.C. 383+50
1½" cu. to Spring
Sta. 385+88
Stop Roadway
Begin Bridge
P.O.S.T. 385+56.6
P.O.S.T. 386+30.5
CHANNEL 4+63.0
Town Road #61
OTTAUQUECHEE RIVER
Brush
Meadow
387+10
Begin U.S. 4 Relinquishment
P.O.S.T. 387+49.9
Sta. 387+60
End Bridge
Resume Roadway
P.T. 389+21.7 =
389+01.5
Eq. = +20.2
well capped below Approx Loc.
Water Supply
Install New 12" Cl. Pipe Item 419-B
Excav. to be paid for as Tr. Ex. Item 103-A
Sewer line to river
2S S.F. HOUSE
POST OFFICE
36" M.
pole
TRAV.
P.I. 1+70.0
Δ 95°19' RT.
Town Road
Field drive
S52°31'45"E
391+00.0 =
TRAV. 0+00.0
Δ 90° Lt.
391+50.0 =
S.L. 0+00.0
Δ 90° Lt.
4'-0" 10'-0" 10'-0" 4'-0"
3" Bit. Conc. Item 361-B
3' Gravel Shoulders Item 302
12" Subbase of Gravel
Asphalt Cement
Penetration Mac. Cr. St. Base Course, Item 215
1-2
2'-0"
6"
#47 EARL F. & RUTH B. HOUGHTON
(A 0.4±) STA. 384+42 - 387+45±
CHANNEL RELOCATION STA. 386+06 - 387+10 ±
TITLE TAKEN: WD 11/7/59
RECORDED: BRIDGEWATER — BK 33 — PG 386 — 11/19/59
#48A MARGARET B. ROGERS
(A 1.0±) STA 386+41 - 392+95±
CHANNEL RELOCATION STA 386+65 - 387+61
STA. 391+50
TYPICAL SECTION-APPROACH
TITLE TAKEN: WD 12/16/59
RECORDED: BRIDGEWATER — BK 33 — PG 433 — 12/30/59
Sta. 385+83.0
Stop Roadway
Begin Bridge
Sta. 387+60.0
End Bridge
Resume Roadway
Eq. +20.2
390+50
400' V.C.
865.75
870
860
850
868.00
Cut to fill trans.
866.50
865.00
Underdrain Gradient
853.50
-0.7116%
Fill to cut trans.
Materials meeting the requirements of Granular Borrow Item 102A
Materials meeting the Requirements of Granular Borrow 102-A
Present Road Profile
+0.151%
873.8
874.6
874.9
874.0
869.0
864.6
860.2
859.2
858.8
860.6
854.8
857.7
857.4
857.8
857.3
857.1
857.0
857.7
859.0
858.9
857.8
857.5
378
379
380
381
382
383
384
385
386
387
388
389
390
391
392
393
394

B.M. 24A Spike in 12" Cherry 80' Rt. 384+40 Elevation 874.13

~~B.M. 24 Spot on Bridge~~

B.M. 24B Spike in 6" Elm 40' Rt. 387+80 Elevation 856.49

BRIDGEWATER
F 020-2(8)
Sheet 15 of 140

7