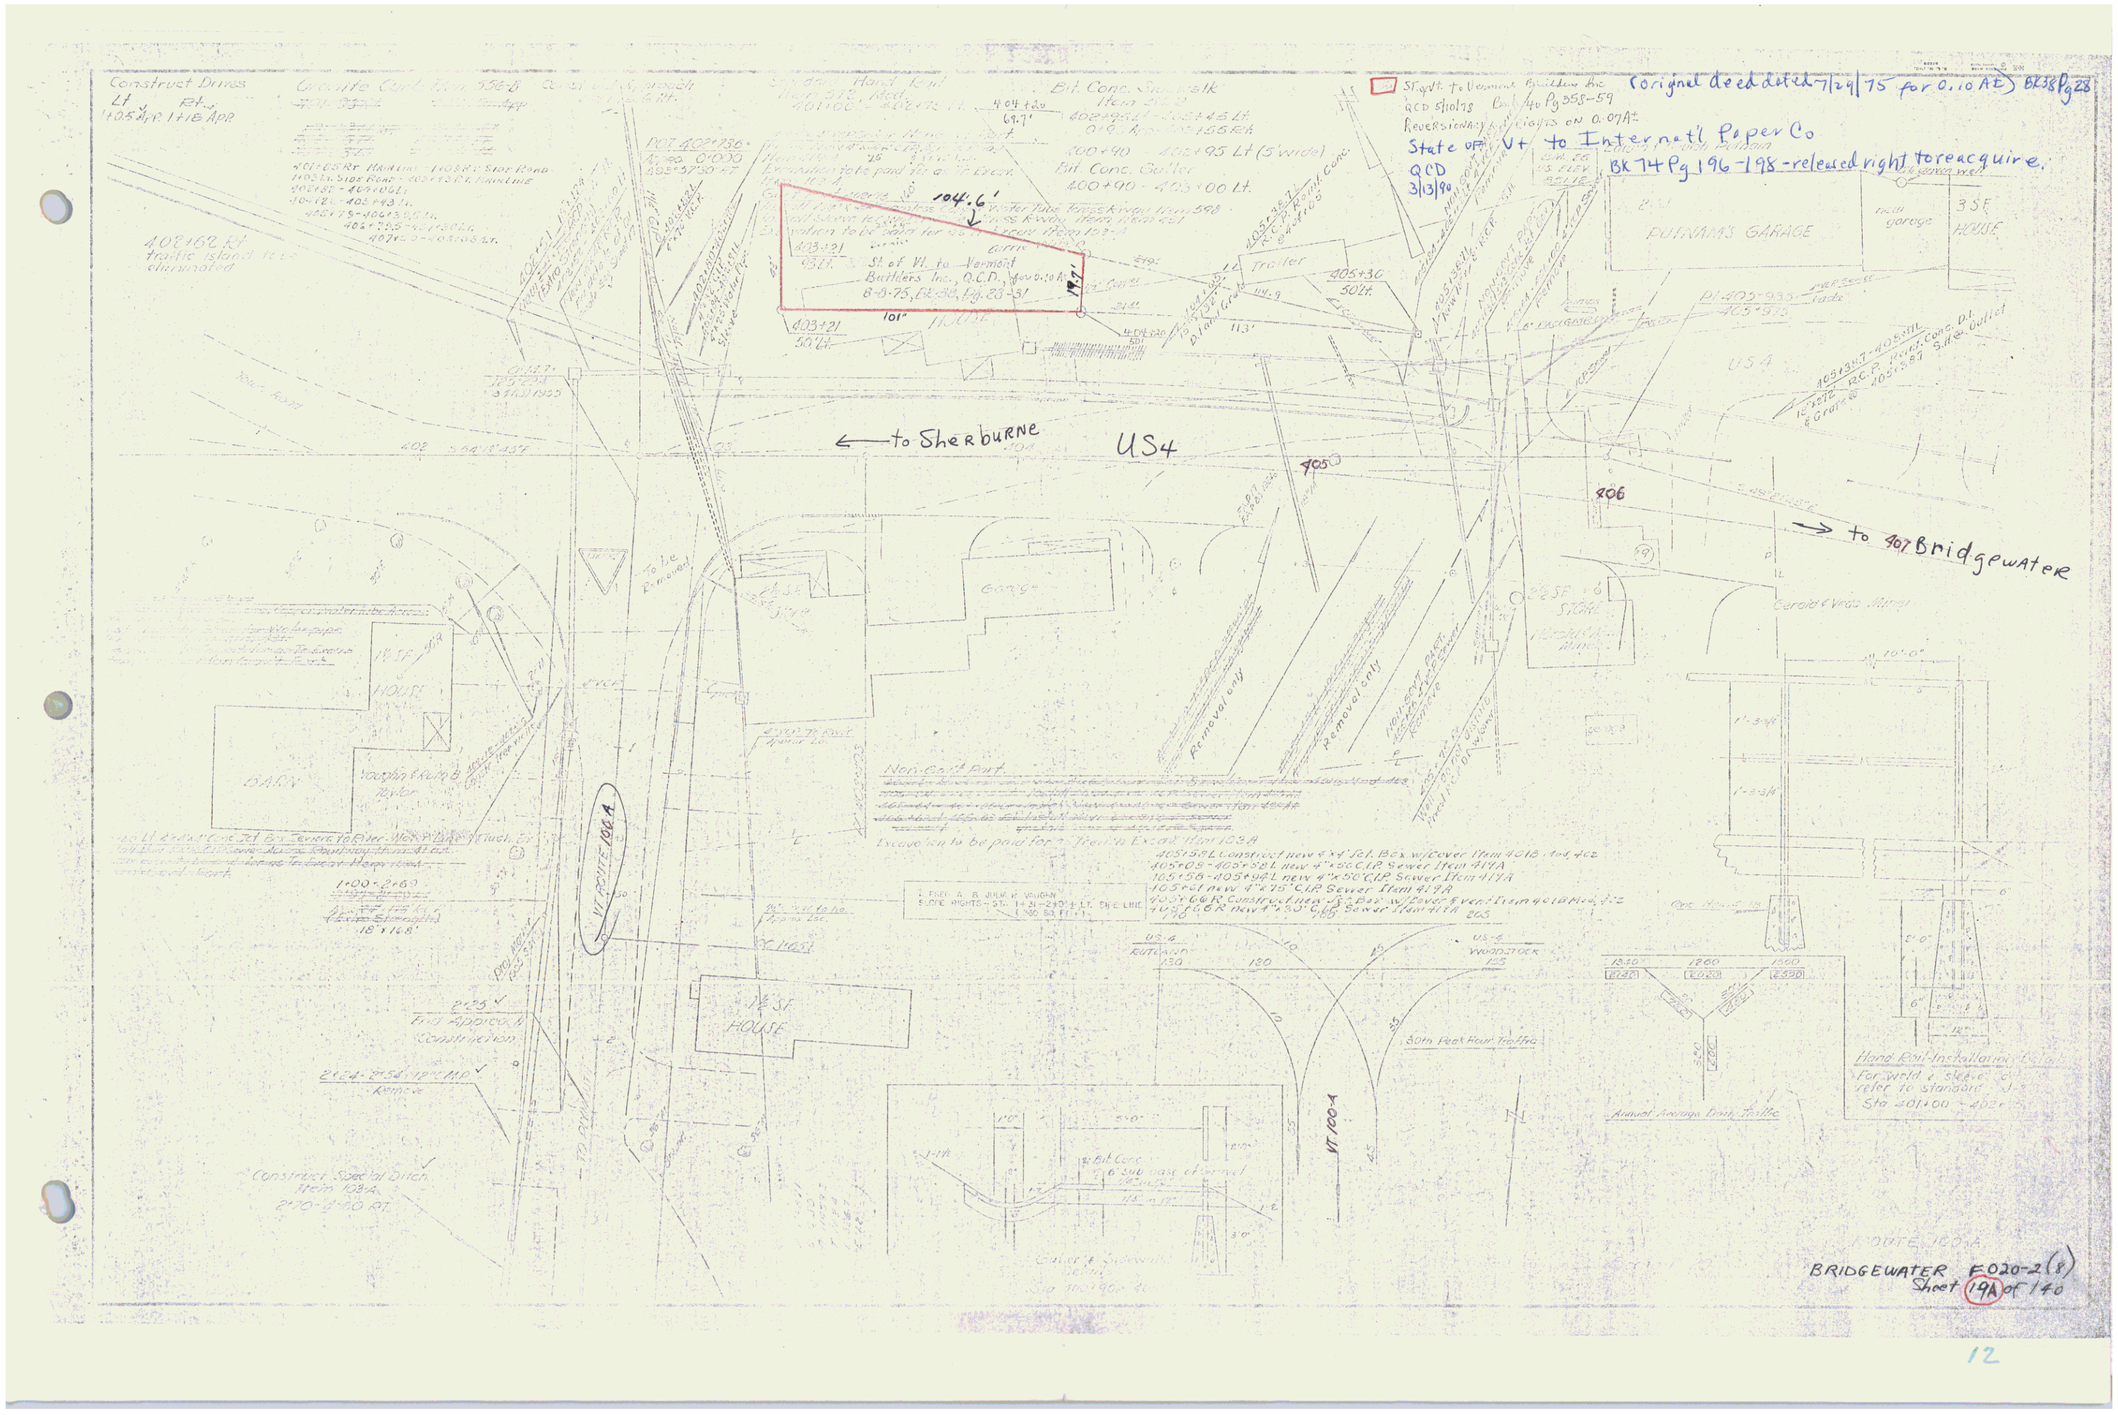

(original deed dated 7/29/75 for 0.10 AE) BK38 Pg 28

State of Vt to Internat'l Paper Co
QCD
3/13/80
Bk 74 Pg 196-198 - released right to reacquire.

12