FED. ROAD DIST. NO.	STATE	FED. AID PROJ. NO.	FISCAL YEAR	SHEET NO.	TOTAL SHEETS
5	VT.	F.R.-50	1928	7	48

SEE BRIDGE SHEETS
PLAN OF ABUTMENTS ~ SHEET 16
SUPERSTRUCTURE ~ SHEET 17
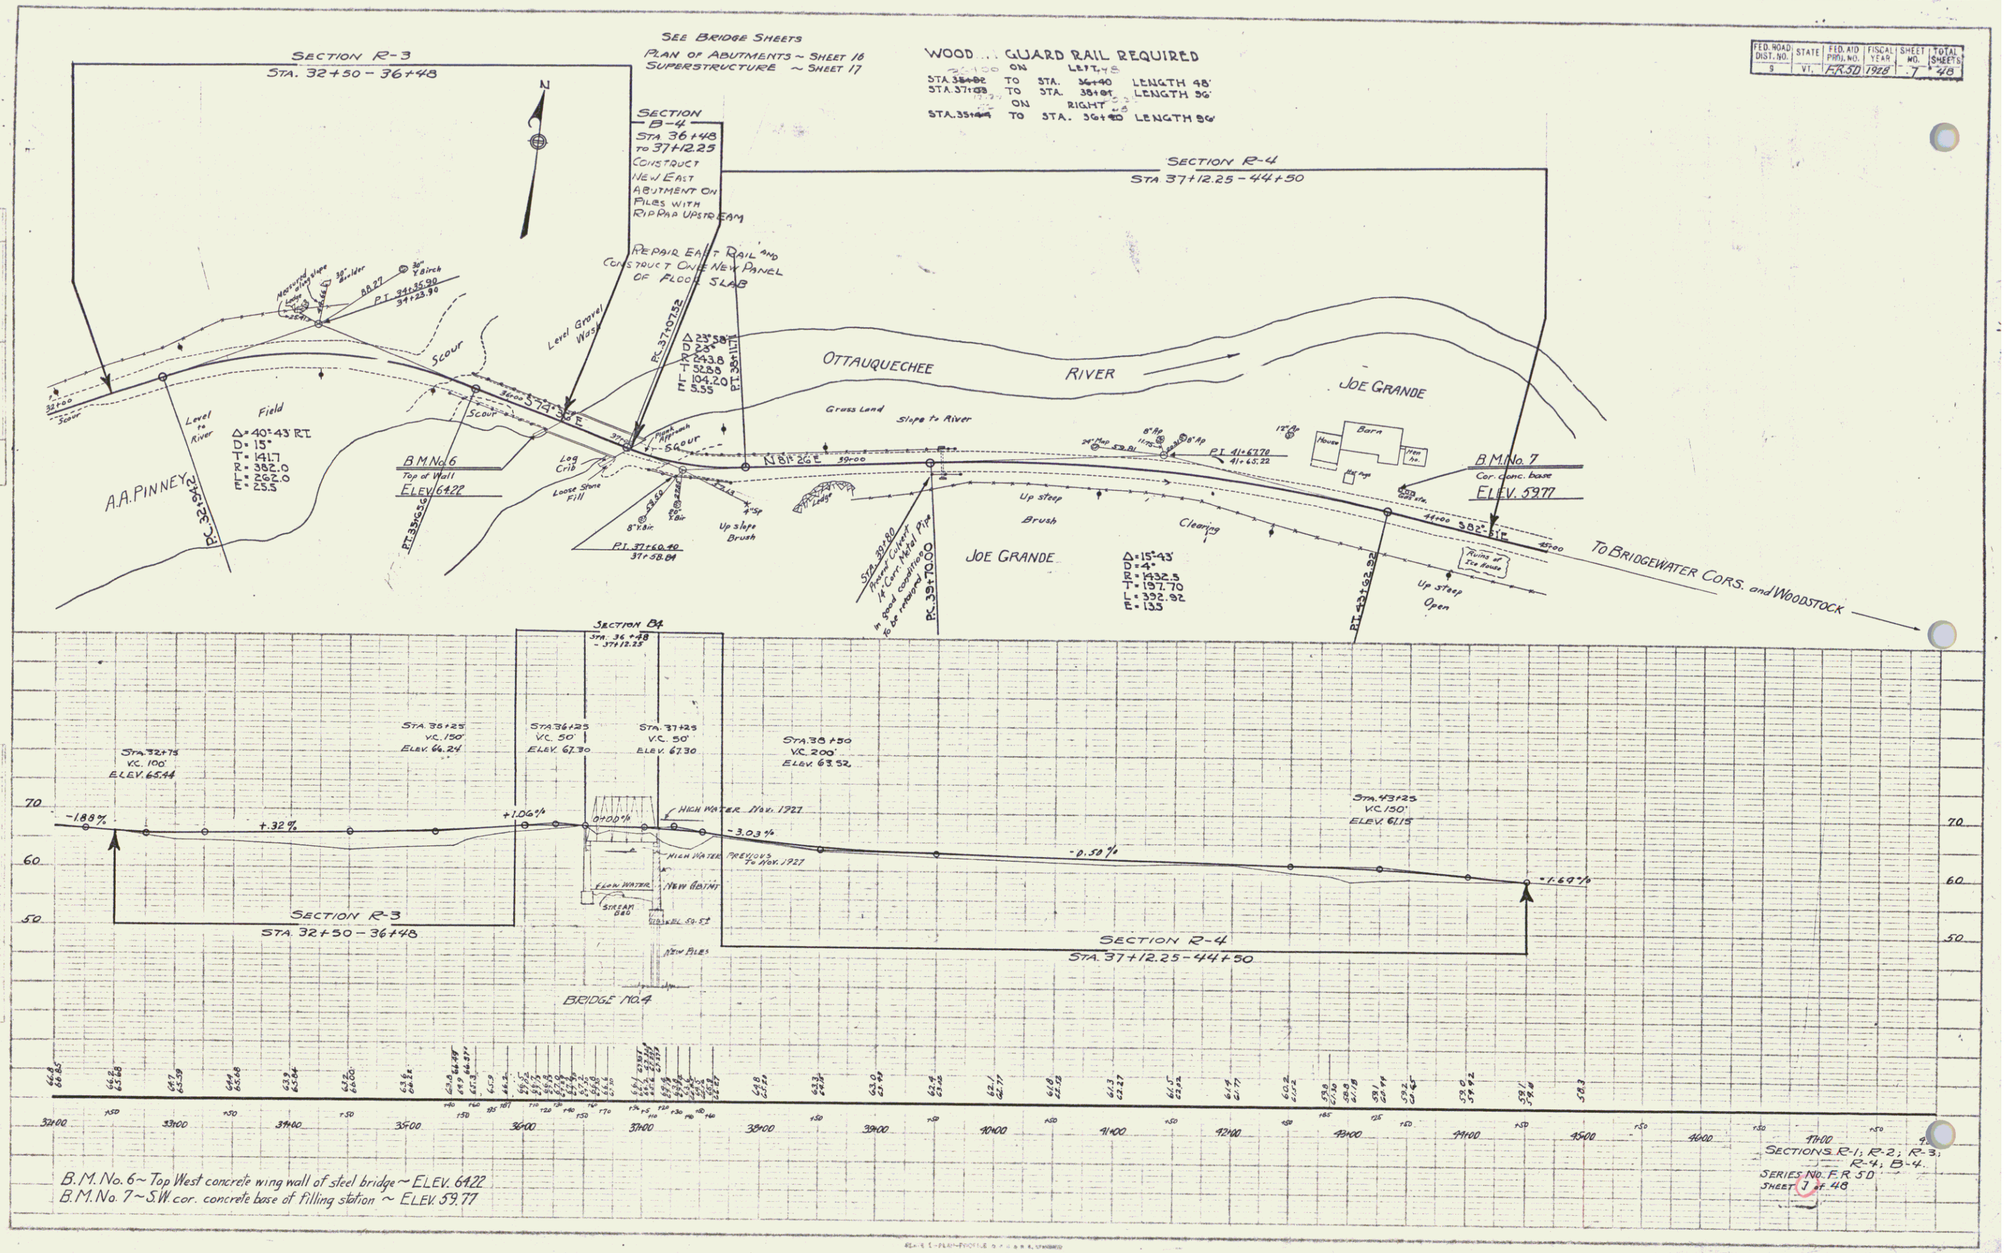
WOOD GUARD RAIL REQUIRED
ON LEFT HS
STA. 35+02 TO STA. 36+40 LENGTH 48'
STA. 37+08 TO STA. 38+04 LENGTH 96'
ON RIGHT
STA. 35+49 TO STA. 36+40 LENGTH 96'