N.R.H.
108-D 1933 6 140

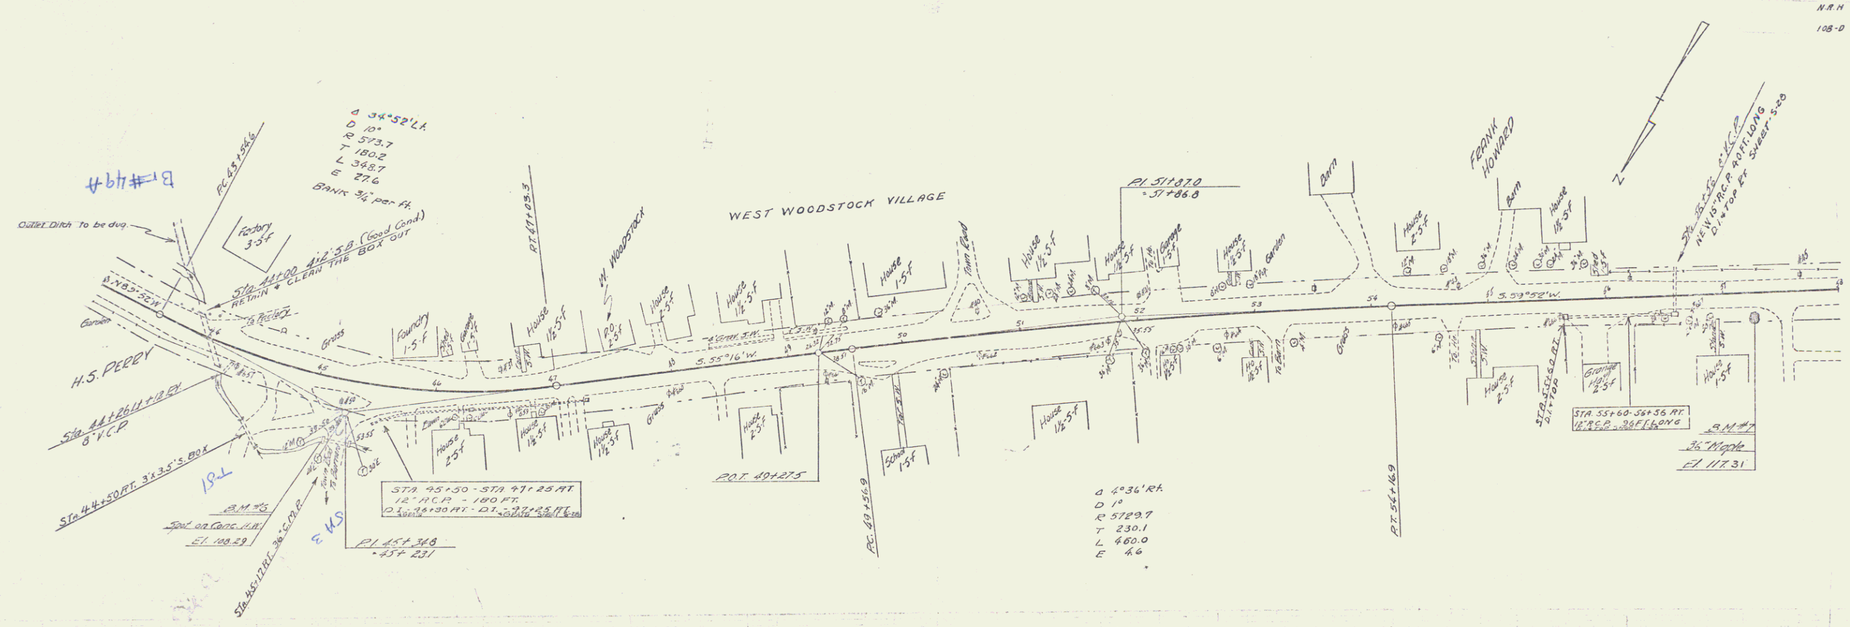

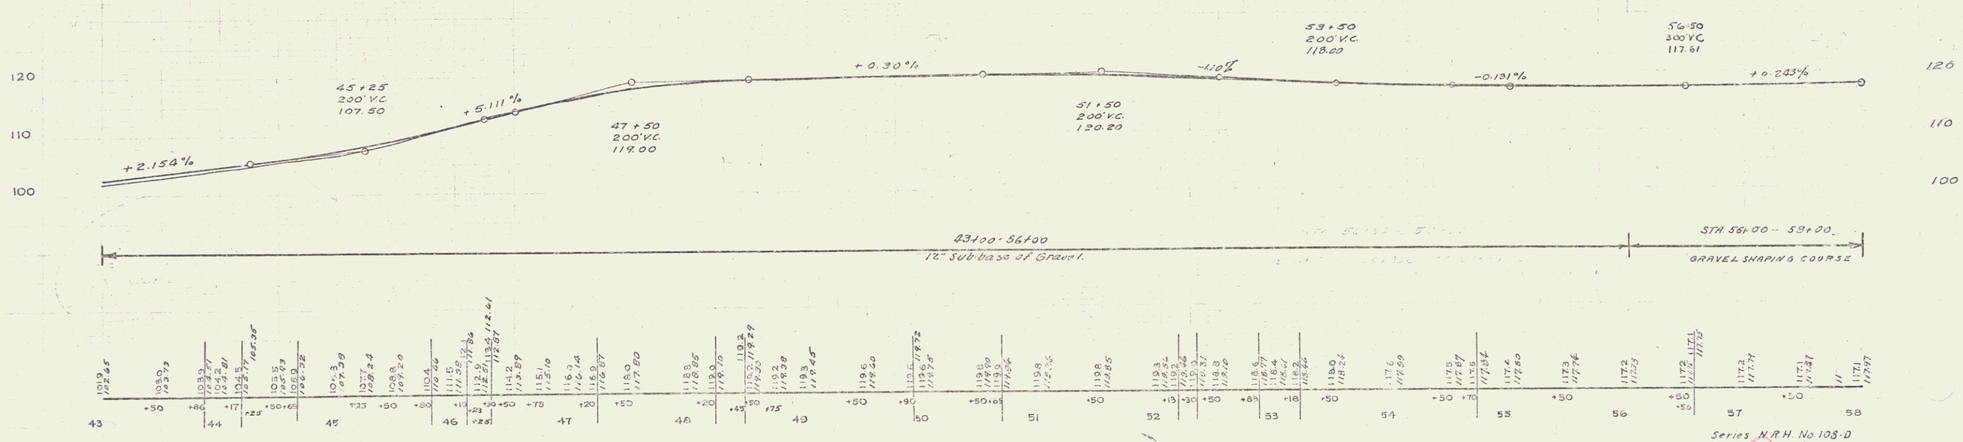

B.M. "6 Spot on Conc. Head Wall 55' Rt. Sta. 45+17 Elev. 108.29'
B.M. "7 Spike in Root 36" Maple 16' Rt. Sta. 57+25 Elev. 117.31 (Old B.M. "1")

Series N.R.H. No. 108-D
Sheet 6 of 140

5