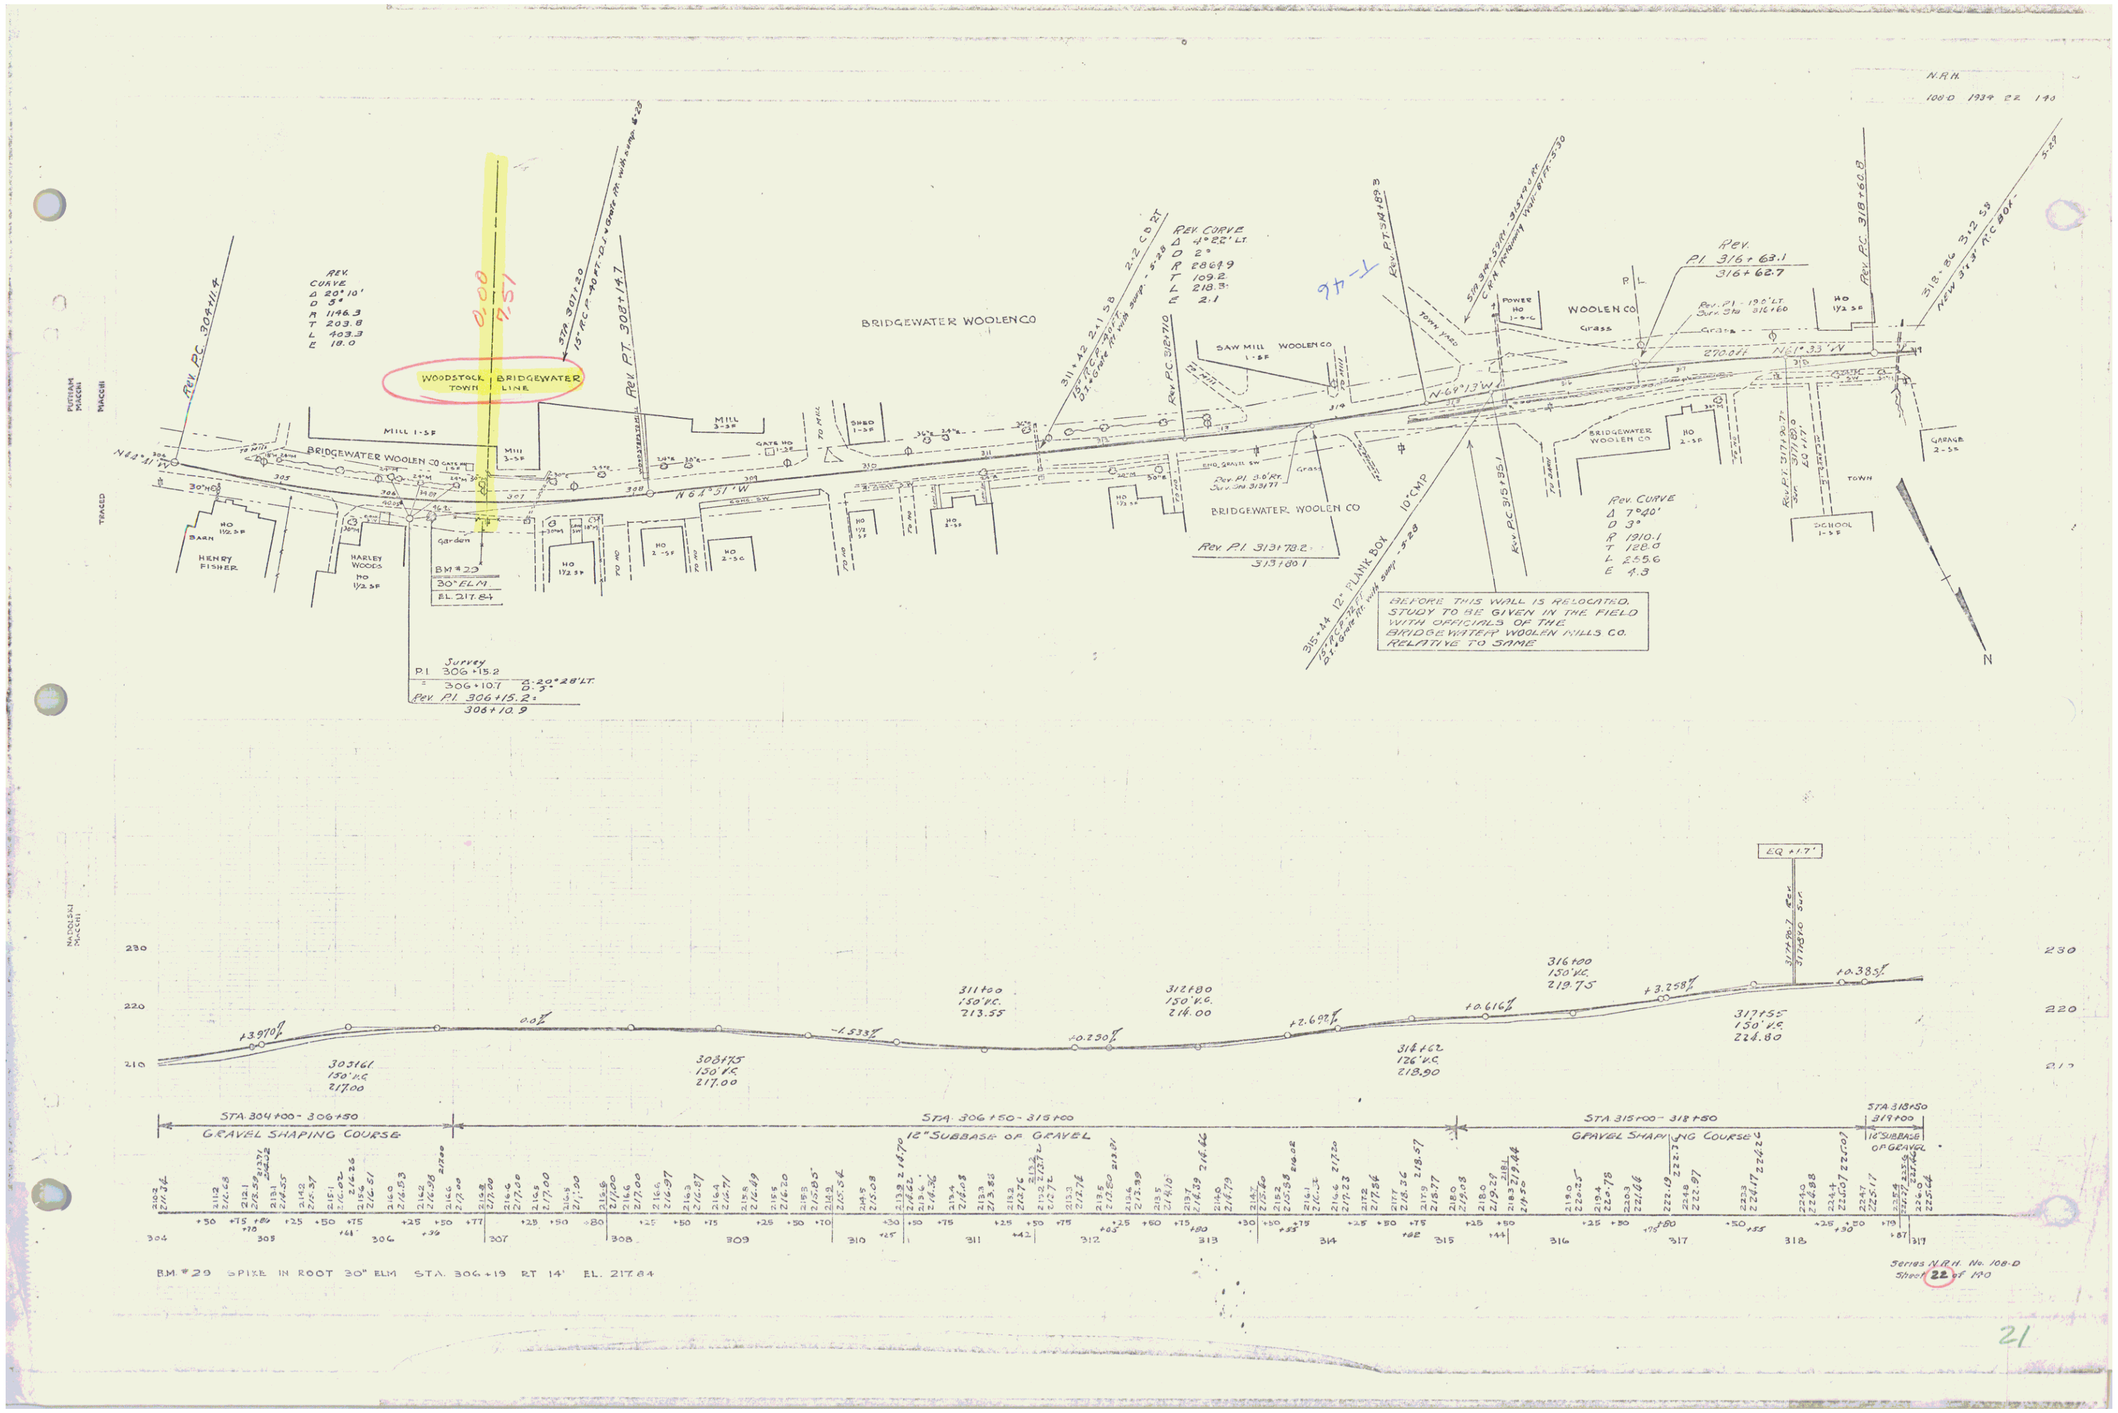
N.R.H.
108-D 1939 22 190
BRIDGEWATER WOOLEN CO
WOODSTOCK | BRIDGEWATER TOWN LINE
Rev. PC 304+11.4
Rev. PT 308+14.7
Rev. PC 312+71.0
Rev. PT 314+69.3
Rev. PC 318+60.8
Rev. PC 315+35.1
Rev. P.I. 316+63.1
316+62.7
Rev. P.I. 313+78.2
313+80.1
Rev. CURVE
Δ 1°22' LT.
D 2°
R 2864.9
T 109.2
L 218.3
E 2.1
Rev. CURVE
Δ 7°40'
D 3°
R 1910.1
T 128.0
L 255.6
E 4.3
BEFORE THIS WALL IS RELOCATED, STUDY TO BE GIVEN IN THE FIELD WITH OFFICIALS OF THE BRIDGEWATER WOOLEN MILLS CO. RELATIVE TO SAME
BM #20
30" ELM
EL. 217.84
Survey
P.I. 306+15.2
306+10.7
Rev. P.I. 306+15.2 =
306+10.9
GRAVEL SHAPING COURSE
12" SUBBASE OF GRAVEL
16" SUBBASE OF GRAVEL
STA. 304+00 - 306+50
STA. 306+50 - 315+00
STA. 315+00 - 318+50
STA. 318+50 - 319+00
BM #20 SPIKE IN ROOT 30" ELM STA. 306+19 RT 14' EL. 217.84
Series N.R.H. No. 108-D
Sheet 22 of 190
21