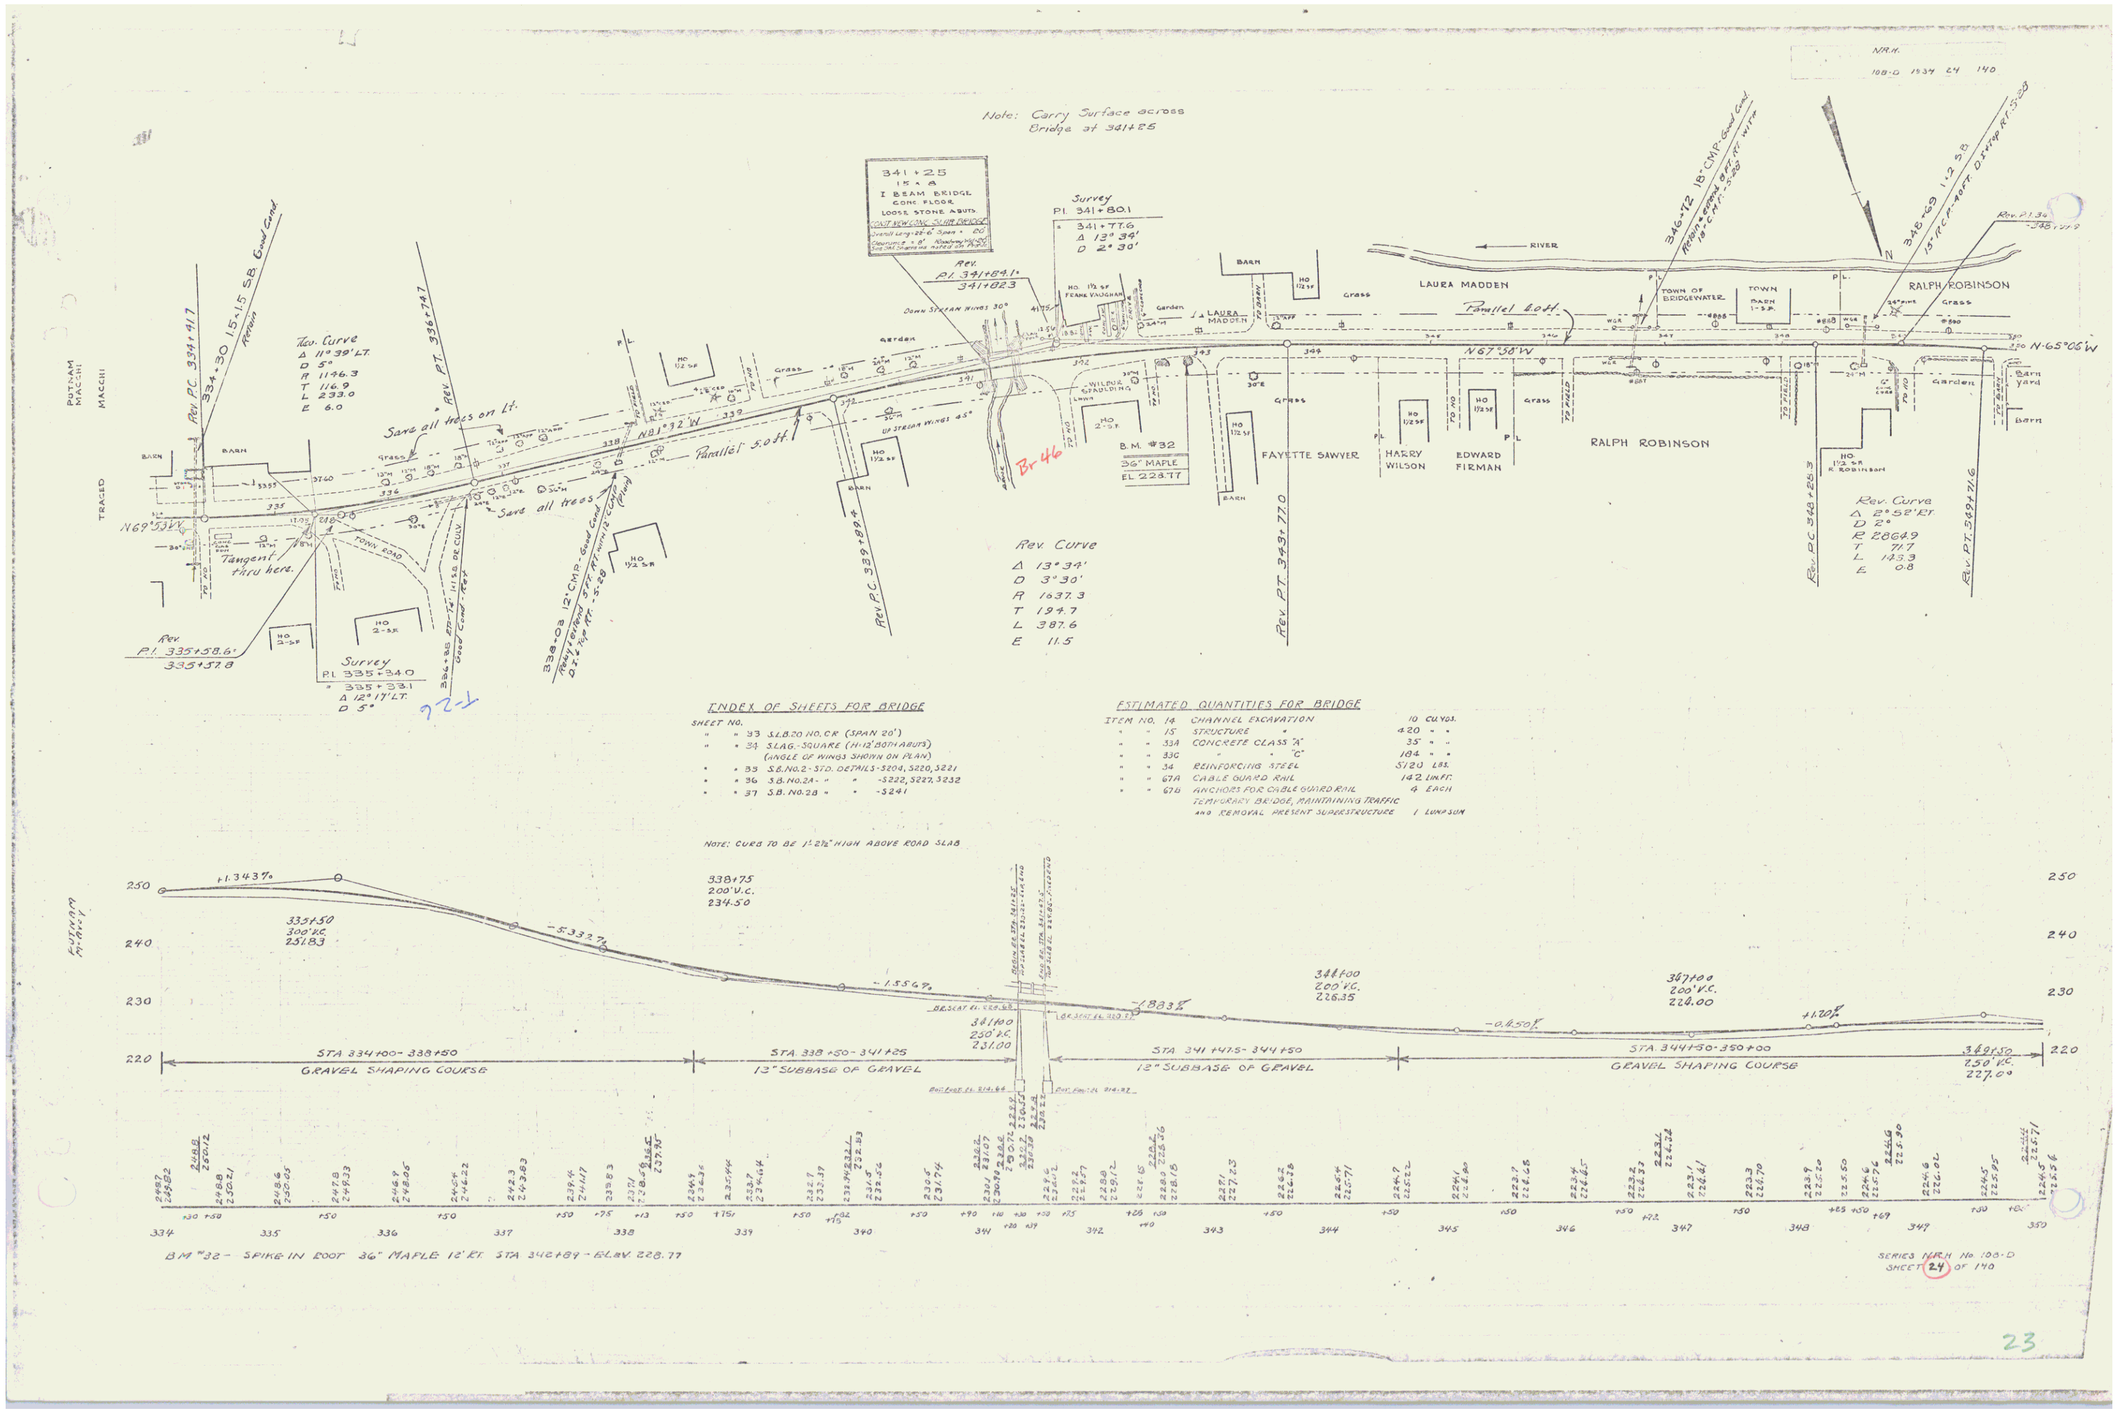

INDEX OF SHEETS FOR BRIDGE

SHEET NO.

- " " 33 S.B.20 HO. C.R. (SPAN 20')
- " " 34 S.LAG-SQUARE (HI-12 BOTH ABUTS) (ANGLE OF WINGS SHOWN ON PLAN)
- " " 35 S.B. NO.2-STD. DETAILS-5204, 5220, 5221
- " " 36 S.B. NO.2A- " " -5222, 5227, 5232
- " " 37 S.B. NO.2B " " -5241

ESTIMATED QUANTITIES FOR BRIDGE

ITEM NO.	14	CHANNEL EXCAVATION	10 CU YDS.
" "	15	STRUCTURE "	420 " "
" "	33A	CONCRETE CLASS "A"	35 " "
" "	33C	" " "C"	184 " "
" "	34	REINFORCING STEEL	5720 LBS.
" "	67A	CABLE GUARD RAIL	142 LIN.FT.
" "	67B	ANCHORS FOR CABLE GUARD RAIL	4 EACH
		TEMPORARY BRIDGE, MAINTAINING TRAFFIC AND REMOVAL PRESENT SUPERSTRUCTURE	1 LUMP SUM

BM "32" - SPIKE IN ROOT 36" MAPLE 12' ET. STA 342+89 - ELEV. 228.77

SERIES NRH No. 108-D
SHEET 24 OF 140

23