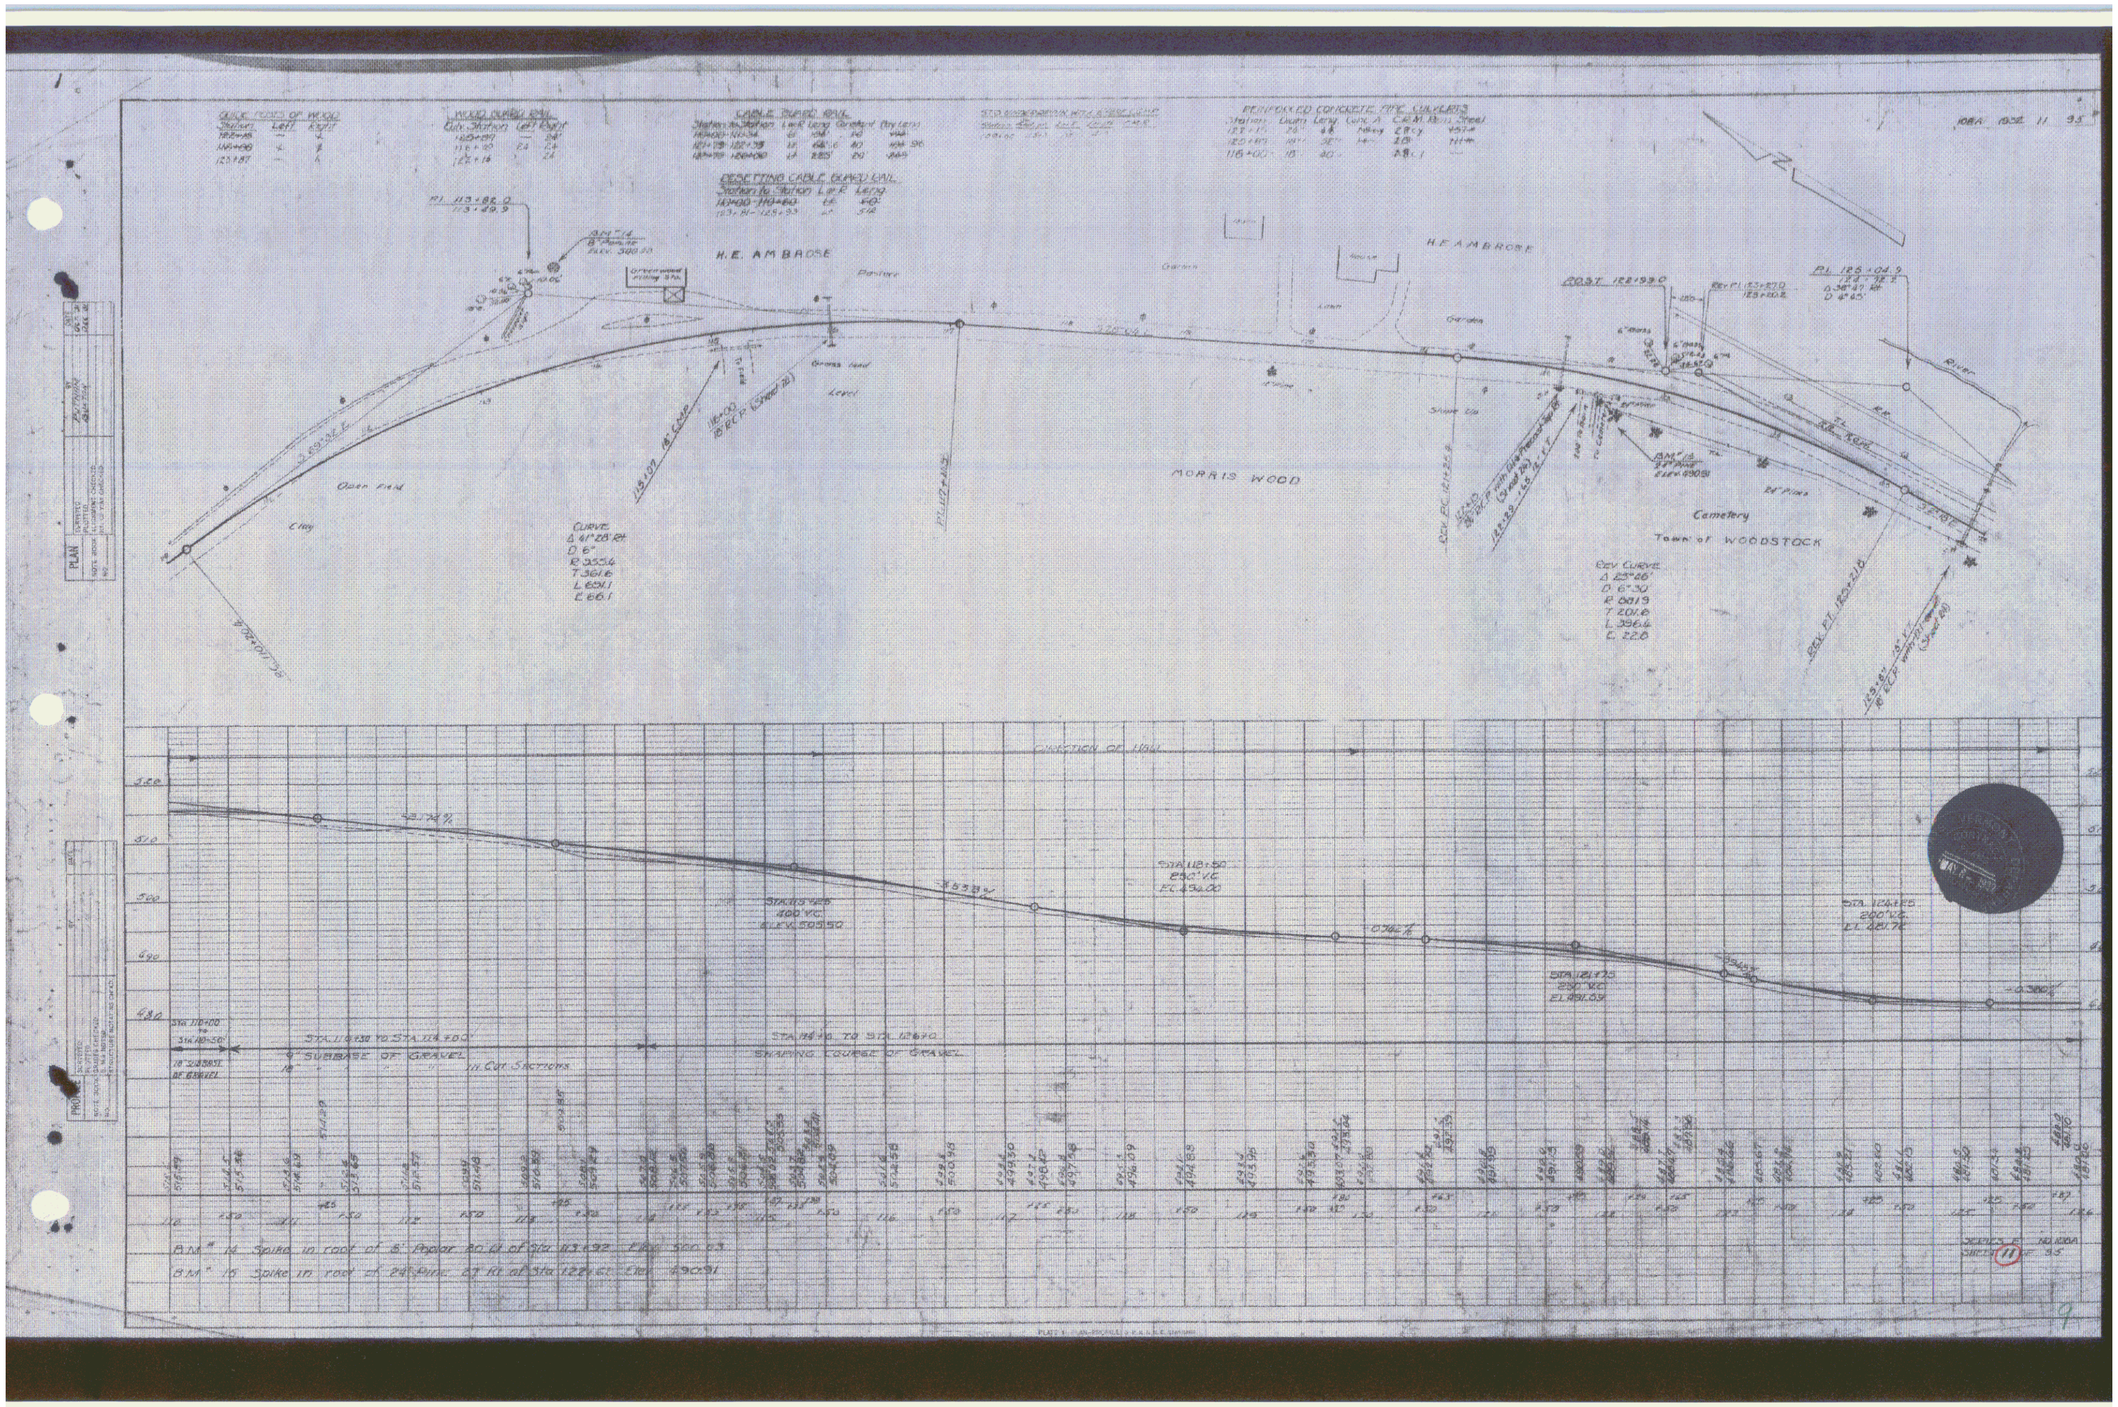
H.E. AMBROSE
MORRIS WOOD
Cemetery
Town of WOODSTOCK
River
Open Field
Garden
Curve
Δ 41°28' Rt
D 6°
R 955.6
T 361.6
L 654.1
C 661.1
Rev. Curve
Δ 25°46'
D 6°30'
R 881.9
T 201.6
L 396.6
C 22.8
Rev. Pl. 123+27.0
125+00.2
Pl. 125+04.9
Δ 36°47' Rt
D 4°45'
Rev. BC 121+35.8
Rev. EC 121+57.0
Rev. Pl. 122+21.0
Rev. Pl. 123+18.5
