GUIDE POSTS OF WOOD

Station	Left	Right
230+89	—	1
237+36	—	1

WOOD GUARD RAIL

Guide Station	Left	Right
231+00	26'	26'
231+50	—	28'
232+50	—	24'
242+59	—	26'
243+52	—	26'

RESETTING CABLE GUARD RAIL

Station to Station	Side	Length
234+08 234+26	Rt.	828.168'
236+80 237+00	Rt.	2.26
239+20 246+00	Lt.	650 16.88
245+38		

REINFORCED CONCRETE BOX CULVERT PATCHING

Station	Span	Conc. A	Rein. Steel	Patch Concrete
234+50	5'-0"	1 cy	226#	2.2 c.f.

STD. UNDERDRAIN WITH 6" PIPE (CONC.)

Station	Length	Conc.	Rein.	Pipe	Code
238+50	240.00	6"		6"	5.5-1
239+24	224.30			203	

CORRUGATED CALV. METAL PIPE CULVERTS

Station	Diam.	Leng.	Conc. A	C.P.M.	Rein. Steel
231+01	18"	70'	—	30 cy	—
230+60	24"	60'	1.3	54 cy	53

REINFORCED CONCRETE PIPE CULVERTS

Station	Diam.	Leng.	Conc. A	C.P.M.	Steel
239+46	24"	63'	2.3	54 cy	53#

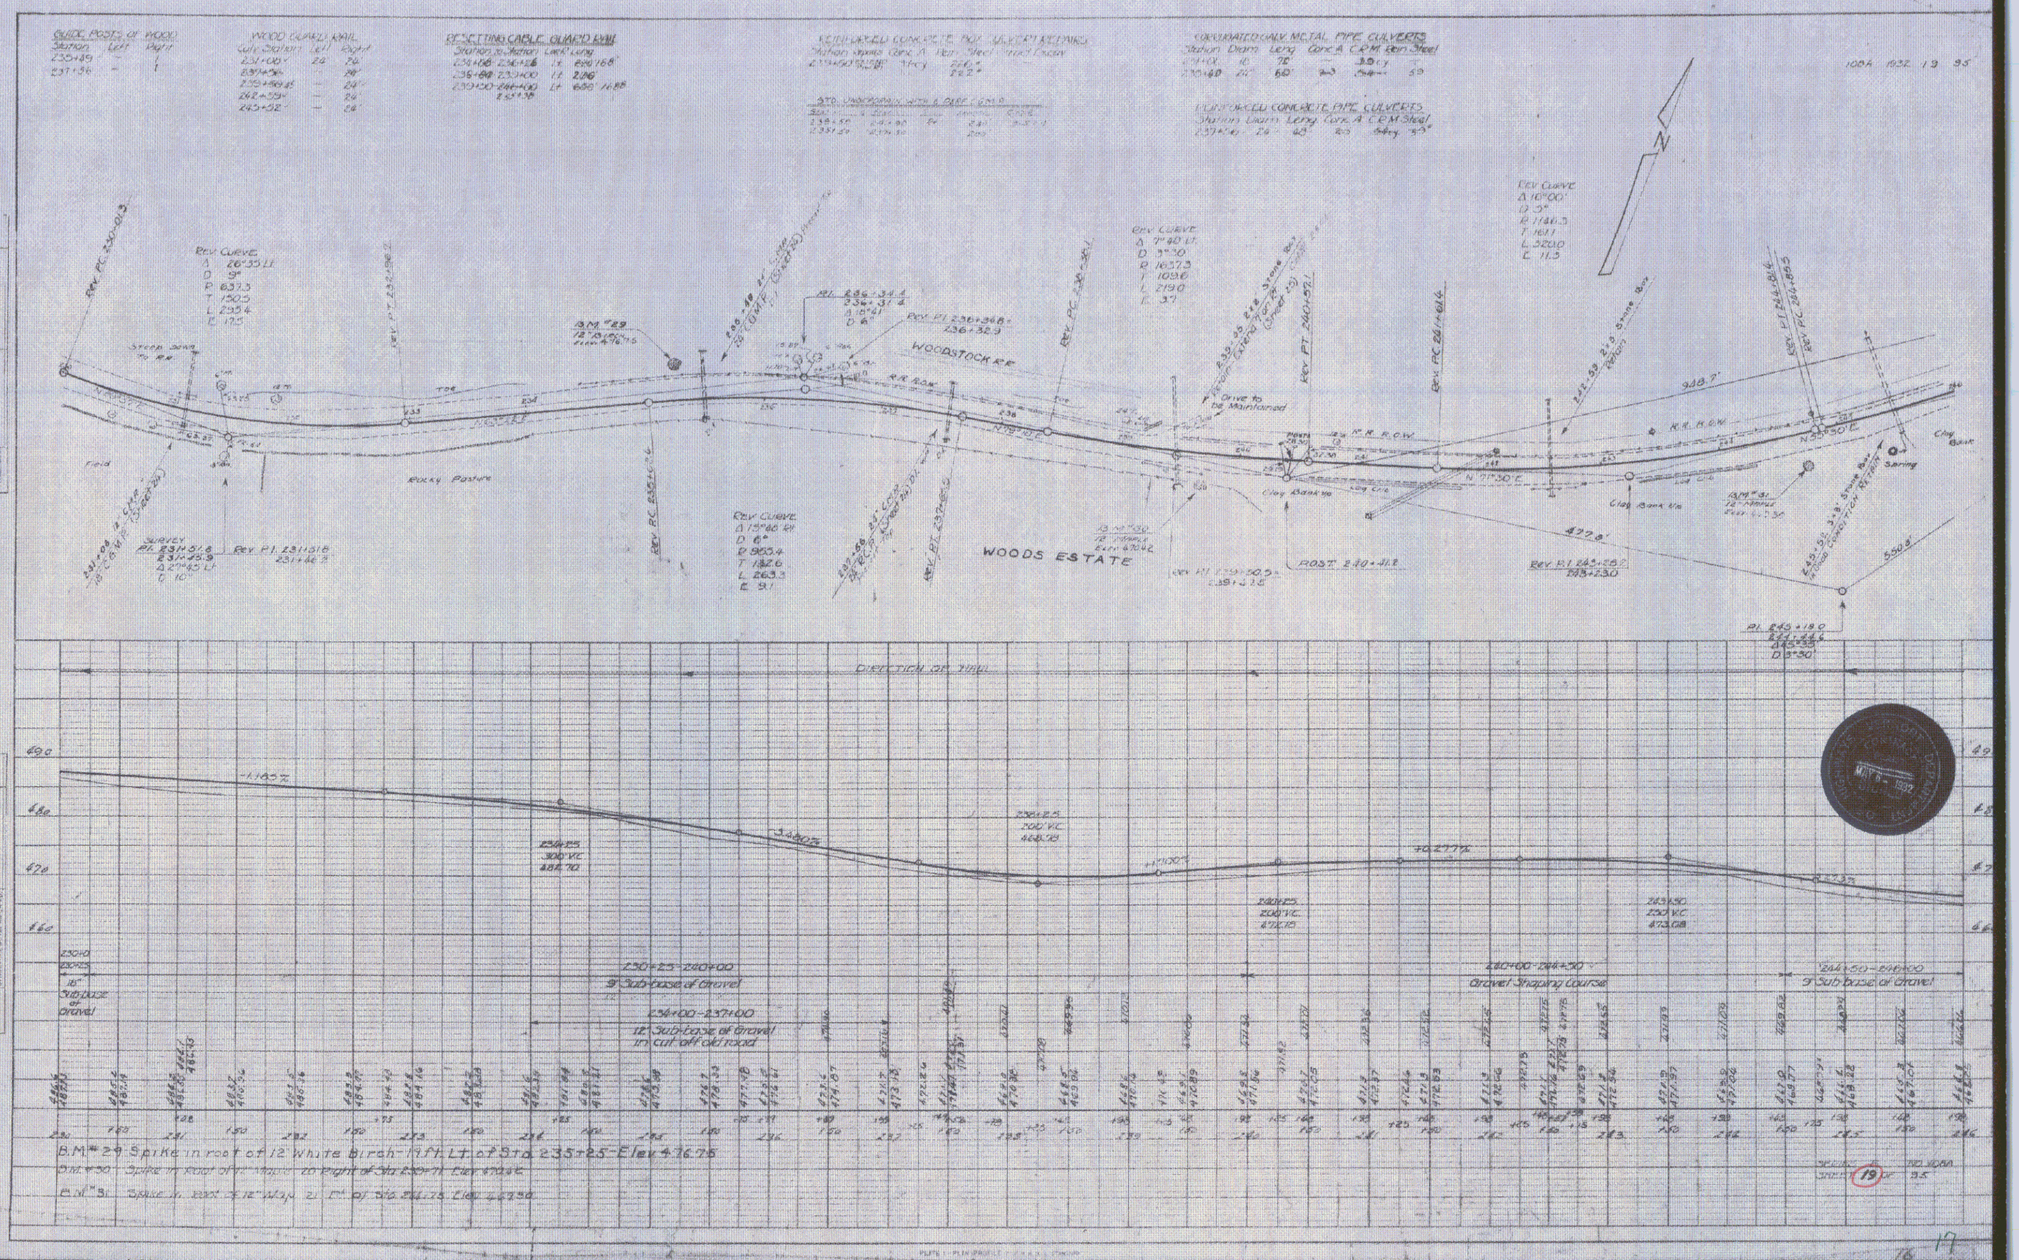

MAY 8 - 1992