GUIDE POSTS OF WOOD

Station	Left	Right
235+49	—	1

WOOD GUARD RAIL

Culv. Station	Left	Right
231+08	24'	24'
237+56	—	24'
238+50	—	24'
242+59	—	24'
245+32	—	24'

RESETTING CABLE GUARD RAIL

Station to Station	Lt. or Rt.	Leng.
234+00-236+22	Lt.	228'
237+00-239+00	Lt.	200'
239+50-246+00	Lt.	650'

REINFORCED CONCRETE BOX CULVERT REPAIRS

Station	Repairs	Conc. A	Rein. Steel	Struct. Excav.
239+50	Vertical Parallel	31 c.y.	2260#	—

CORRUGATED GALV. METAL PIPE CULVERTS

Station	Diam.	Leng.	Conc. A	C.P.M.	Rein. Steel
231+08	18"	72'	—	35 c.y.	—
235+49	24"	60'	—	34 "	

REINFORCED CONCRETE PIPE CULVERTS

Station	Diam.	Leng.	Conc. A	C.P.M.	Steel
237+56	24"	48'	—	34 c.y.	—

NRH 108A (LANDSCAPING)

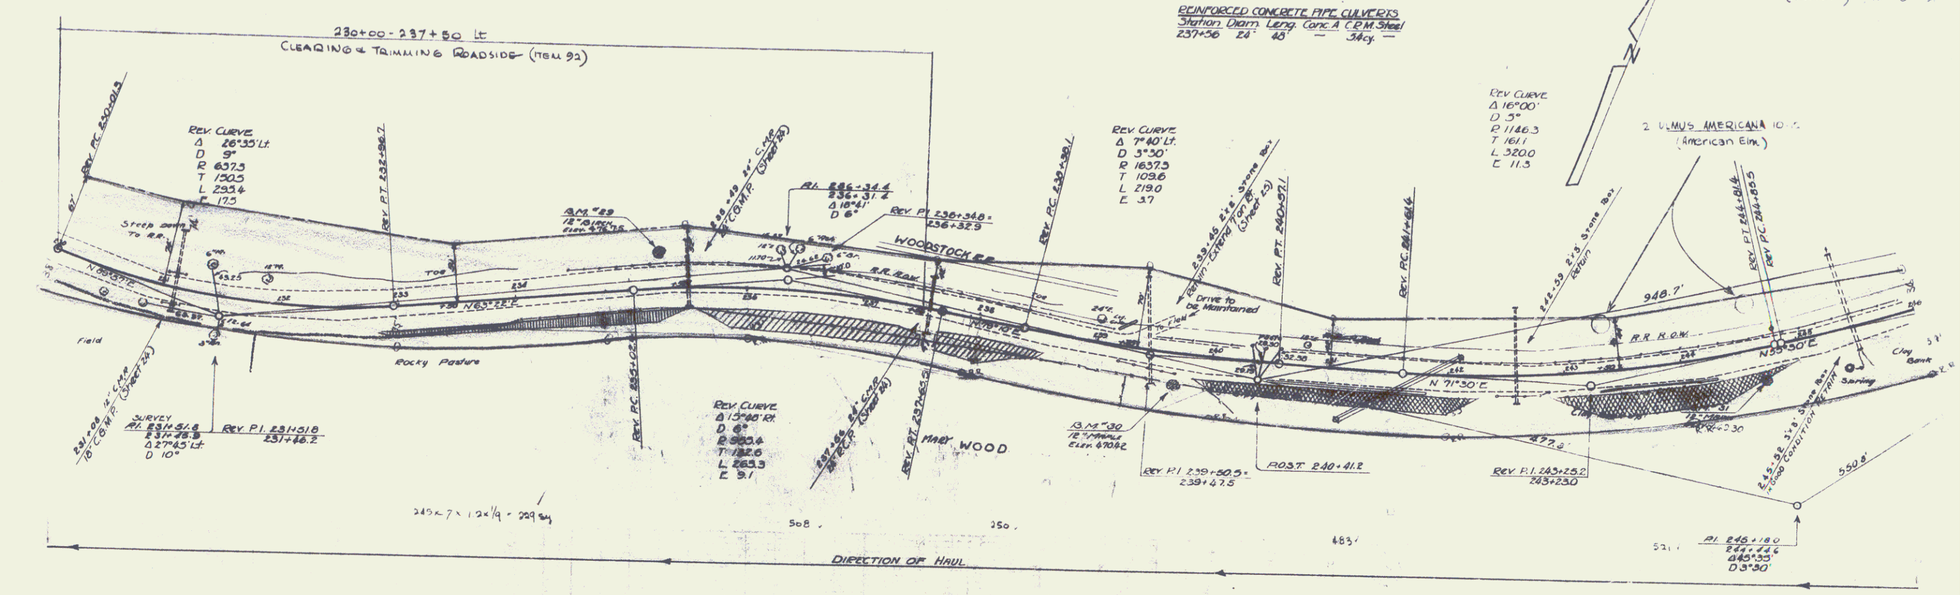

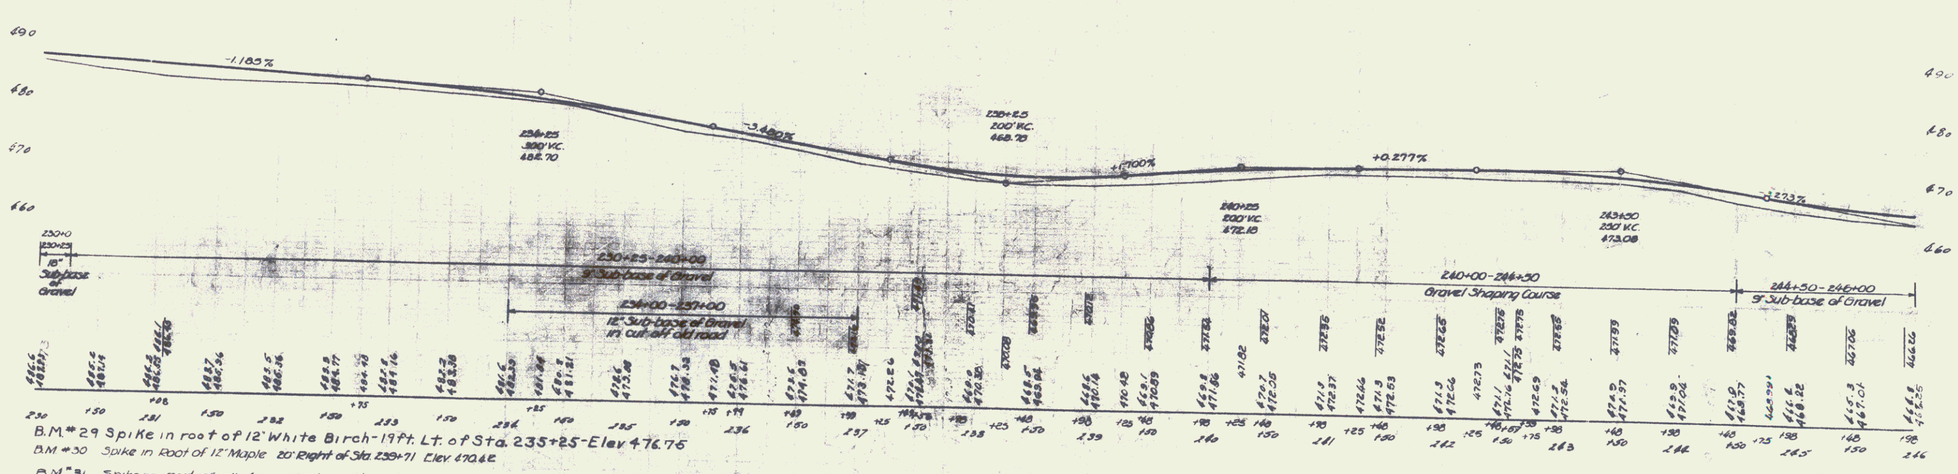

B.M. # 29 Spike in root of 12" White Birch - 19 ft. Lt. of Sta. 235+25 - Elev 476.76

B.M. # 30 Spike in Root of 12" Maple 20' Right of Sta. 239+71 Elev. 470.66

B.M. # 31 Spike in Root of 12" Map. 21 Rt. of Sta 246+75 Elev. 467.30.

SERIES NRH NO. 108A
SHEET 18 OF 2

25