GUIDE POSTS OF WOOD

Station	Left	Right
246+70	—	/
248+70	—	/
250+52	—	/
251+86	—	/
255+11	—	/
256+28	—	/
260+00	—	/

WOOD GUARD RAIL

Culv. Station	Left	Right
256+28	28'	—
260+00	28'	—

RESETTING CABLE GUARD RAIL

Station to Station	Lor R	Leng.
246+00-255+50	LF	950'

Parcel	Kind of Instrument	Date of Instrument	Grantor	Grantee	Recorded Hartford Book	Page	Date	Remarks
A 3.	QCD	10-29-32	Frank W. Newton	St. of Vt.	46	338.9	12-3-32	

CORR. GALV. METAL PIPE CULVERTS

Station	Diam.	Leng.	Conc. A	C.R.M.	Rein. Steel
246+70	15"	48'	15 cy.	18 cy.	157#
248+70	15"	42'	15 --	18 --	157#
250+52	18"	44'	14 --	18 --	111#
251+86	24"	52'	21 --	27 --	157#
253+11	24"	34'	—	34 --	—
254+95	18"	40'	13 cy.	18 --	157#
256+28	15"	42'	13 --	30 --	157#

REINFORCED CONCRETE PIPE CULVERTS

Station	Diam.	Leng.	Conc. A	C.R.M.	Steel
260+00	18"	48'	15 cy.	18 cy.	157#
258+30	15"	36'	15 --	14 --	157#

GROUTED COBBLE GUTTER

Sta. to Sta.	Lor R	Leng.	Width	Area
247+35-254+35	Rt	700'	Variable	638 sy

CEMENT RUBBLE MASONRY RETAINING WALL
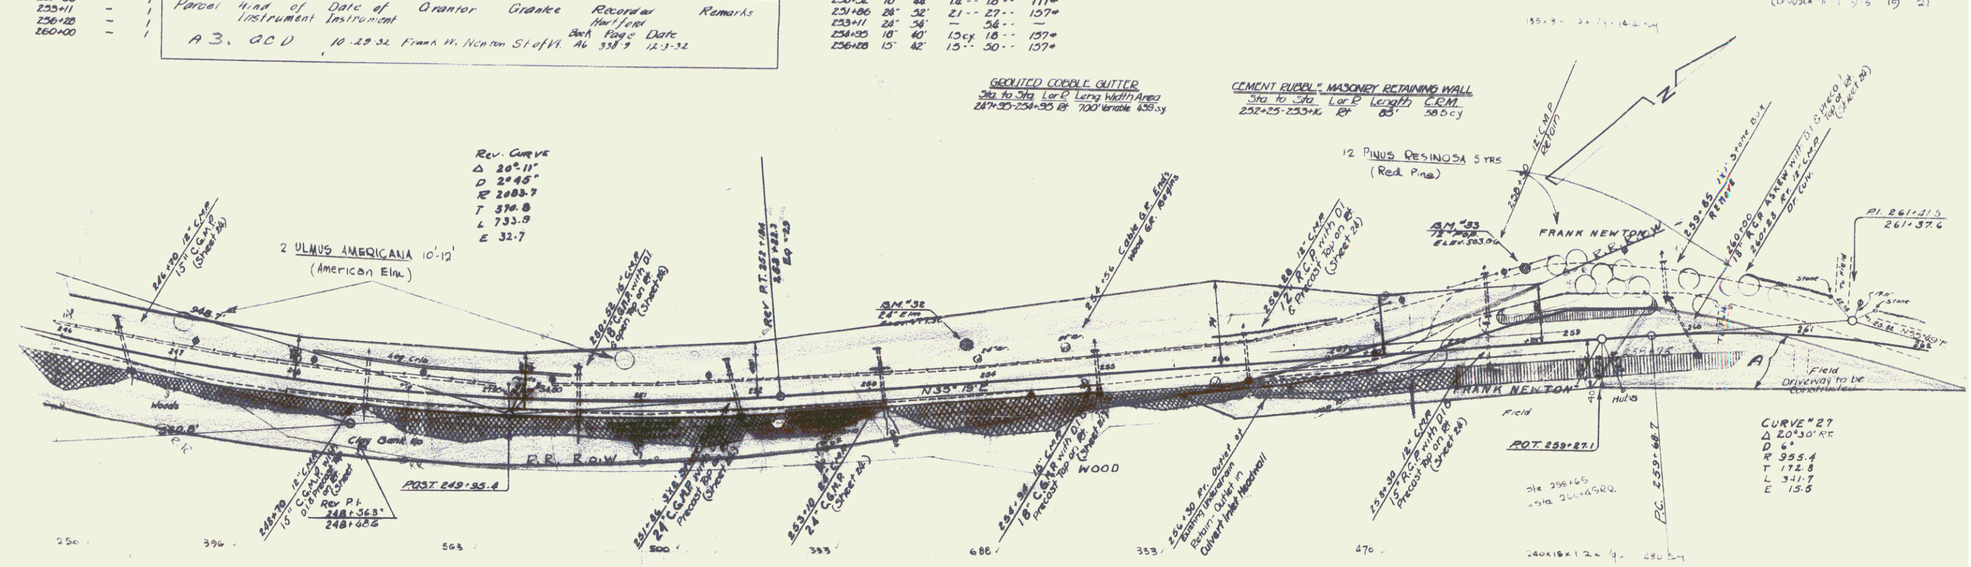
Sta. to Sta.	Lor R	Length	C.R.M.
252+25-253+16	Rt	83'	38.5 cy