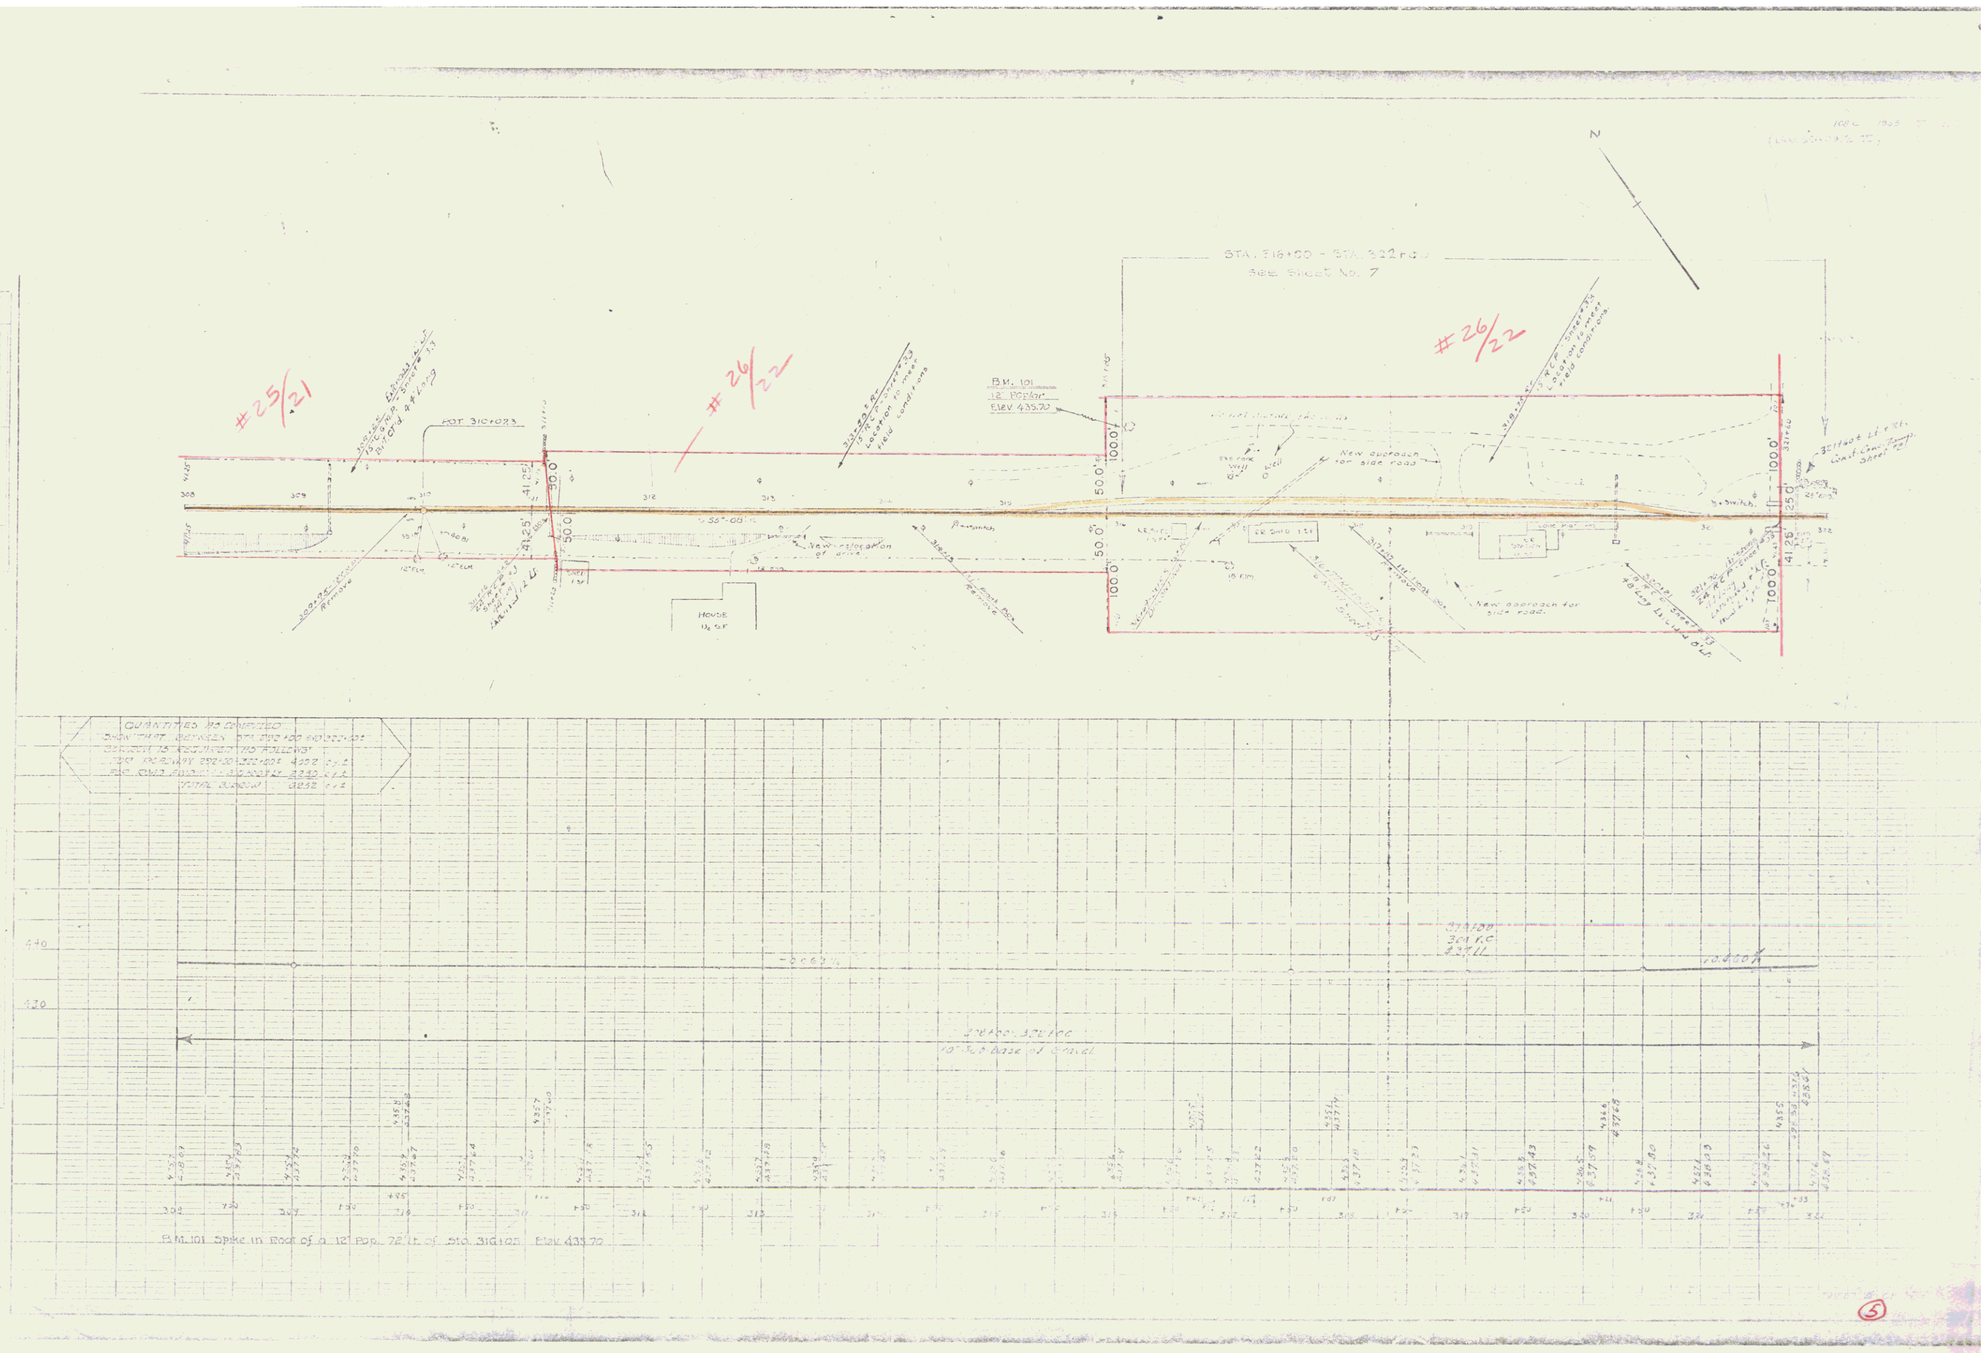
STA. 316+00 - STA. 322+00
See Sheet No. 7
#25/21
#26/22
#26/22
B.M. 101
12" Poplar
Elev. 435.70
New approach for side road
New approach for side road
New relocation of drive
HOUSE
Profile Grade
B.M. 101 Spike in Root of a 12" Pop. 72' Lt. of Sta. 316+00 Elev. 435.70

5

3