| PARCEL | INSTRUMENT | DATE | GRANTOR | GRANTEE | RECORDED HARTFORD BOOK | PAGE | DATE | REMARKS |
|---|---|---|---|---|---|---|---|---|
| A | W.D.O.E | 8 21 45 | C.B FESSENDEN | ST. OF VT. | 50 | 349 | 10 23 45 | |

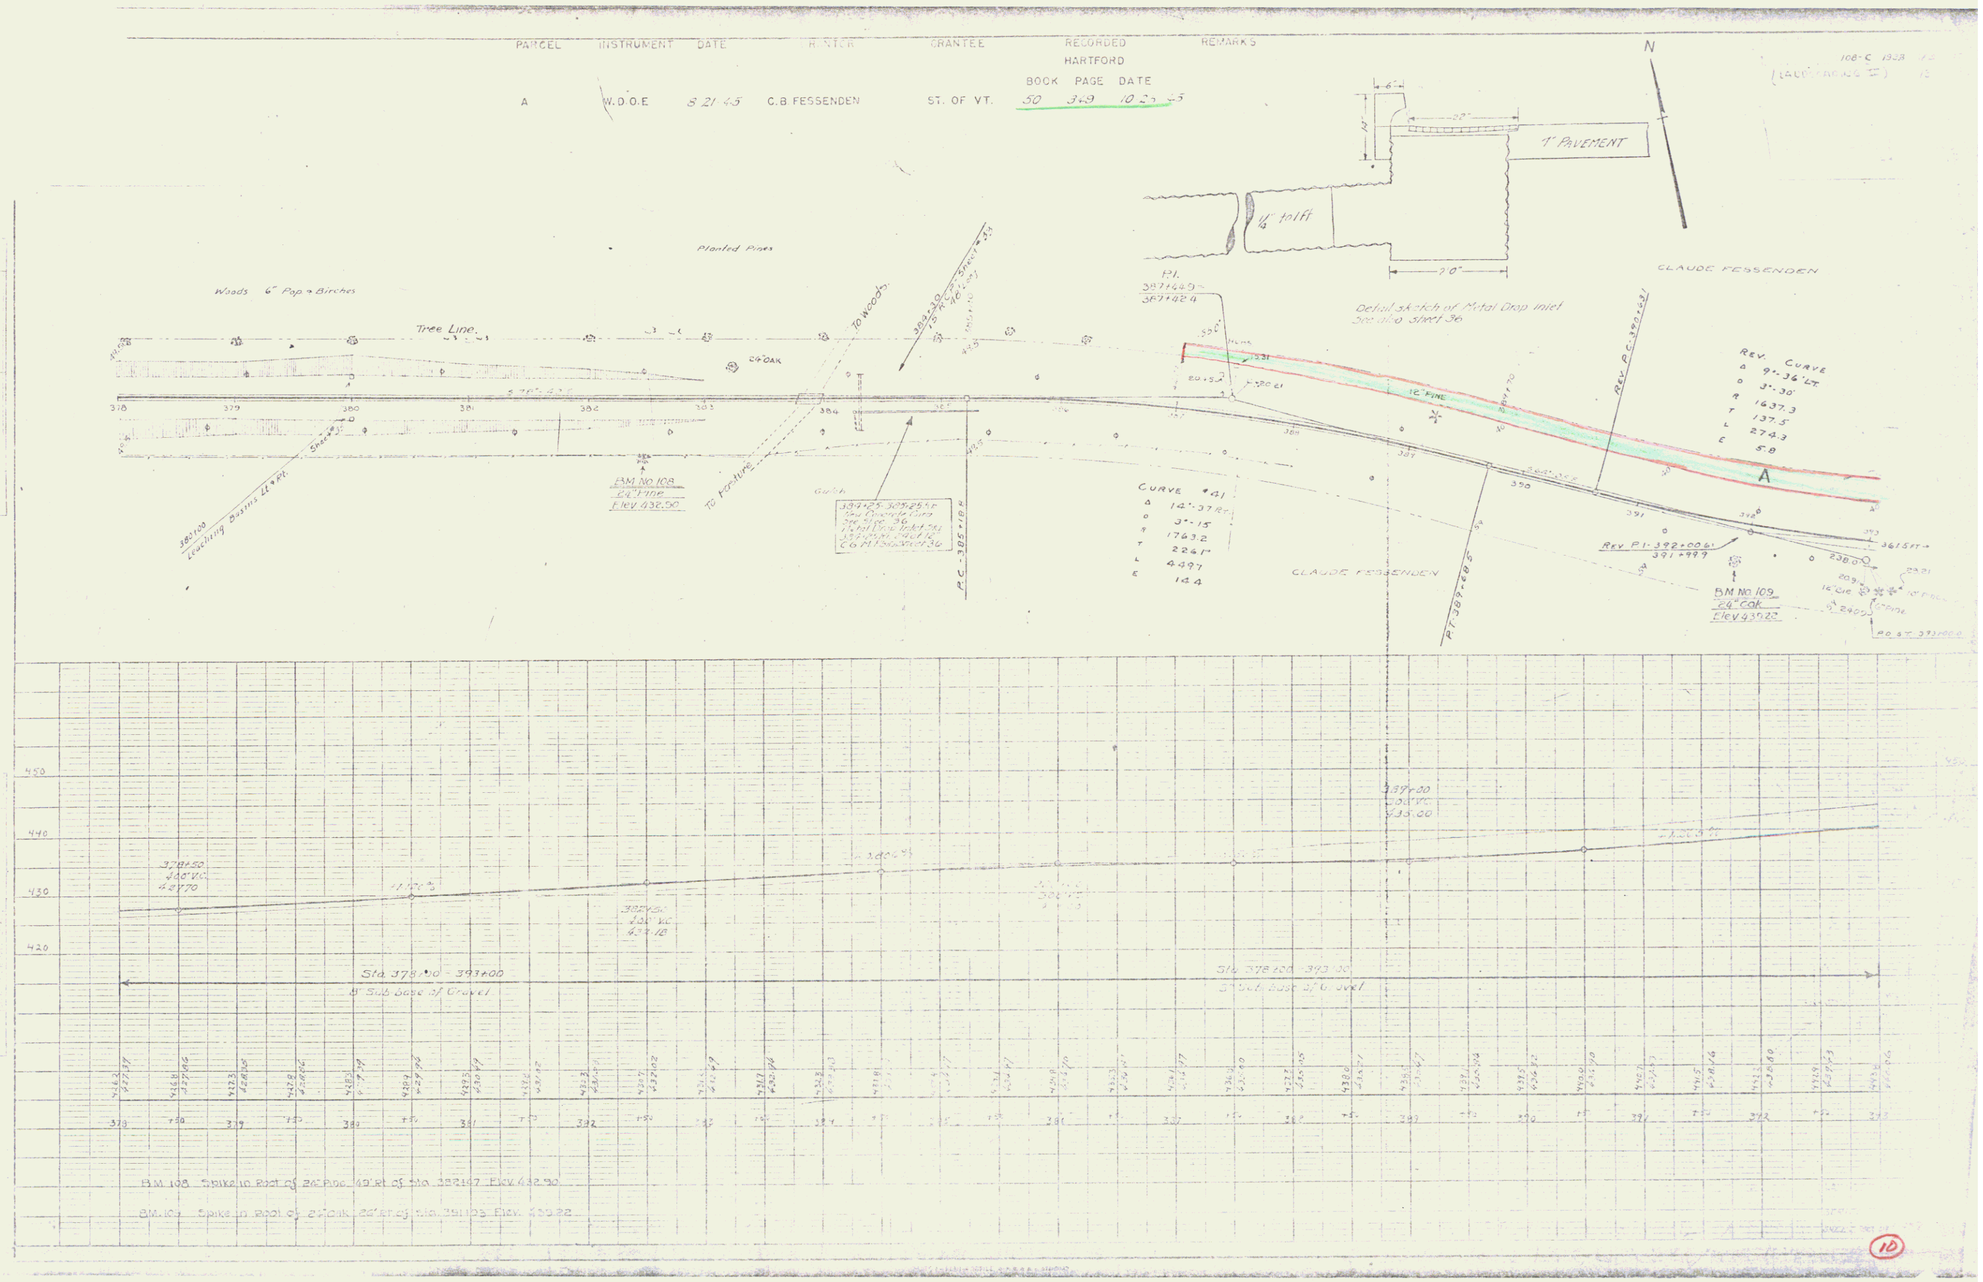


B.M. 108 Spike in Root of 24" Pine 49' Rt of Sta 382+67 Elev 432.50

B.M. 109 Spike in Root of 24" Oak 24' Rt of Sta 391+05 Elev. 430.22