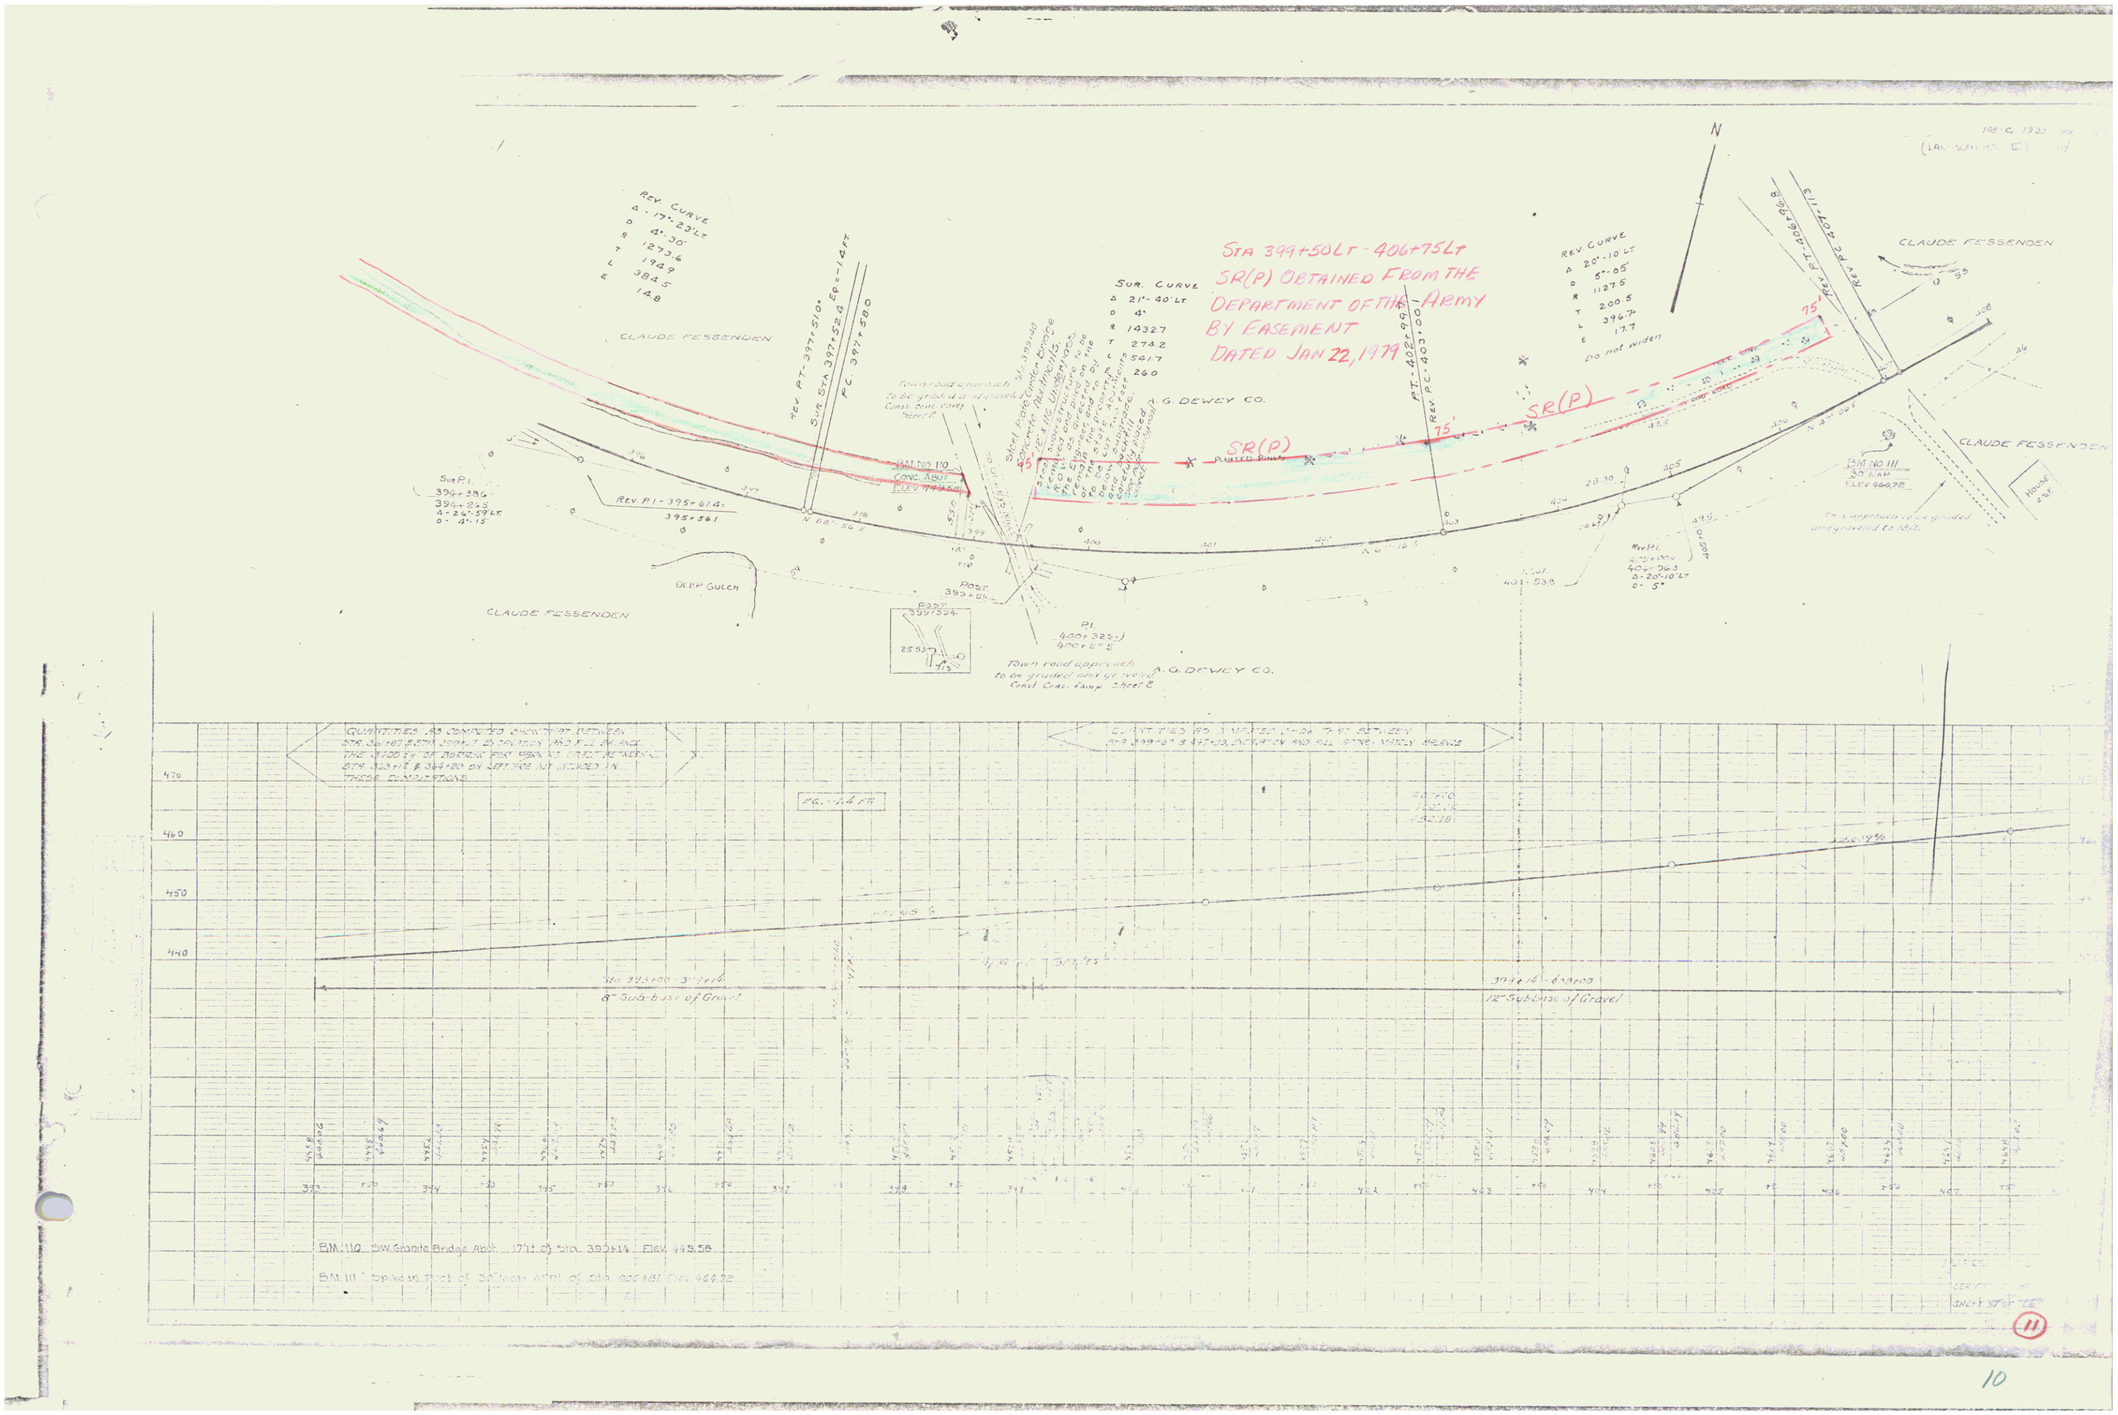
STA 399+50LT - 406+75LT
SR(P) OBTAINED FROM THE
DEPARTMENT OF THE ARMY
BY EASEMENT
DATED JAN 22, 1979
SR(P)
CLAUDE FESSENDEN
DEEP GULCH
A. G. DEWEY CO.
Town road approach
N
BM NO 110
BM NO 111
8" Subbase of Gravel
12" Subbase of Gravel