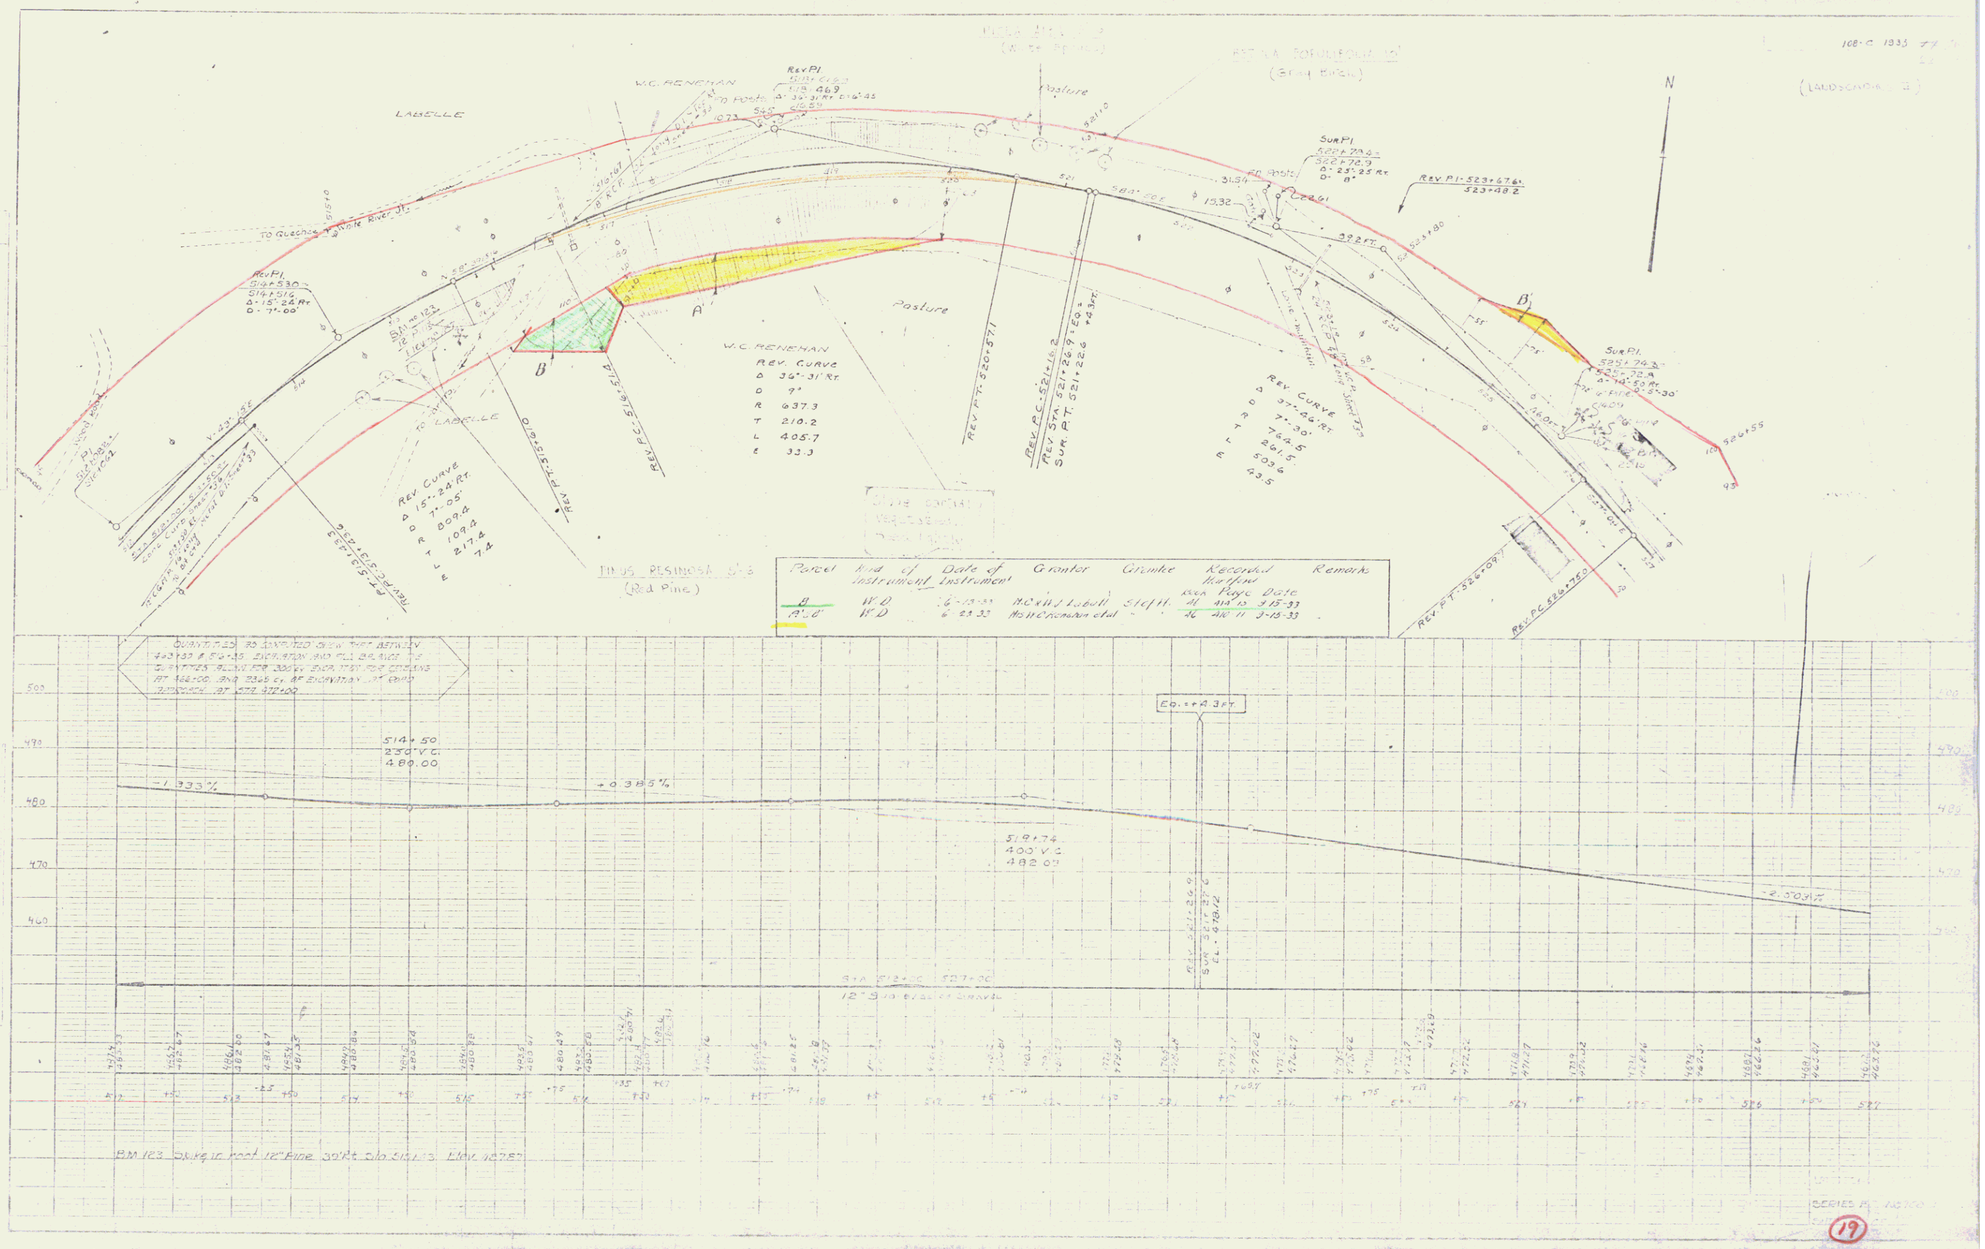
LABELLE
W.C. RENEHAN
Rev. Pi.
Pasture
Sur. Pi.
Rev. Pi. 523+67.61
523+48.2
To Quebec
To Labelle
Rev. Pi.
514+50
514+16
Δ 15°-24' Rt
D 7°-05'
Rev. Curve
Δ 36°-31' Rt
D 9°
R 637.3
T 210.2
L 405.7
E 33.3
Rev. Curve
Δ 97°-46' Rt
T 764.5
861.5
503.6
435
Rev. Curve
Δ 15°-24' Rt
D 7°-05'
R 809.4
T 109.4
L 217.4
E 7.4
Rev. Pi. 520+57.1
Rev. P.C. 521+16.2
Rev. Sta. 521+26.9 = 520+
Sur. P.T. 521+22.6 = 43 Rt.
Rev. P.T. 520+57.1
Rev. P.C. 514+16.2
Rev. P.T. 512+15.3
Rev. P.T. 526+09
Rev. P.C. 526+75.5
Rev. P.C. 523+80
Sur. Pi.
525+74.2
525+72.9
Δ 14°-53' Rt
D 8°-30'
Sur. P.T. 525+55
Pasture
Pasture
Pasture