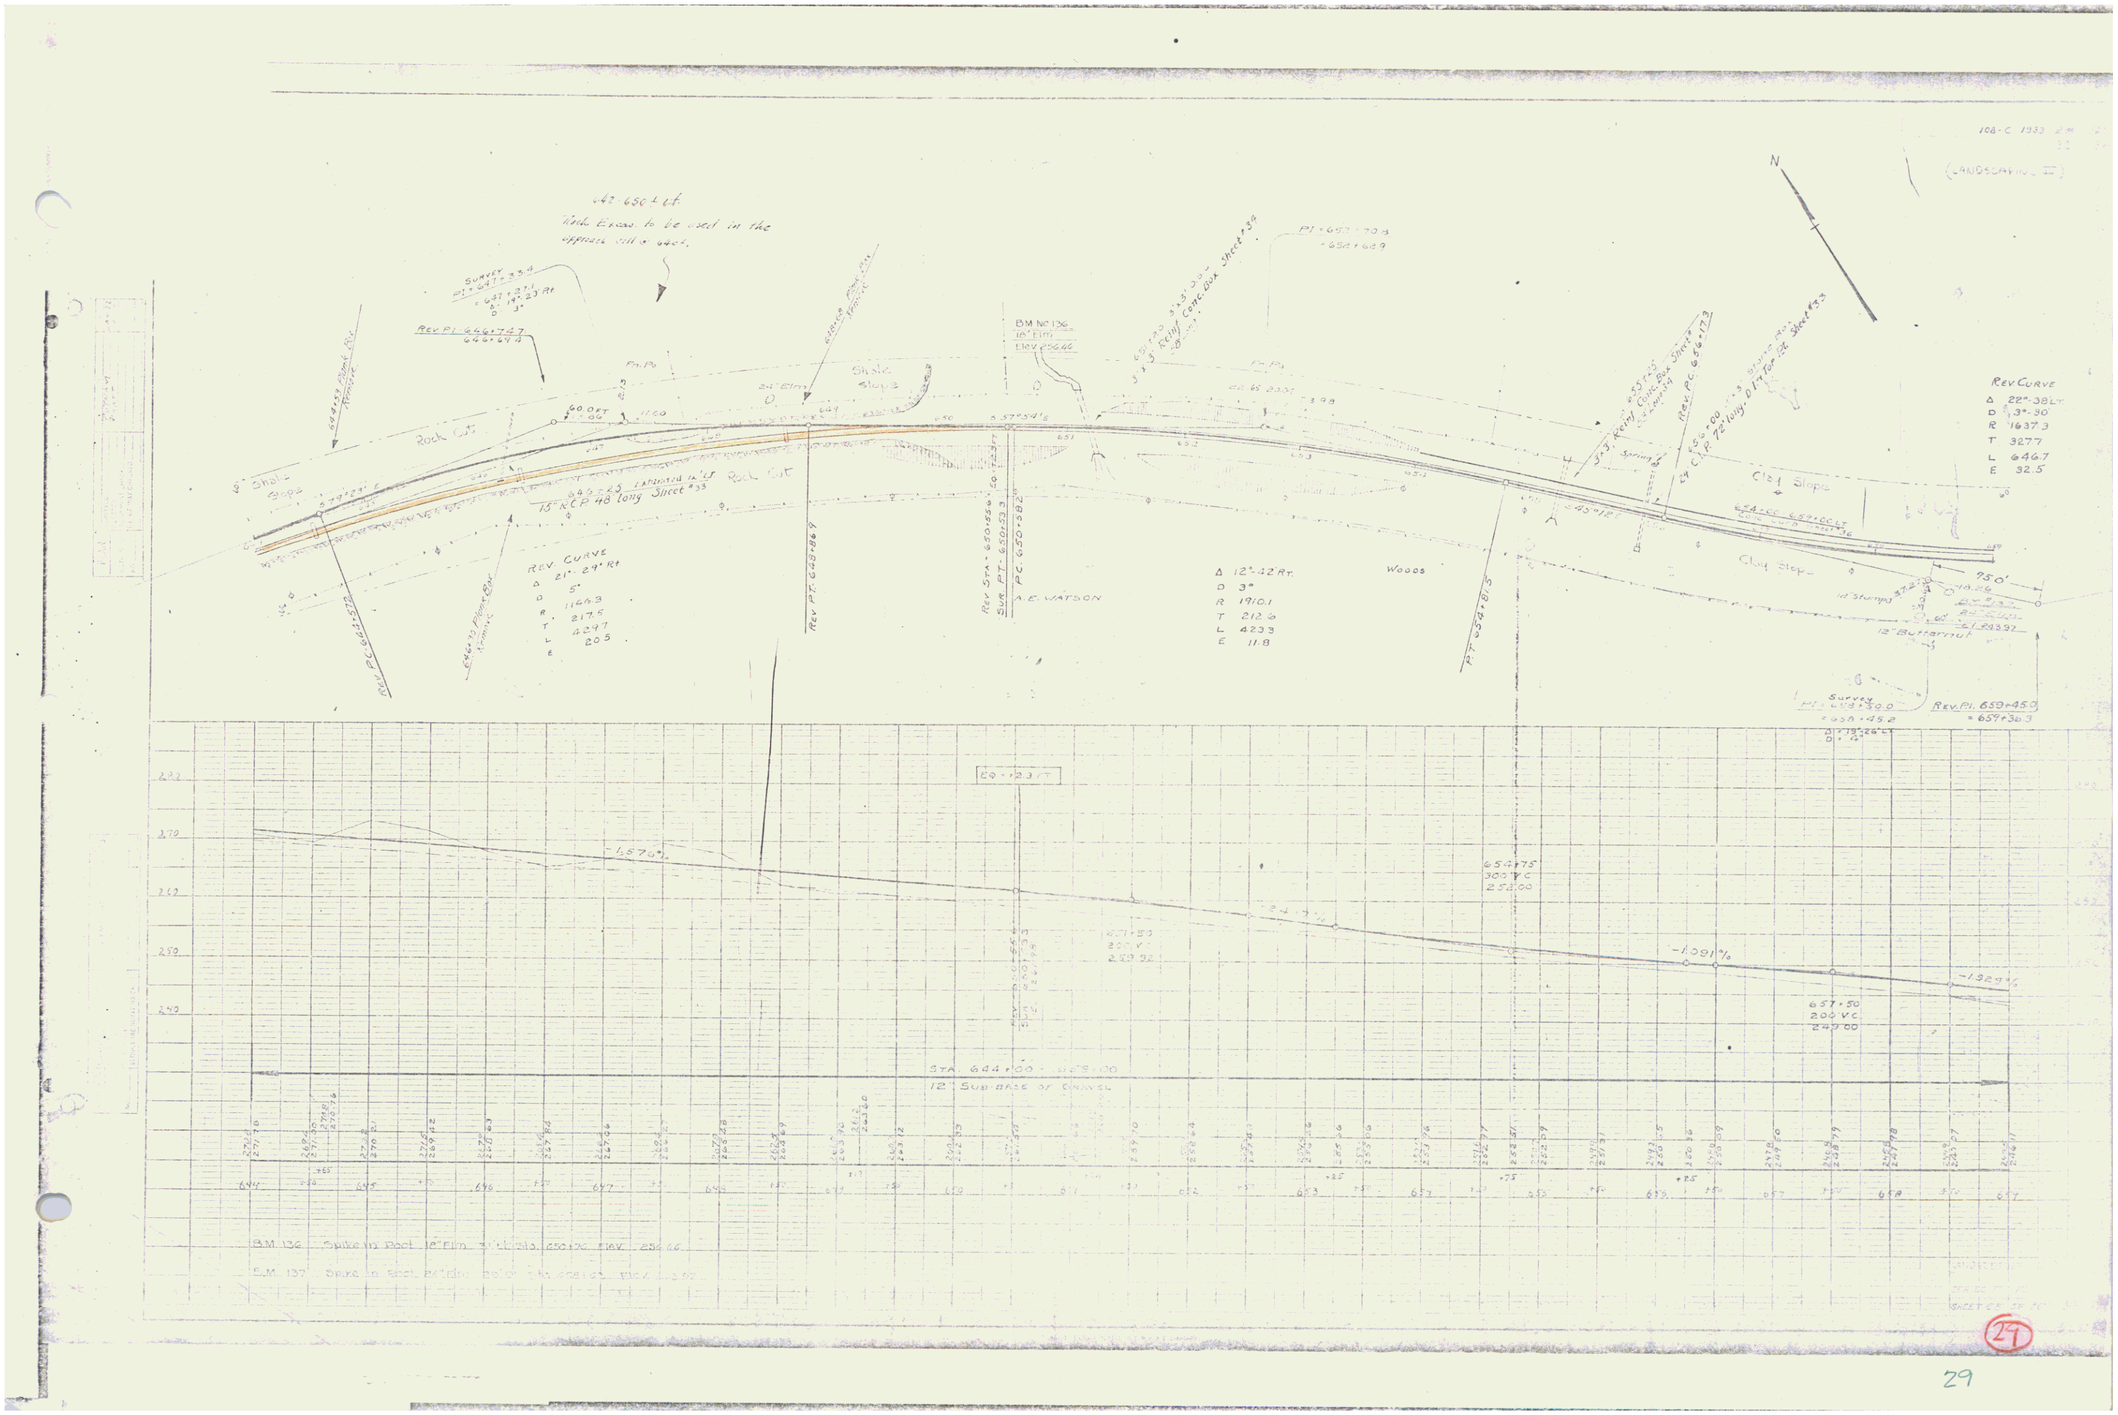
N
Rock Cut
Shale Slope
Clay Slope
Woods
A.E. WATSON
Rev. Curve
Δ 22°-38 Lt
D 3°-30
R 1637.3
T 327.7
L 646.7
E 32.5
Rev. Curve
Δ 21°-24' Rt
D 5°
R 1146.3
T 217.5
L 427.7
E 20.5
Δ 12°-42 Rt
D 3°
R 1910.1
T 212.6
L 423.3
E 11.8
Rev. Pi. 659+45.0
= 659+30.3
-1.091%
-1.329%
12" Sub-base or Gravel