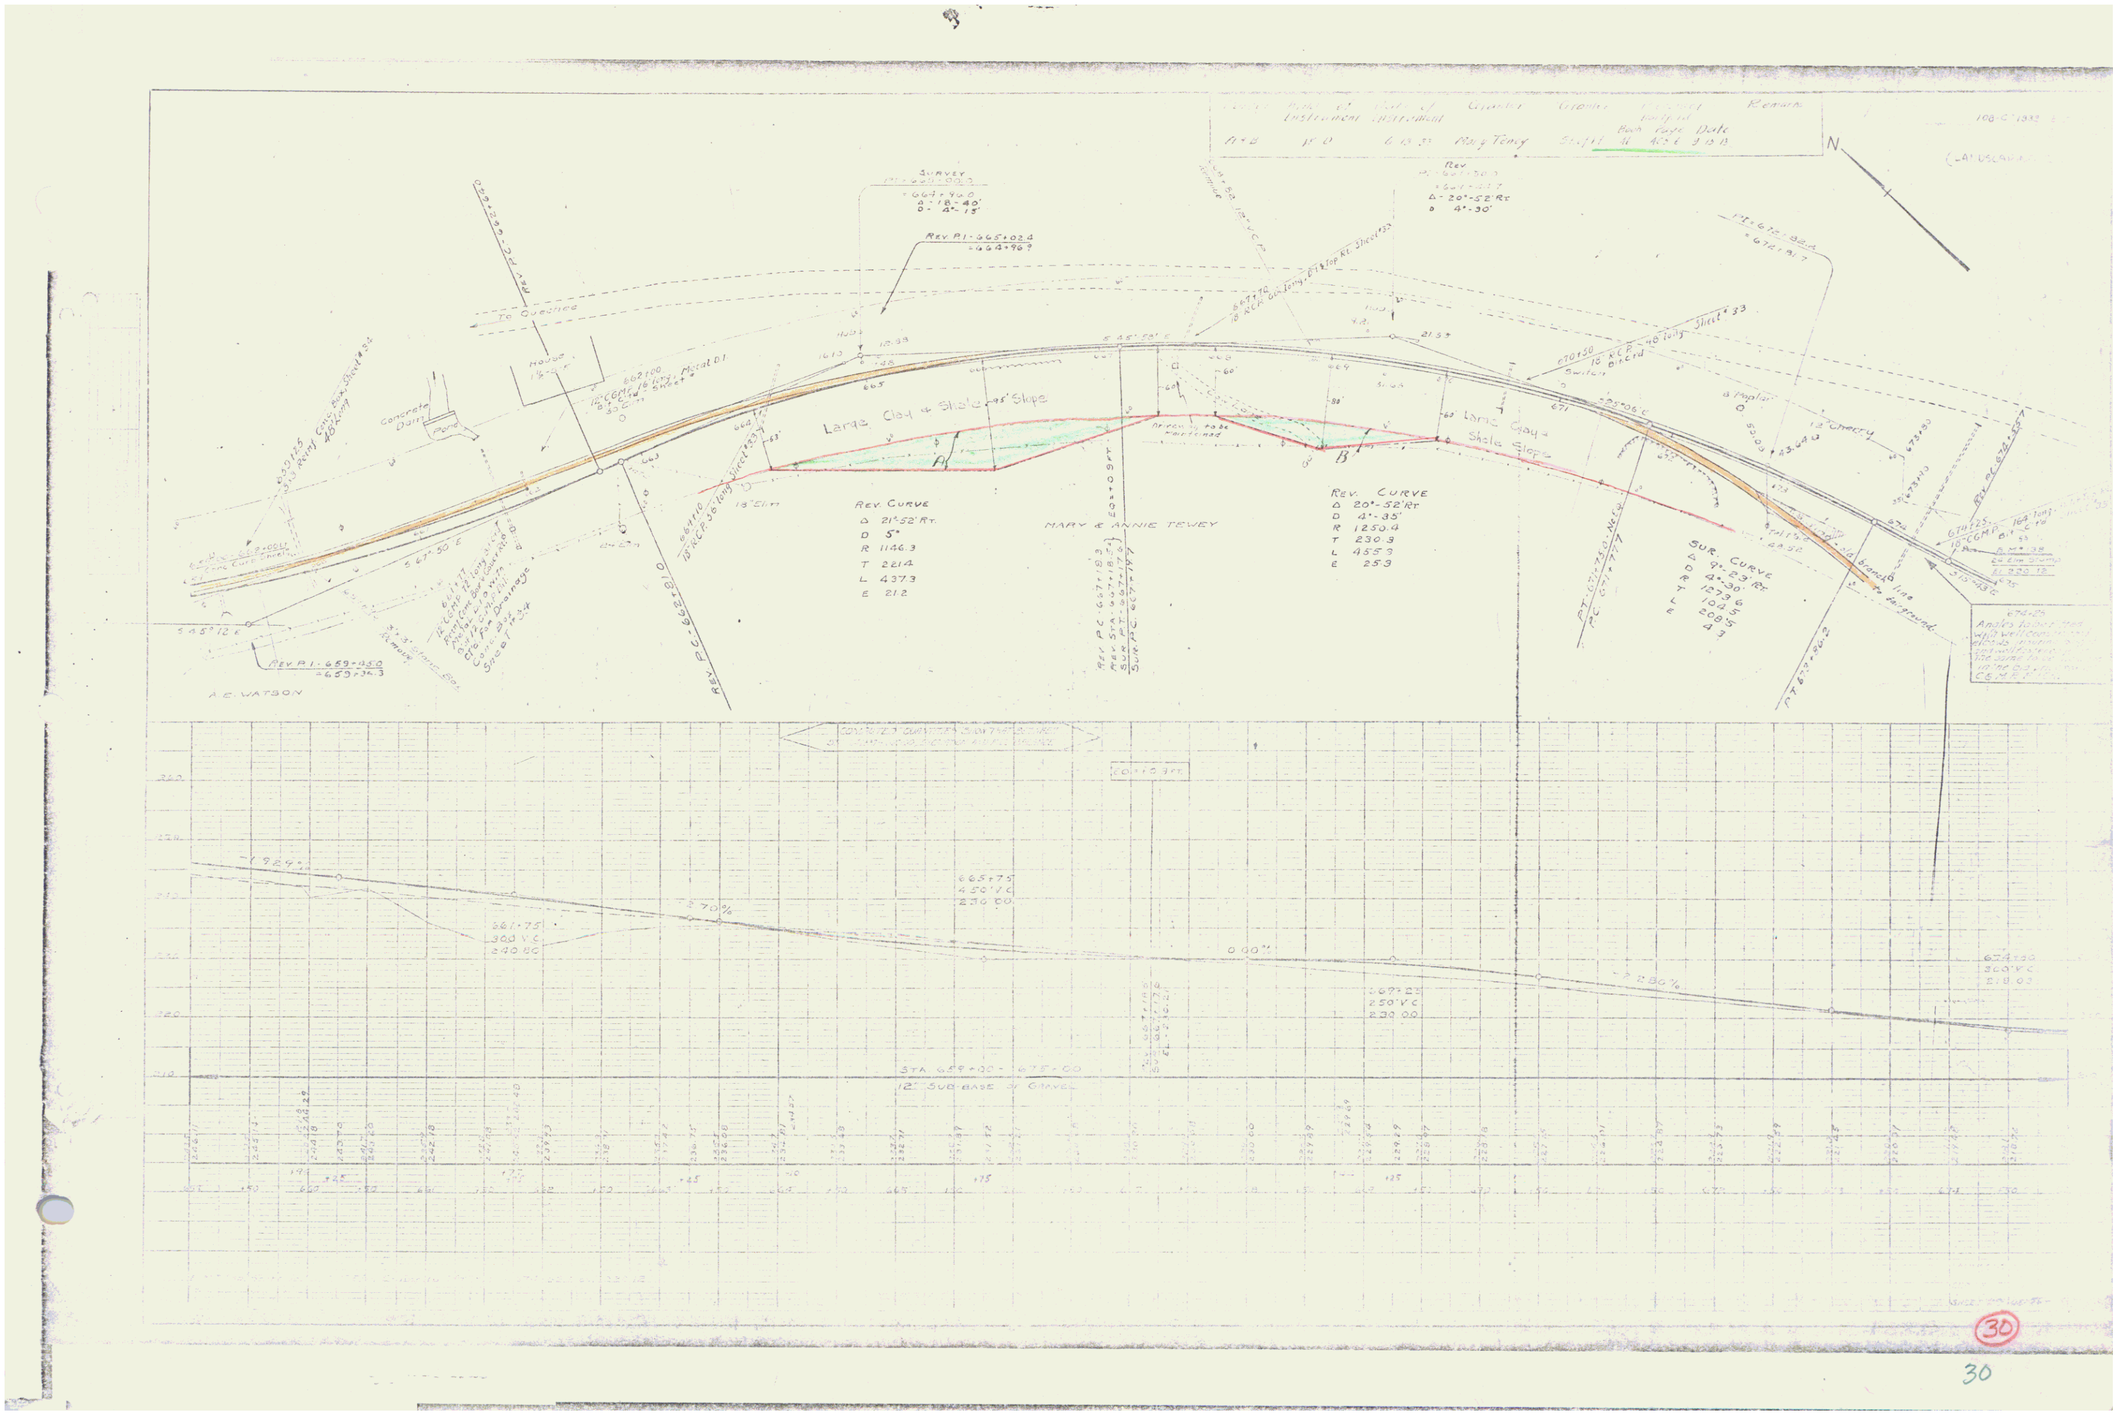
N
Large Clay & Shale Slope
Large Clay & Shale Slope
Rev. Curve
Δ 21°-52' Rt.
D 5°
R 1146.3
T 221.4
L 437.3
E 21.2
Rev. Curve
Δ 20°-52' Rt
D 4°-35'
R 1250.4
T 230.3
L 455.9
E 25.9
Sur. Curve
Δ 9°-23' Rt
D 4°-30'
R 1275.6
T 104.5
L 208.5
E 4.3
MARY & ANNIE TEWEY
A.E. WATSON
To Quechee
House
Concrete Dam
Pond
Rev. PI - 659+050
Rev. PC 662+80
Rev. PT 667+74.7
Sur. PC 667+74.7
Sur. PT 669+83
Rev. PI - 665+024
