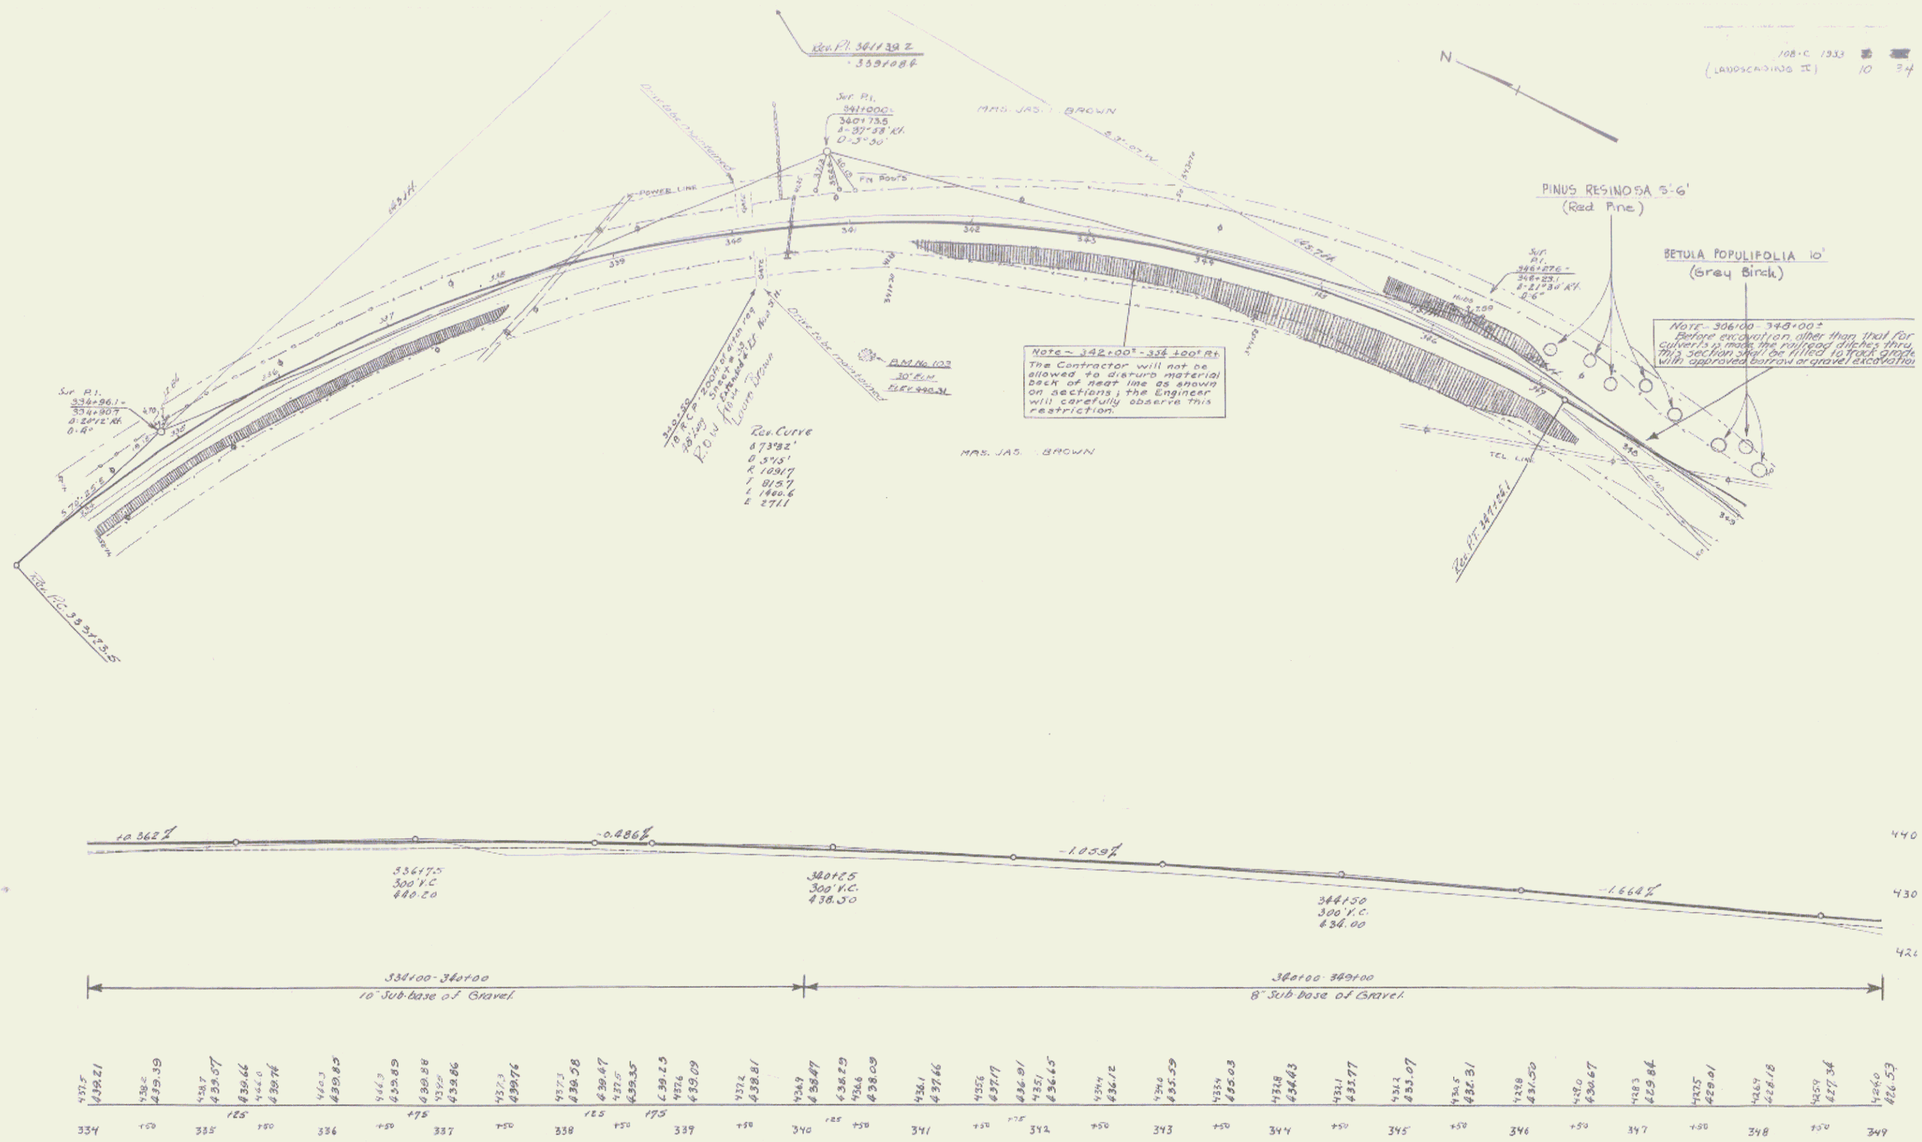
108-C 1933
(LANDSCAPING II)
10 34
N
Rev. Pi. 341+39.2
Sur. Pi. 341+000
MRS. JAS. BROWN
POWER LINE
PINUS RESINOSA 5'-6'
(Red Pine)
BETULA POPULIFOLIA 10'
(Grey Birch)
Note ~ 342+00 - 336+00 Rt.
The Contractor will not be allowed to disturb material back of neat line as shown on sections; the Engineer will carefully observe this restriction.
NOTE - 336+00 - 348+00 ±
Before excavation other than that for culverts to make the railroad ditches thru this section shall be filled to track grade with approved borrow or gravel excavation
B.M. No. 103
30" Elm
Elev. 440.31
Rev. Curve
Δ 73°32'
D 3°15'
R 1091.9
T 815.7
L 1400.6
E 271.1
MRS. JAS. BROWN
TEL LINE
Rev. PI. 341+58.1
+0.362%
-0.886%
-1.059%
-1.664%
336+17.5
300' V.C.
440.20
340+25
300' V.C.
438.30
344+50
300' V.C.
434.00
336+00 - 340+00
10" Sub-base of Gravel
340+00 - 348+00
8" Sub-base of Gravel
B.M. 103 Spike in Root of 30" Elm 110' Rt of Sta. 341+06 Elev. 440.31
(LANDSCAPING II)
SERIES F No. 100 C
SHEET 10 OF 34
42