PARCEL	INSTRUMENT	DATE	GRANTOR	GRANTEE	RECORDED HARTFORD BOOK	PAGE	DATE	REMARKS
"A"	W.D.	10-9-46	A.G. DEWEY, CO.	STOF VT	51	265	10-14-46	

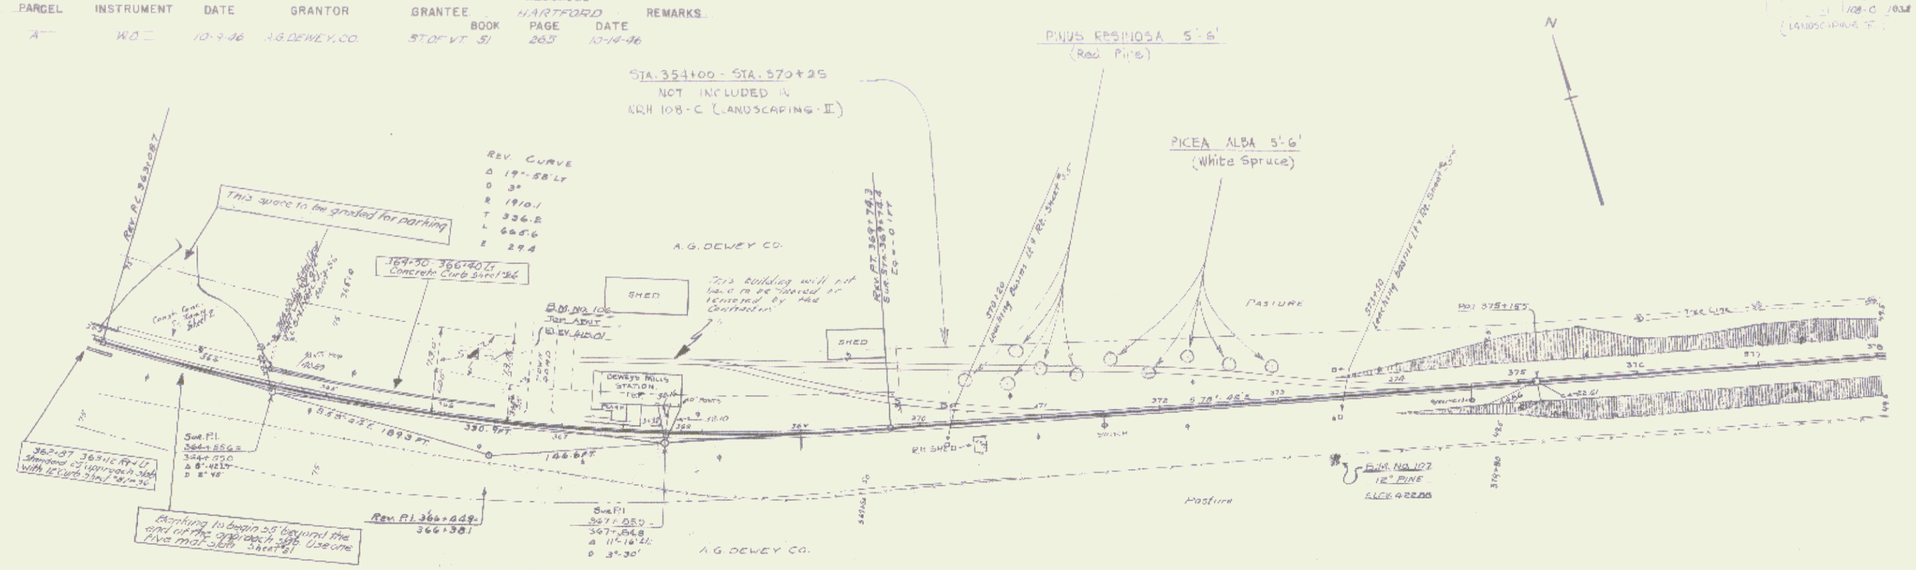

(LANDSCAPING II)
SERIES F No 108C
SHEET 12 OF 12