PARCEL	INSTRUMENT	DATE	GRANTOR	GRANTEE	RECORDED HARTFORD BOOK	PAGE	DATE	REMARKS
A	W.D.O.E	8 21 45	C.B. FESSENDEN	ST. OF VT.	50	369	10 25 45	

108-C 1938
(LANDSCAPING II) 13 34

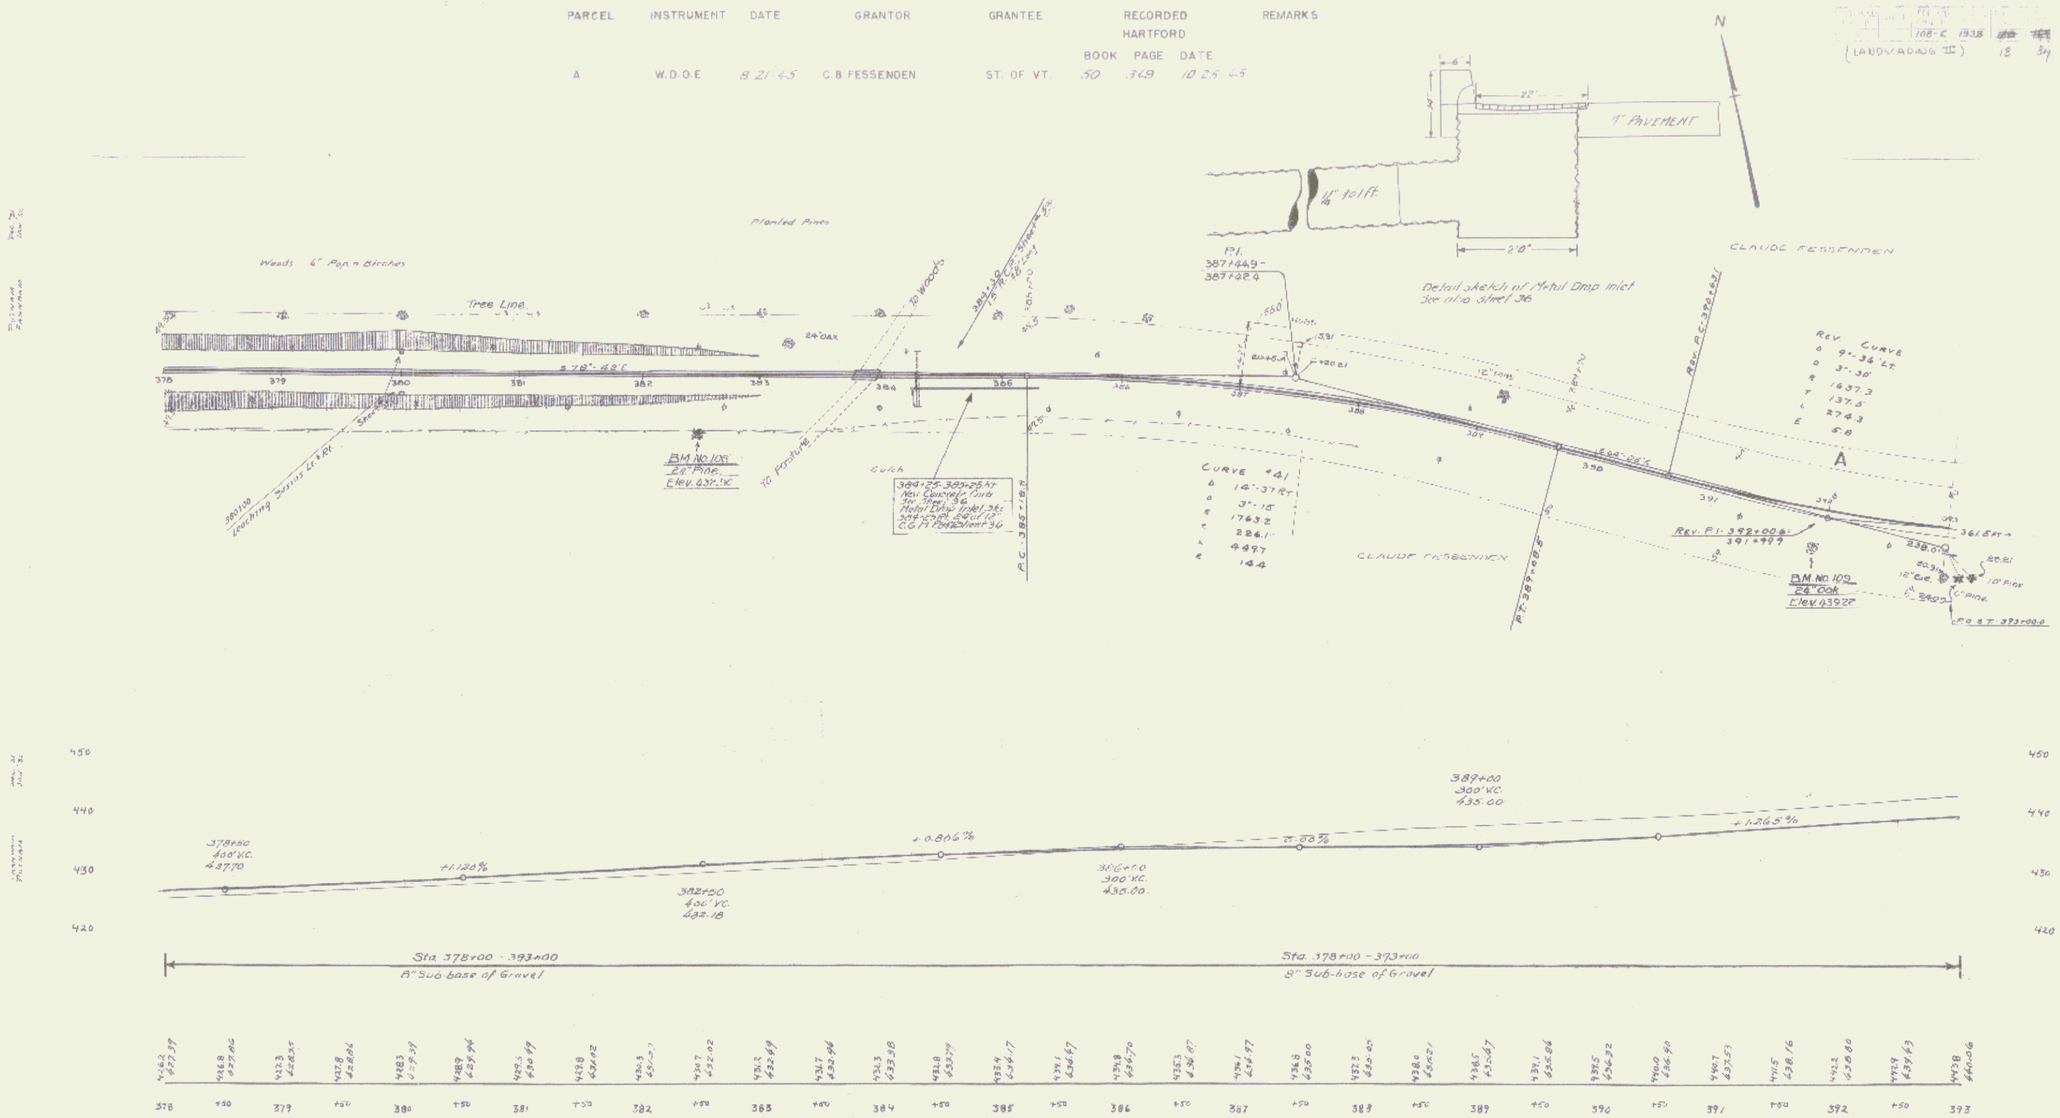

BM. 108 Spike in root of 24" Pine 49 Rt of Sta 382+47 Elev. 432.90

BM. 109 Spike in root of 24" Oak 26' Rt of Sta. 391+93 Elev. 439.22

(LANDSCAPING I)
SERIES 1 No 108 C
SHEET 13 OF 34

45