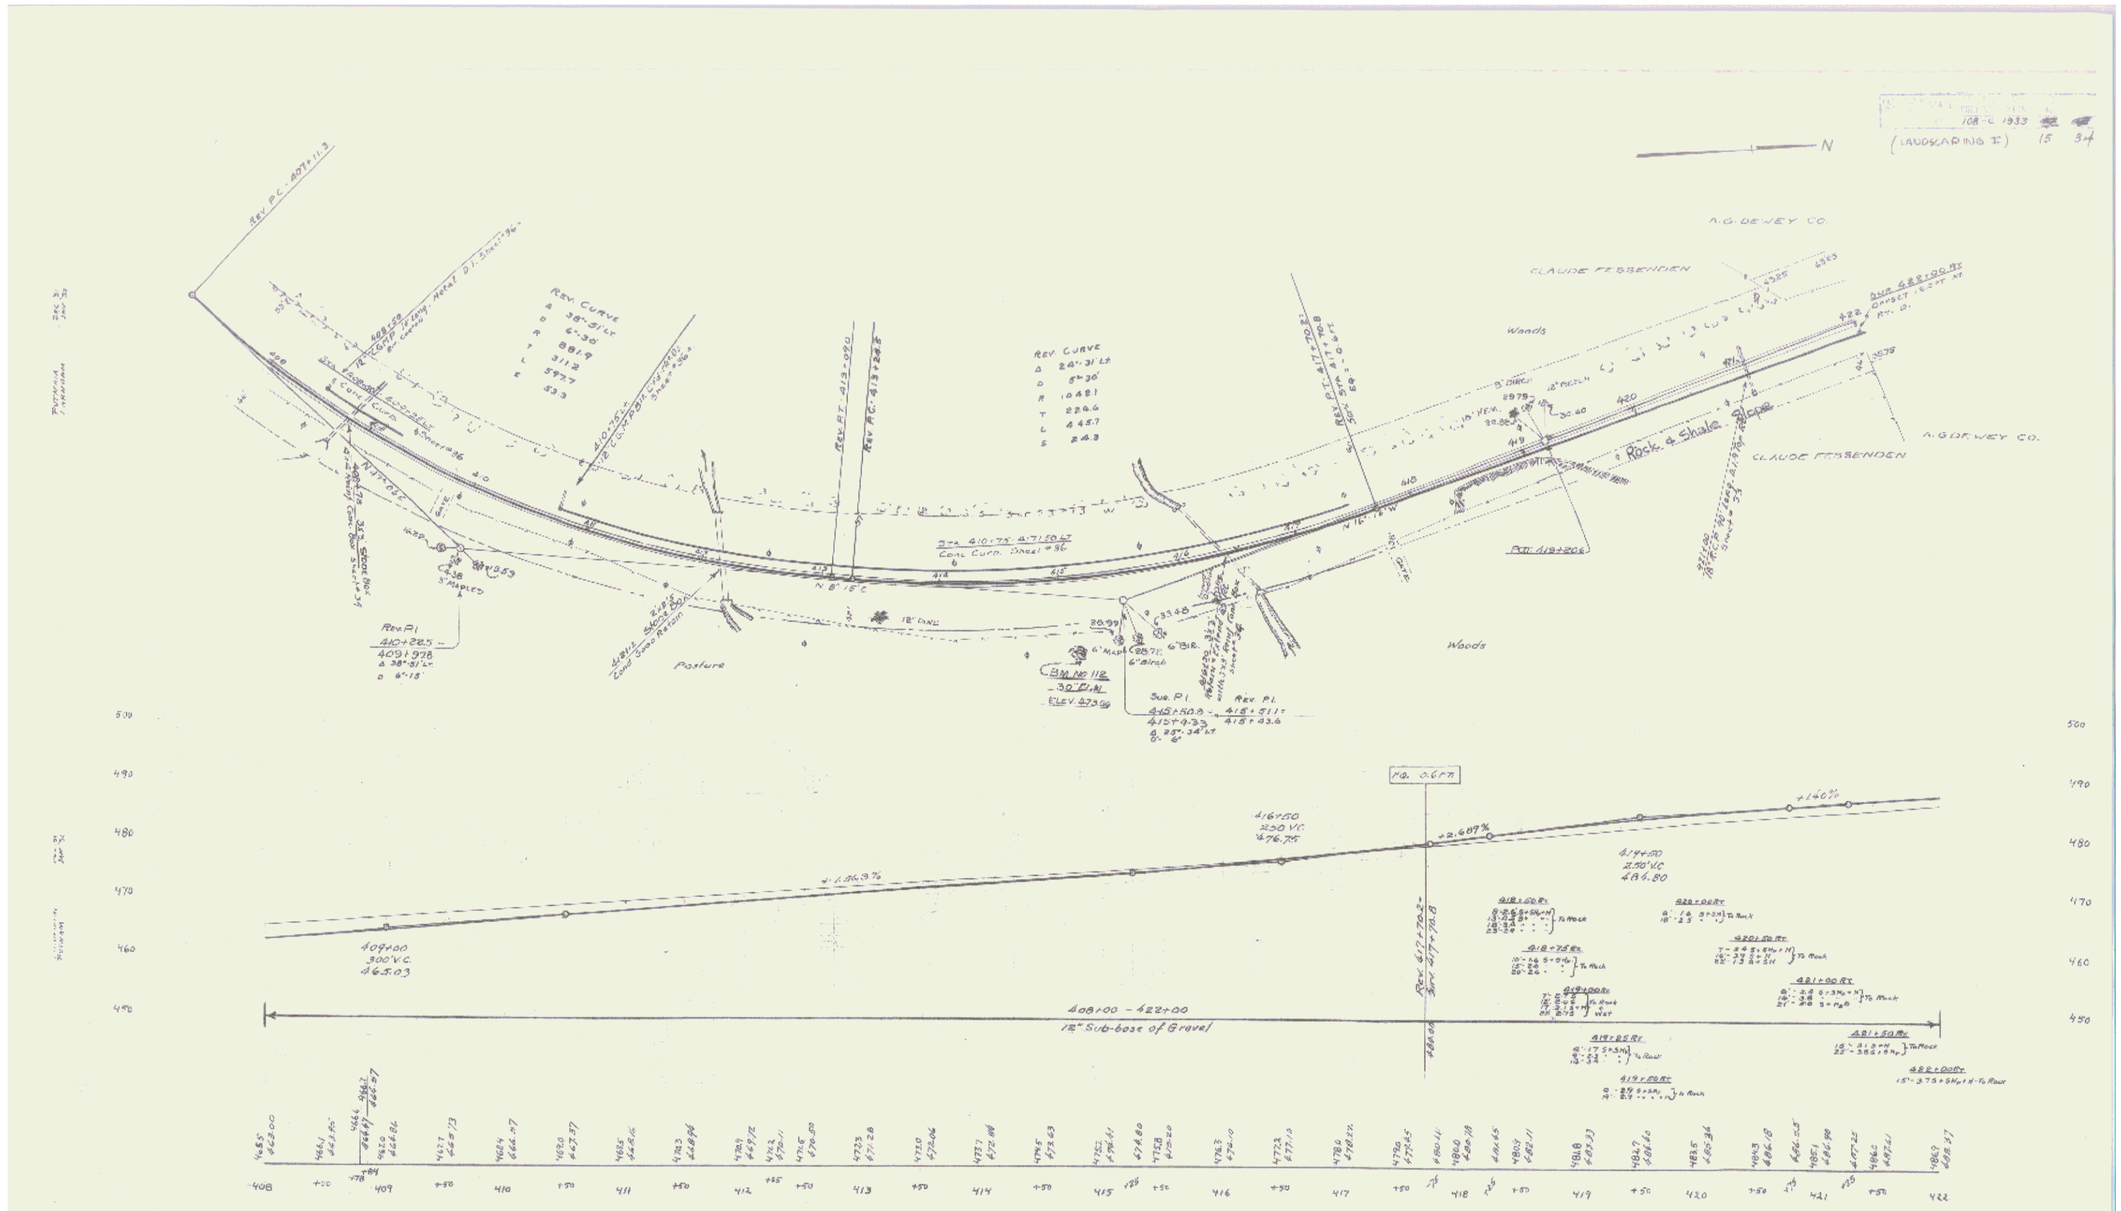
108-C 1933
(LANDSCAPING I) 15 34
N
A.G. DEWEY CO.
CLAUDE FESSENDEN
Woods
Rock & Shale Slope
Pasture
Rev. Curve
Rev. Pl
Sub. Pl
BM. NO 112
30" Elm.
ELEV. 473.56
Rev. Pt. 417+70.8
Rev. Pc. 413+24.8
Rev. Pc. 407+11.3
Rev. Pt. 413+090
Sta. 0.617
+1.86.3%
+2.607%
+1.40%
409+00
300' V.C.
465.03
416+50
250' V.C.
476.75
419+00
250' V.C.
484.80
408+00 - 422+00
12" Sub-base of Gravel
BM. 112 Spike in Root 30" Elm 60' Rt. Sta 415+12 ' Elev. 473.56
(LANDSCAPING II)
SERIES F NO. 108 C
SHEET 15 OF 34