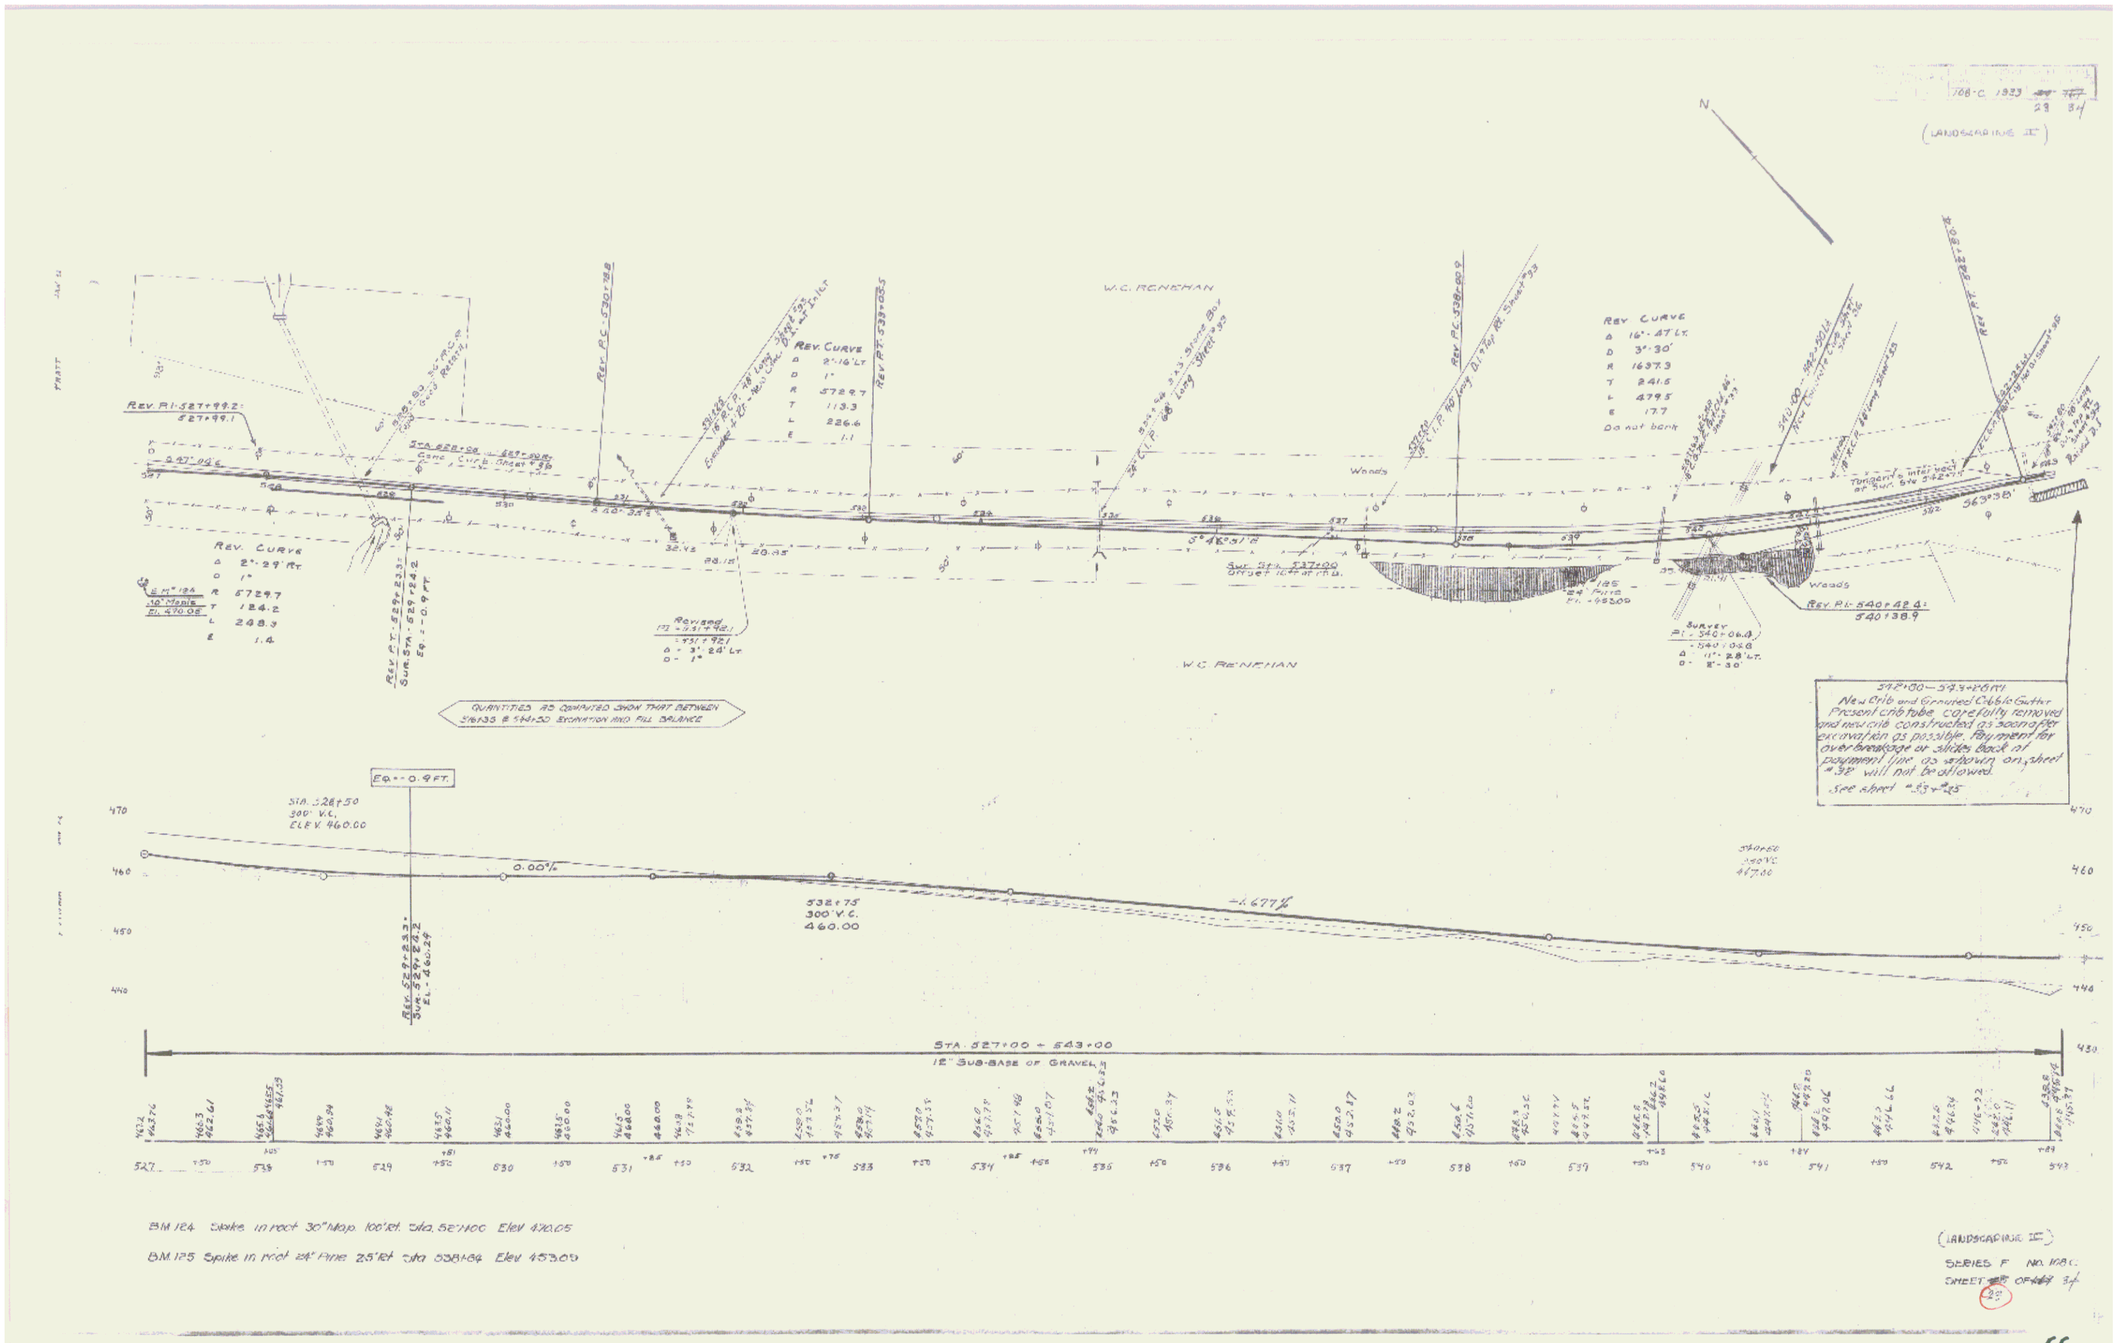
708-C 1923
(LANDSCAPING II)
N
W.C. RENEHAN
Woods
Rev. Pi-527+99.2
527+99.1
Rev. Curve
Δ 2°-29' Rt
D 1°
R 5729.7
T 124.2
L 248.3
E 1.4
Rev. Curve
Δ 2°-16' Lt
D 1°
R 5729.7
T 113.3
L 226.4
E 1.1
Rev. Curve
Δ 16°-47' Lt
D 3°-30'
R 1637.3
T 241.5
L 479.5
E 17.7
Do not bank
Rev. Pi-540+42.4
540+38.9
Survey
Pi-540+06.4
540+05.8
Δ 11°-28' Lt.
D 2°-30'
Revised
Δ 3°-24' Lt
D 1°
Sur. Sta. 537+00
Offset 16' at r.p.
Tangent's intersect at Sur. Sta. 542+77
563°38'
QUANTITIES AS COMPUTED SHOW THAT BETWEEN STA 533 & 544+50 EXCAVATION AND FILL BALANCE
542+00 — 543+26 (±)
New Crib and Grouted Cobble Gutter
Present crib tube carefully removed and new crib constructed as soon after excavation as possible. Payment for overbreakage or slides back of pavement line as shown on sheet #32 will not be allowed.
See sheet #33+#35
EQ.=-0.9 FT.
STA. 528+50
300' V.C.
ELEV. 460.00
0.00%
532+75
300' V.C.
460.00
-1.677%
STA. 527+00 + 543+00
12" SUB-BASE OF GRAVEL
BM 124 Spike in root 30" Map 100' Rt. Sta. 527+00 Elev 470.05
BM 125 Spike in root 24" Pine 25' Rt Sta 538+84 Elev 453.09
(LANDSCAPING II)
SERIES F NO. 108 C.
SHEET 28 OF 34