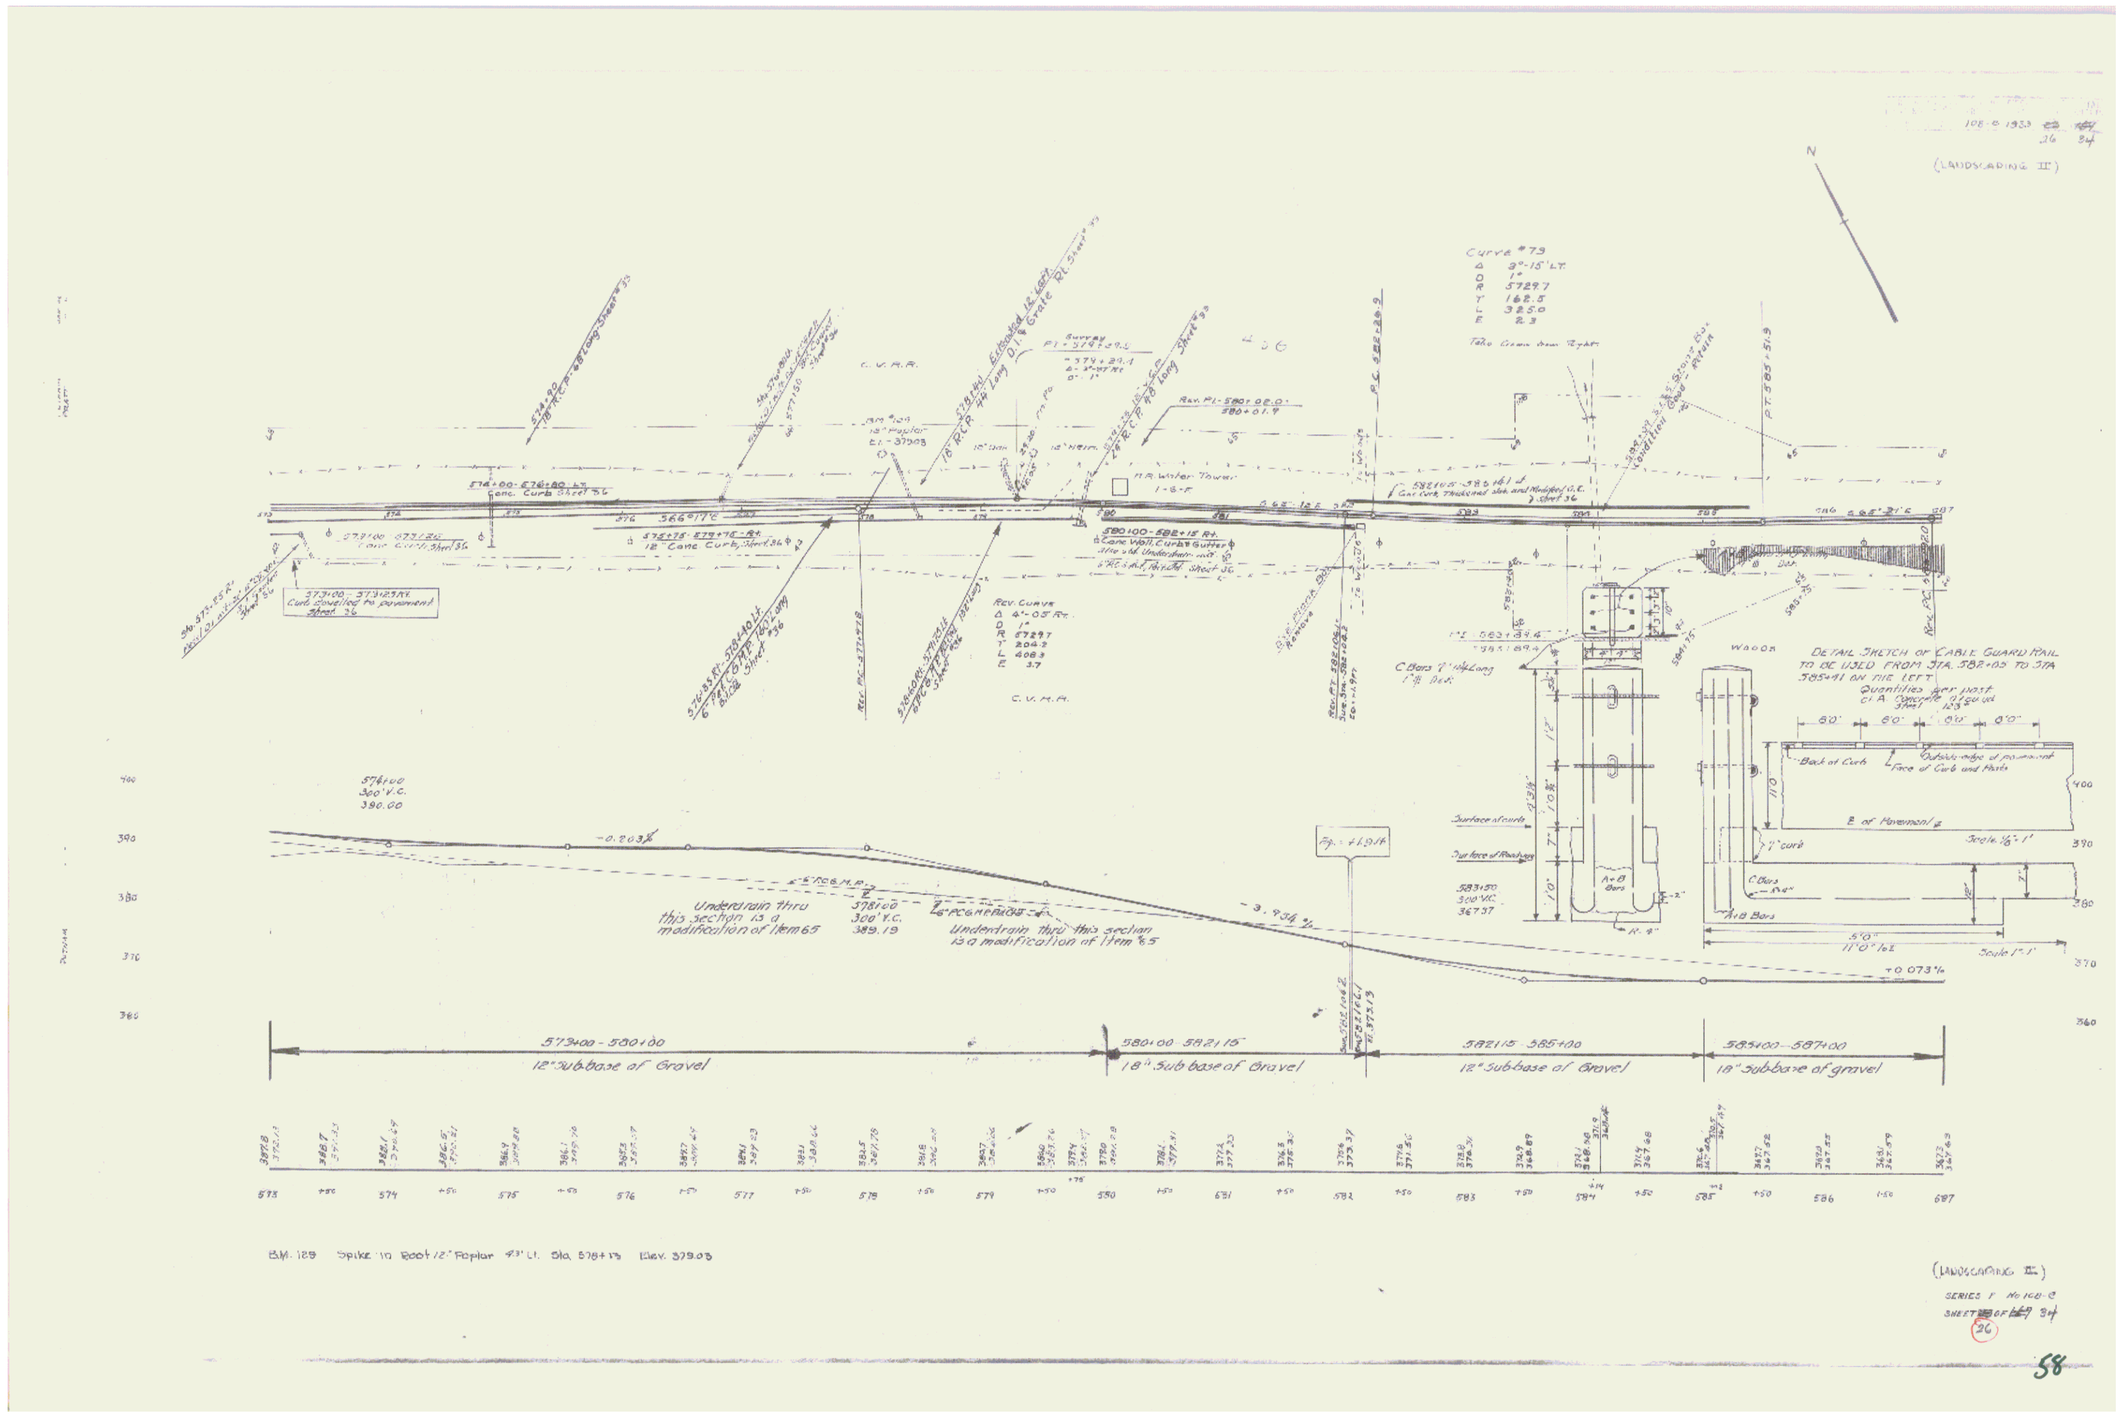
(LANDSCAPING II)
Curve #73
Δ 9°-15' LT.
D 1°
T 162.5
L 325.0
E 2.3
Take Crown from Right
C.V.R.R.
Rev. Curve
Δ 4°-05' Rt.
D 1°
T 204.2
L 408.3
E 3.7
Rev. Pl-580+02.0
580+61.9
P.C. 582+26.9
P.T. 585+51.9
N.R. Water Tower
1-6-T
Curb Wall, Curb & Gutter
Curb Wall, Tapered Slab, and Modified C.L.
Curb Wall, Curb & Gutter
Curb Wall, Curb & Gutter
Curb Dowelled to pavement
Sheet 36
Wagon
Detail Sketch of Cable Guard Rail to be used from Sta. 582+00 to Sta. 585+91 on the left
Quantities for post
Back of Curb
Outside edge of pavement
Face of Curb and Plate
℄ of Pavement
Surface of curb
Surface of Roadway
Scale 1/2" = 1'
Scale 1" = 1'
Undertrain thru this section is a modification of Item 65
Undertrain thru this section is a modification of Item 65
-0.203%
-3.934%
+0.073%
573+00 - 580+00
12" Sub-base of Gravel
580+00 - 582+15
18" Sub-base of Gravel
582+15 - 585+00
12" Sub-base of Gravel
585+00 - 587+00
18" Sub-base of gravel
B.M. 129 Spike in Root 12" Poplar 43' Lt. Sta. 578+13 Elev. 379.03
(LANDSCAPING II)
SERIES F No 160-C
SHEET 26 OF 34
58