108-C 1939 ~~28~~ ~~43~~ 27 34

(LANDSCAPING II)

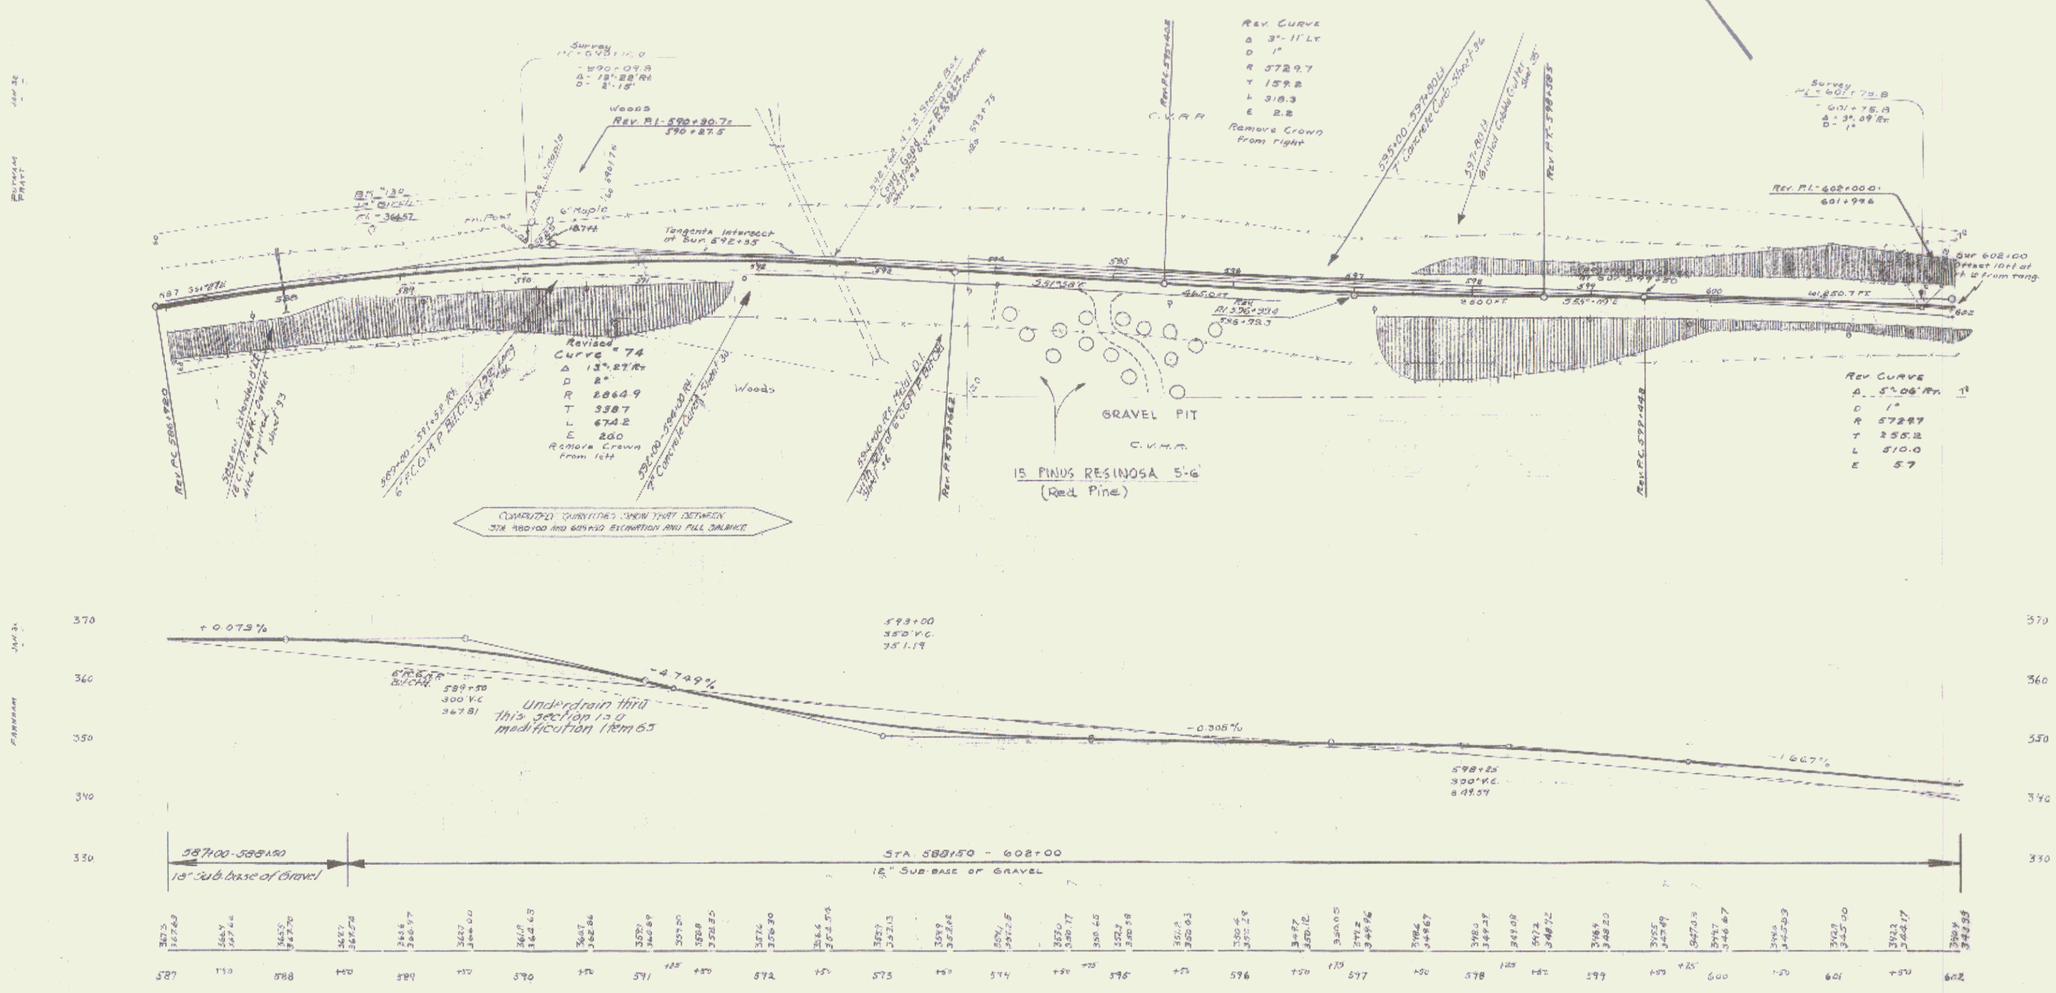

B.M. 130 Spike in root of 12" Birch 36' Lt. Sta 588+78 Elev 364.07

(LANDSCAPING II)
SERIES F. No 108-C
SHEET ~~28~~ OF ~~47~~ 34
27